



APPENDIX A – STREAM RESTORATION PLAN TAFT AVENUE APPROVED PLAN DSP2007-00018



Wood Environment & Infrastructure Solutions, Inc.
Strawberry Run Downstream Forensic Investigation

STREAM RESTORATION PLAN

TAFT AVENUE

CITY OF ALEXANDRIA, VIRGINIA

CLIENT

CALVERT DEVELOPMENT
 12656-C LAKE RIDGE DRIVE
 LAKE RIDGE, VIRGINIA 22192
 (703) 643-5001
 (703) 643-2863 FAX
 ATTN: MR. DAVE FARMER

ENGINEER

WILLIAMSBURG ENVIRONMENTAL GROUP, INC.
 5209 CENTER STREET
 WILLIAMSBURG, VIRGINIA 23188
 (757) 220-6869
 (757) 229-4507 FAX
 ATTN: JEFFREY T. HANCOCK, P.E.


TOPOGRAPHY

BASE MAPPING PROVIDED BY
 LAND DESIGN CONSULTANTS

BENCHMARK

NORTHING - 6981107.54
 EASTING - 11883174.60
 ELEVATION - 79.71 MSL
 DESCRIPTION - BENCHMARK IS LOCATED AT UPSTREAM
 CULVERT INVERT UNDER DUKE STREET

THE NORTHING AND EASTING PROVIDED ARE BASED OFF OF
 THE COORDINATED PLANE NAD STATE PLANE NORTH 1983.

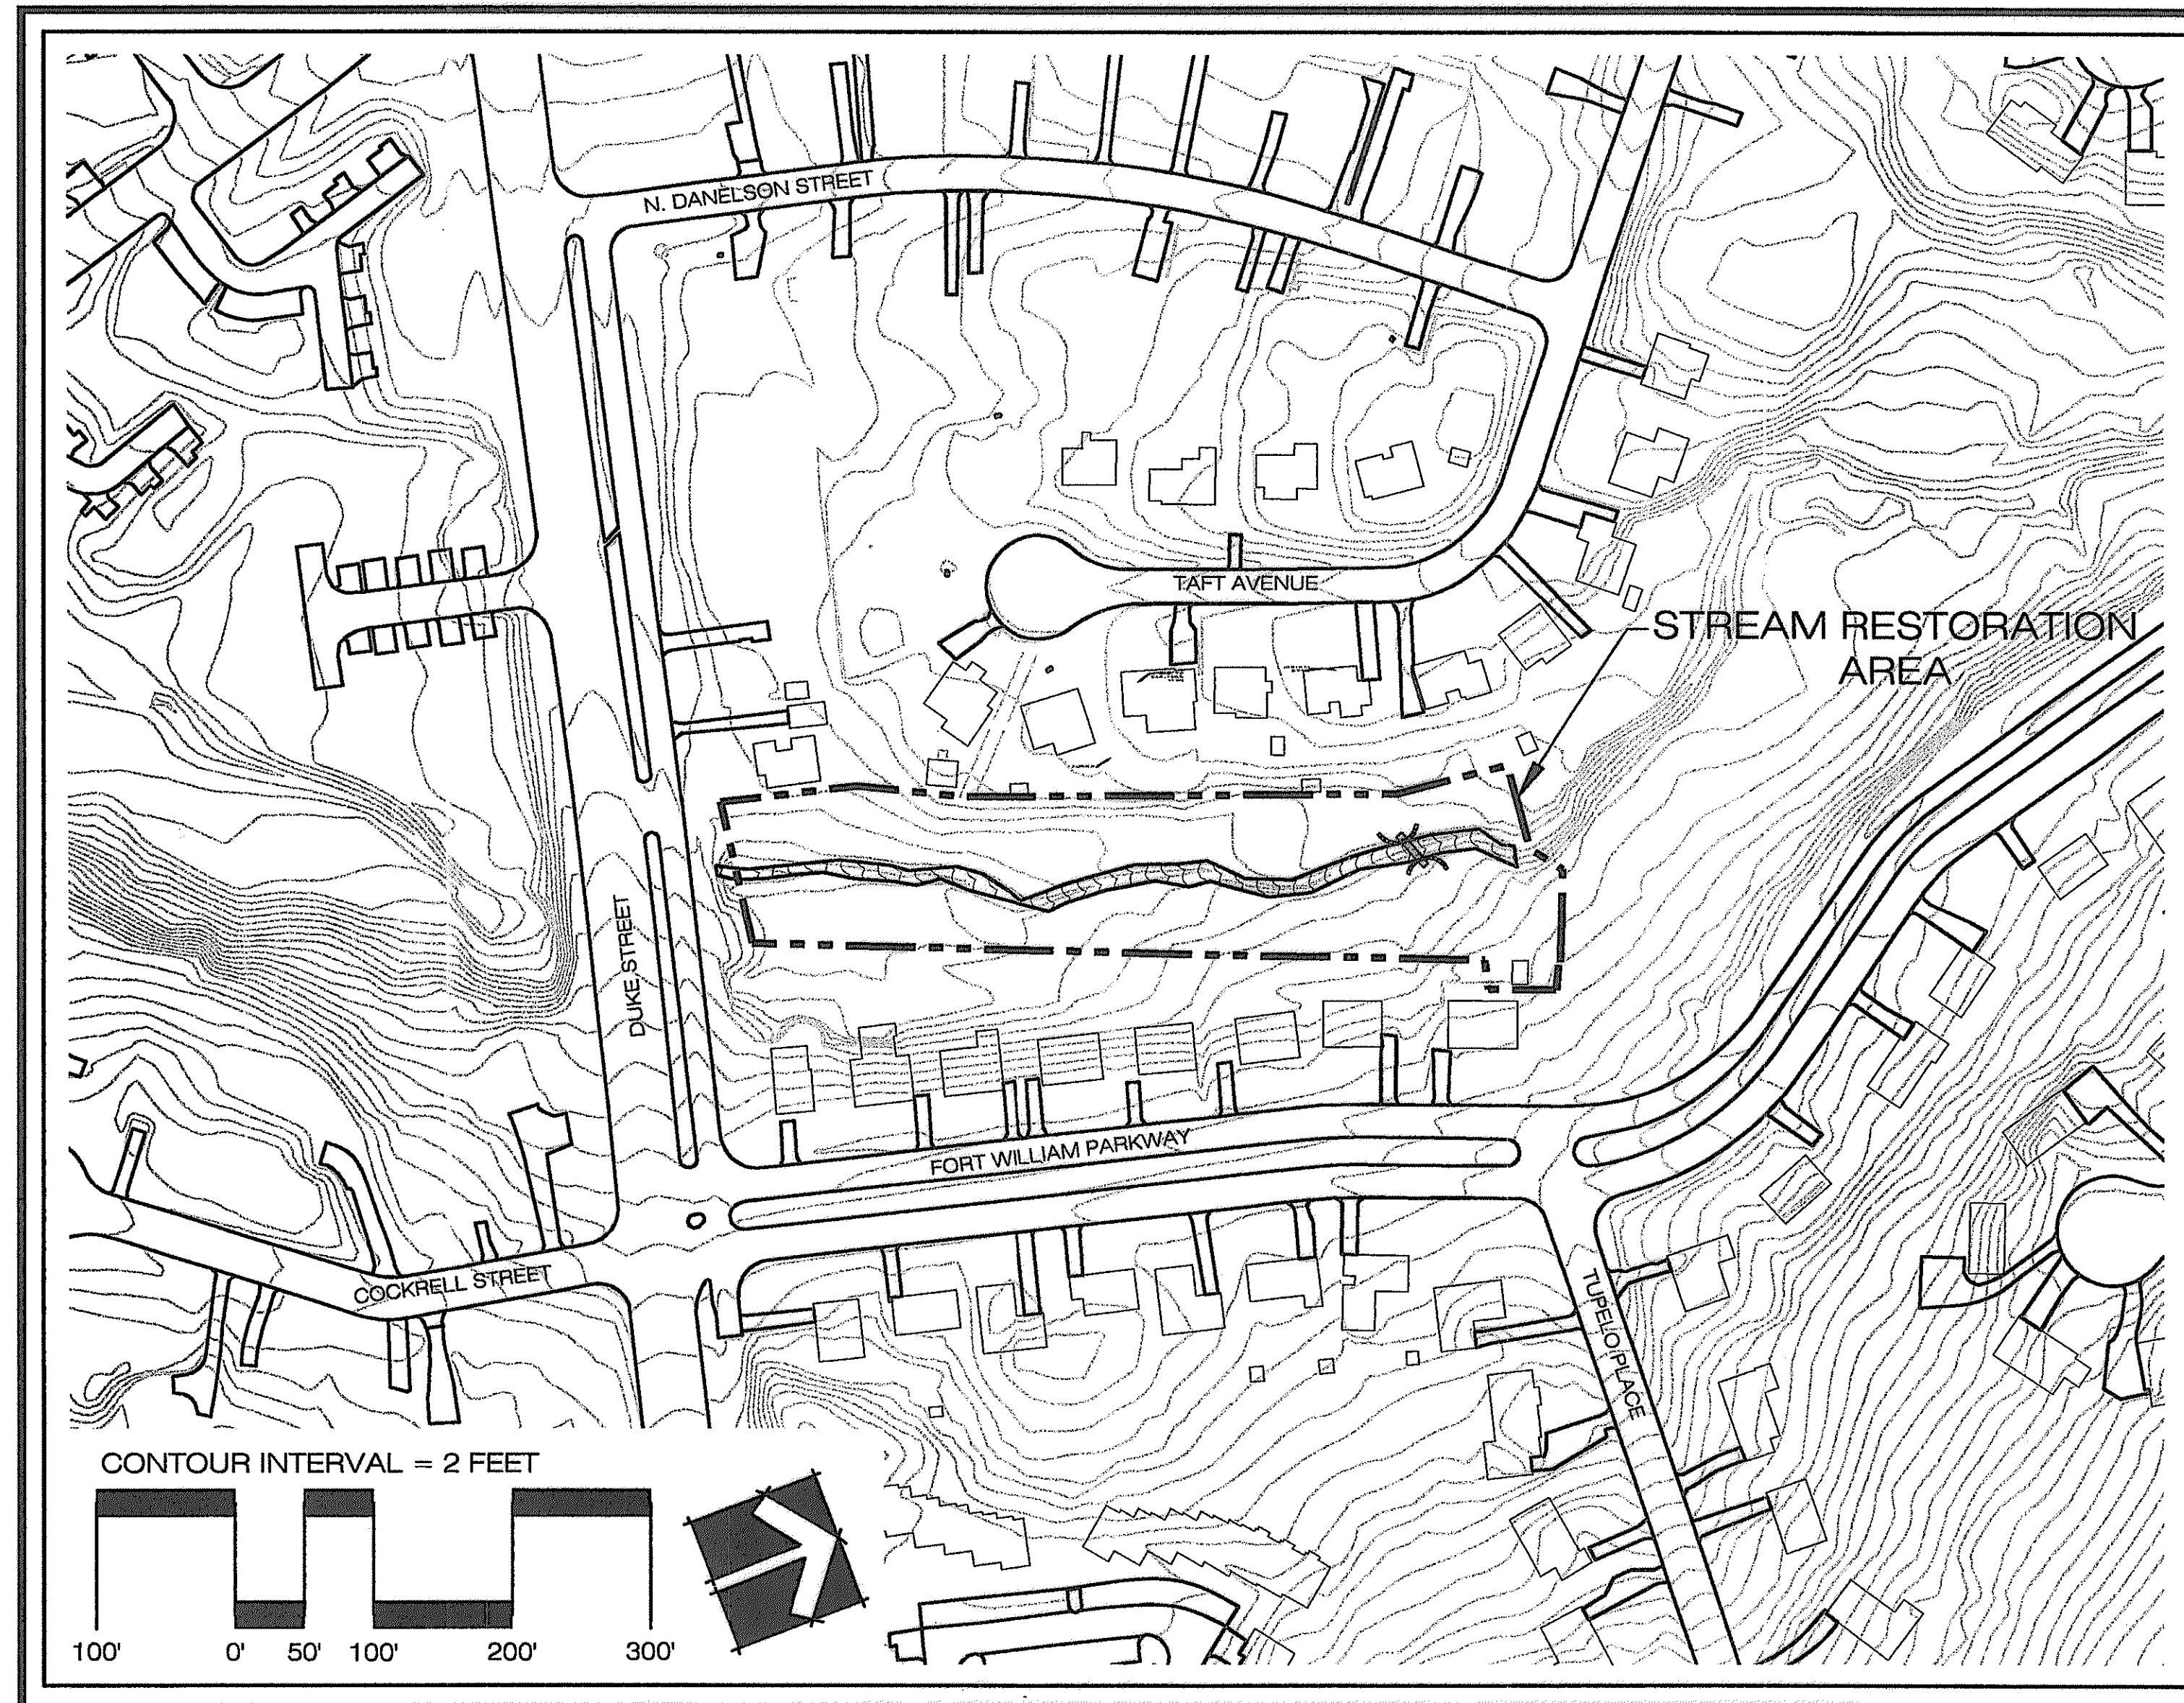

PROJECT NARRATIVE:

THE CONSTRUCTION PLANS PROPOSE APPROXIMATELY 600 LINEAR FEET OF STREAM RESTORATION AS COMPENSATION FOR THE PROPOSED PERMANENT RESOURCE PROTECTION AREA (RPA) BUFFER AND STORMWATER QUALITY IMPACTS ASSOCIATED WITH THE TAFT AVENUE DEVELOPMENT.

STRAWBERRY RUN, A TRIBUTARY TO CAMERON RUN, IS LOCATED BETWEEN TAFT AVENUE AND FORT WILLIAMS PARKWAY, PERPENDICULAR TO DUKE STREET IN THE CITY OF ALEXANDRIA. THE AREA OF STRAWBERRY RUN AT THE PROJECT LOCATION IS ALSO IDENTIFIED AS FORT WILLIAMS PARK. STRAWBERRY RUN DRAINS 138 ACRES OF A PRIMARILY RESIDENTIAL WATERSHED BEFORE ENTERING A 88" CULVERT UNDER DUKE STREET.


THE UPSTREAM PORTION OF THE CHANNEL IS SEVERELY INCISED, EXHIBITING VERTICAL BANKS AND MINIMAL CONNECTIVITY TO THE FLOODPLAIN. ALTHOUGH THE DOWNSTREAM PORTION OF THE STREAM IS LESS INCISED, BANK EROSION AND SCOUR CONTINUE TO DEMONSTRATE THE OVERALL INSTABILITY OF THE CHANNEL. BANK EROSION HAS UNDERMINED THE INTEGRITY OF AN EXISTING STORMWATER INFLOW PIPE, IN ADDITION TO A WOODEN FOOT BRIDGE. CONCRETE DEBRIS WITHIN THE CHANNEL DISRUPTS NATURAL FLOW DYNAMICS. THE EXISTING RIPARIAN CORRIDOR IS PRIMARILY COMPRISED OF MAINTAINED GRASS AND SCATTERED MATURE HARDWOODS, WITH OCCASIONAL NON-NATIVE SPECIES. MINIMAL HERBACEOUS VEGETATION ON THE STREAM BANKS CONTRIBUTES TO FURTHER DEGRADATION WITHIN THE CHANNEL.

THE PROPOSED RESTORATION COMBINES IN-STREAM STRUCTURES WITH BANK STABILIZATION TECHNIQUES. IN-STREAM STRUCTURES WILL ALSO BE UTILIZED TO DIVERT EROSION FLOWS FROM OUTER BENDS INTO THE CENTER OF THE CHANNEL AND CREATE IN-STREAM HABITAT. ROCK TOE PROTECTION SHALL PROVIDE ADDITIONAL PROTECTION IN HIGH STRESS AREAS ALONG THE STREAM CHANNEL. THE EXISTING CONCRETE DEBRIS SHALL BE REMOVED TO RESTORE NATURAL FLOW DYNAMICS. VEGETATED BANKFULL BENCHES WILL INCREASE CONNECTIVITY TO THE FLOODPLAIN AND PROVIDE CHANNEL CAPACITY.


AS PROPOSED MITIGATION FOR RPA IMPACTS, THE RESTORATION PLAN INCORPORATES 1.3 ACRES OF RIPARIAN CORRIDOR RESTORATION. NON-NATIVE VEGETATION (E.G., BAMBOO) SHALL BE MANAGED AND NATIVE VEGETATION SHALL BE USED TO RESTORE THE RIPARIAN BUFFER.

SHEET INDEX:

1. COVER
2. EXISTING CONDITIONS
3. MASTER PLAN
4. HYDROLOGIC AND HYDRAULIC SUMMARY
5. PLAN AND PROFILE: RESTORATION AREA 1
6. PLAN AND PROFILE: RESTORATION AREA 2
7. PLAN AND PROFILE: RESTORATION AREA 3
8. STREAM RESTORATION NOTES AND DETAILS
9. EROSION AND SEDIMENT CONTROL PLAN
10. EROSION AND SEDIMENT CONTROL NOTES AND DETAILS
11. PLANTING NOTES AND DETAILS
12. CITY OF ALEXANDRIA NOTES AND DETAILS

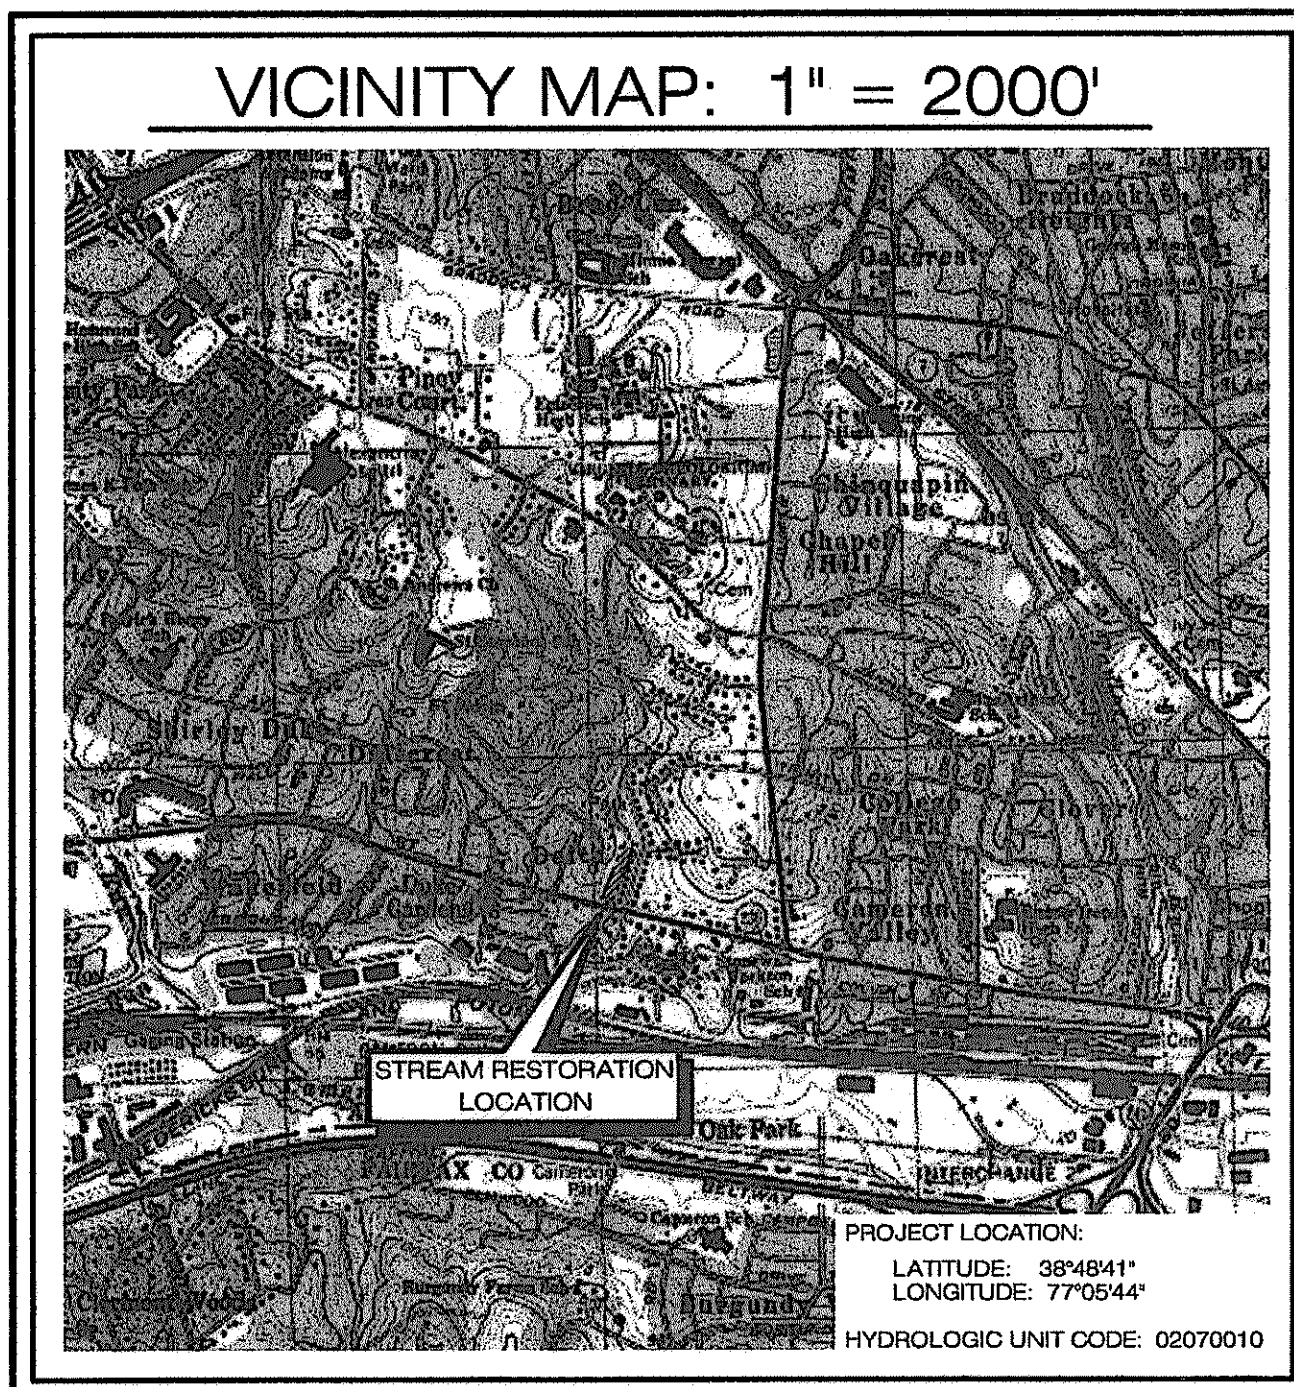

U.S. ARMY CORPS OF ENGINEERS PERMIT # 05 - R1109

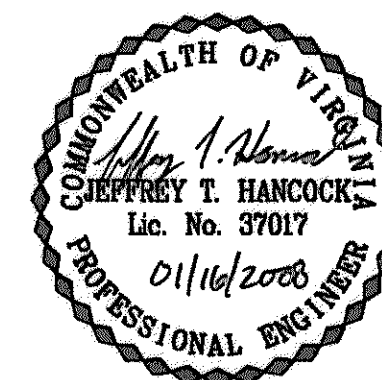

DATE: 12/27/05
 FIRST SUBMITTAL

DATE	REVISIONS:	DATE	REVISIONS:
5/28/06	SECOND SUBMITTAL	10/1/07	PER 9/17/07 REVIEW LETTER - CITY STAFF COMMENTS
12/1/06	THIRD SUBMITTAL - ADJUSTED PER COUNTY COMMENTS	01/15/08	PER CITY COMMENT
04/1/07	PER 02/05/07 REVIEW LETTER - CITY STAFF COMMENTS		
01/1/07	PER 6/27/07 REVIEW LETTER - CITY STAFF COMMENTS		

APPROVED
 SPECIAL USE PERMIT NO. DSP 2007 - 0018
 DEPARTMENT OF PLANNING & ZONING

Jay Wagon 2-4-08
 DIRECTOR DATE

Joel 2/1/08
 DIRECTOR DATE

Eric K. Wagon 2/1/08
 CHAIRMAN, PLANNING COMMISSION DATE

DATE RECORDED _____
 INSTRUMENT NO. DEED BOOK NO. PAGE NO.

Released
 1/16/08
 SMF

WILLIAMSBURG ENVIRONMENTAL GROUP, INC.
 Environmental Consultants



5209 Center Street
 Williamsburg, Virginia 23188
 (757) 220-6869

13921 Park Center Road
 Suite 160
 Herndon, Virginia 20171
 (703) 437-3096

7501 Boulders View Drive
 Suite 205
 Richmond, Virginia 23225
 (804) 267-3474

5705 Salem Run Blvd.
 Suite 105
 Fredericksburg, Virginia 22407
 (540) 785-5544

EXISTING CONDITIONS

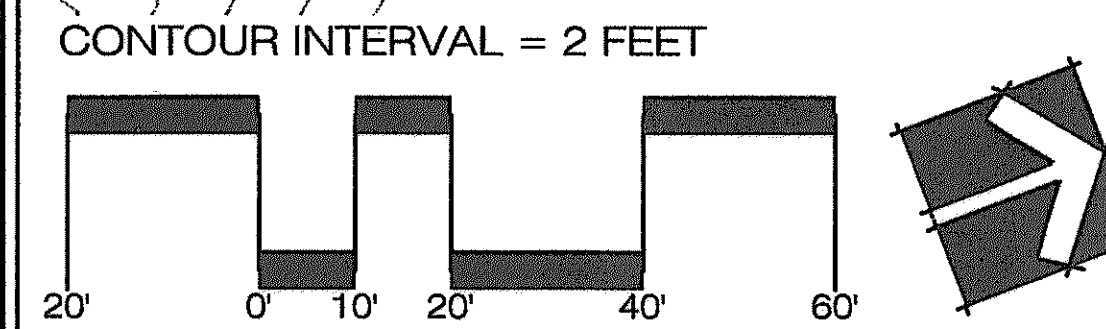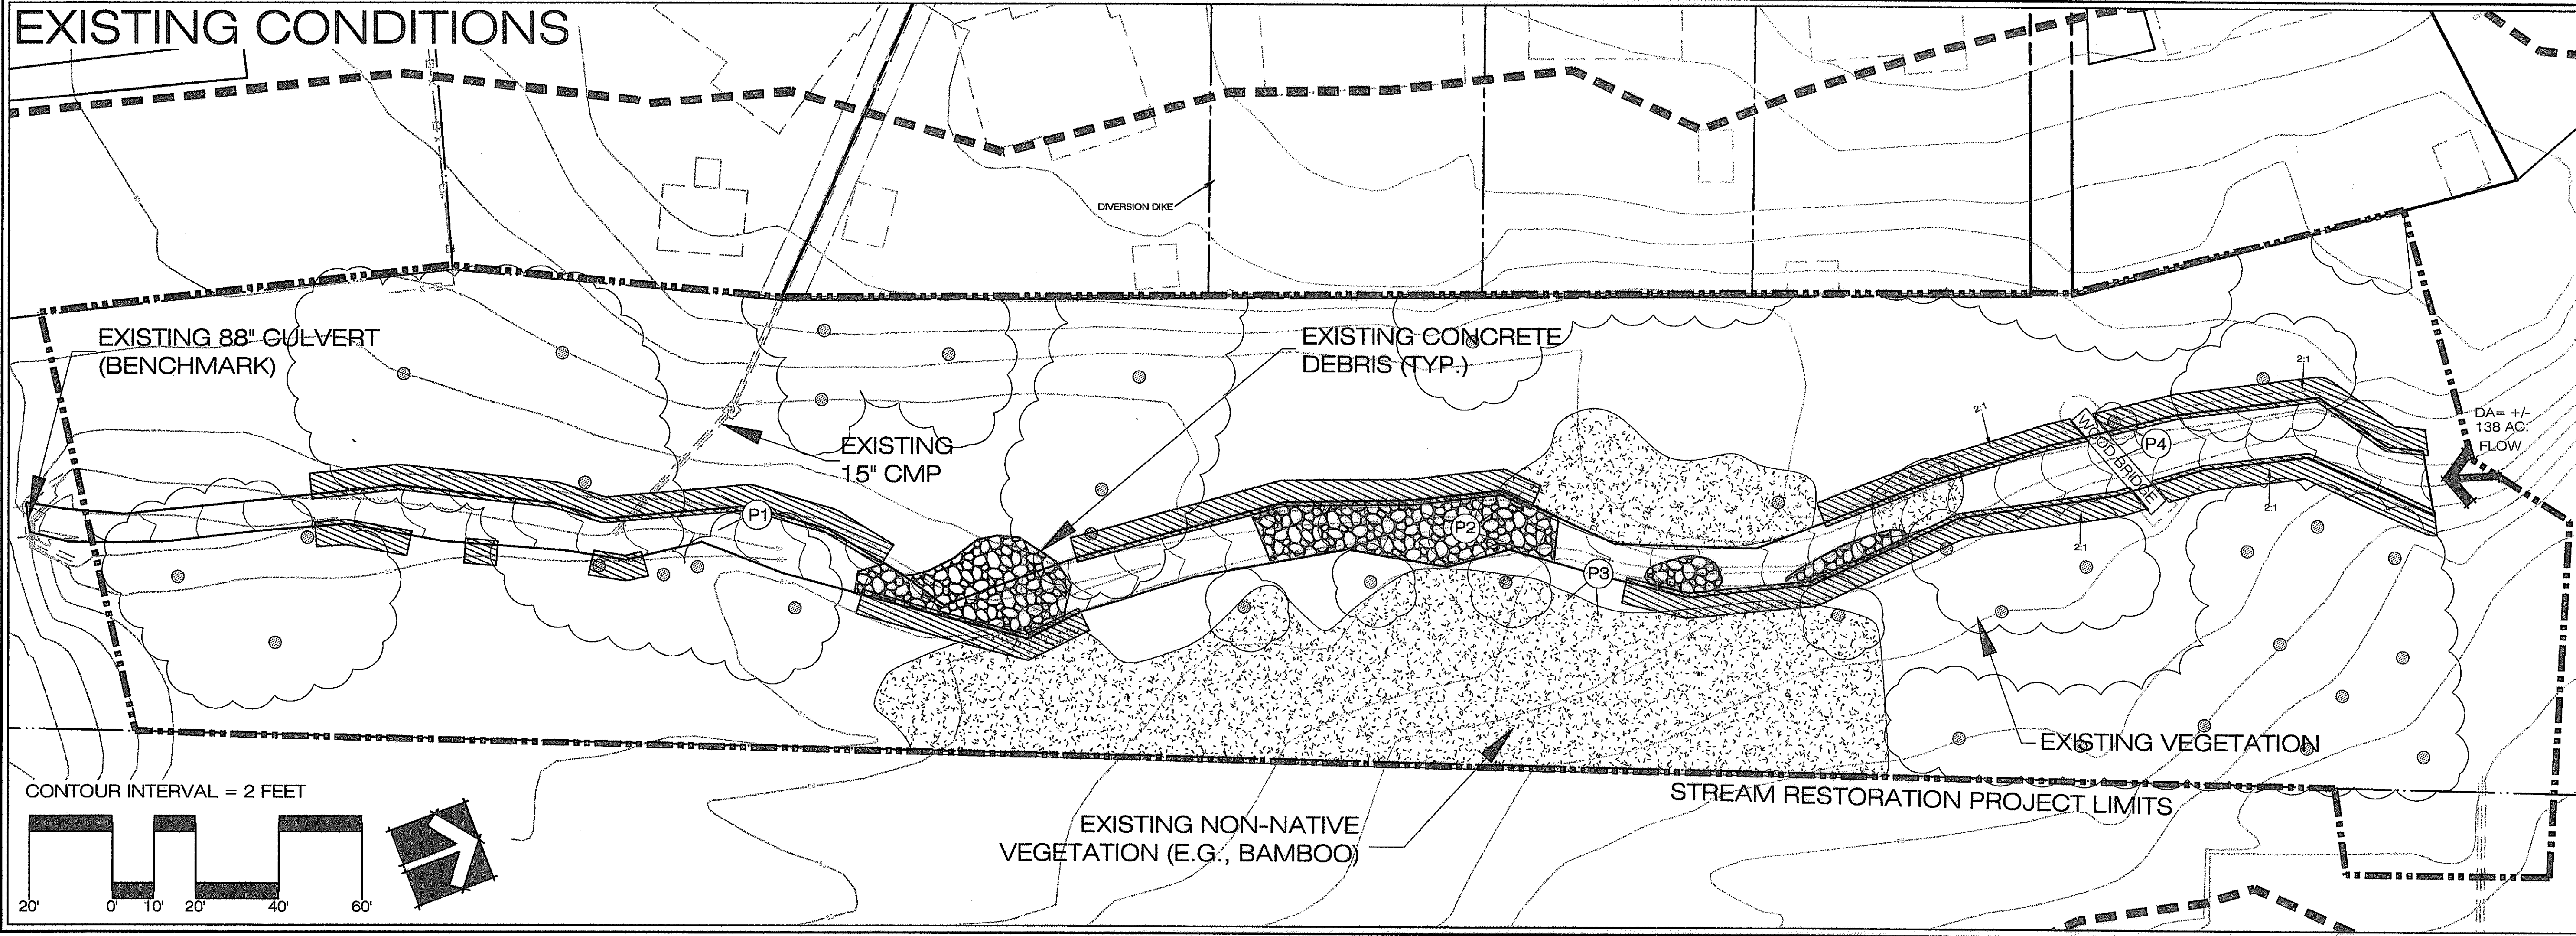

13001 Park Center Road
Harrison, Virginia 20171
703-437-3008

2700 Lakeside View Drive
Richmond, Virginia 23225
804-770-7444

WILLIAMSBURG ENVIRONMENTAL SERVICES, INC.
Environmental Consultants

EXISTING CONDITIONS
TAFT AVENUE
CITY OF ALEXANDRIA, VIRGINIA

COMMONWEALTH OF VIRGINIA
JEREMY T. HANCOCK
Lic. No. 37017
01/16/2008
PROFESSIONAL ENGINEER

REVISIONS:
DATE: 01/27/07
BY: [Signature] FOR: [Signature] CITY REVIEW LETTER

DRAWN BY: EBG/MAM
DATE: 12/27/05

DESIGNED BY: TWC/EGM
CHECKED BY: TWC/JTH

SHEET: **2**
JOB#: 2256





APPROVED
SPECIAL USE PERMIT NO. 2007-008
DEPARTMENT OF PLANNING & ZONING
DATE: 2/4/08

DEPARTMENT OF TRANSPORTATION & ENVIRONMENTAL SERVICES
SITE PLAN NO. 2007-0018
DATE: 2/1/08

CHAIRMAN, PLANNING COMMISSION
DATE: 2/4/08

EXISTING CONDITIONS SUMMARY


STRAWBERRY RUN DISPLAYS VARIOUS FORMS OF DEGRADATION AND CHANNEL INSTABILITY. PORTIONS OF THE CHANNEL ARE SEVERELY INCISED, EXHIBITING VERTICAL BANKS AND MINIMAL CONNECTIVITY TO THE FLOODPLAIN. THE BANKS LACK VEGETATIVE PROTECTION AND, DUE TO AN INEFFECTIVE ROOTING DEPTH, DEMONSTRATE SIGNS OF INSTABILITY. BANK EROSION HAS UNDERMINED THE INTEGRITY OF AN EXISTING 15' CMP, CONTRIBUTING TO DOWNSTREAM CHANNEL INSTABILITY. THE EXISTING WOODEN FOOT BRIDGE CROSSES A SEVERELY ERODED PORTION OF THE STREAM CHANNEL. CONCRETE DEBRIS ALONG THE STREAM BED PROHIBITS NATURAL FLOW DYNAMICS AND CONTRIBUTES TO SEDIMENT DEPOSITION. THE EXISTING RIPARIAN CORRIDOR PROVIDES LIMITED WILDLIFE HABITAT AND IS COMPRISED OF MAINTAINED GRASSES AND SCATTERED MATURE HARDWOODS. PORTIONS OF THE BUFFER ARE DOMINATED BY NON-NATIVE SPECIES, INCLUDING BAMBOO (SEE PHOTO 3), AND INVASIVE SPECIES, INCLUDING VIRGINIA CREEPER.

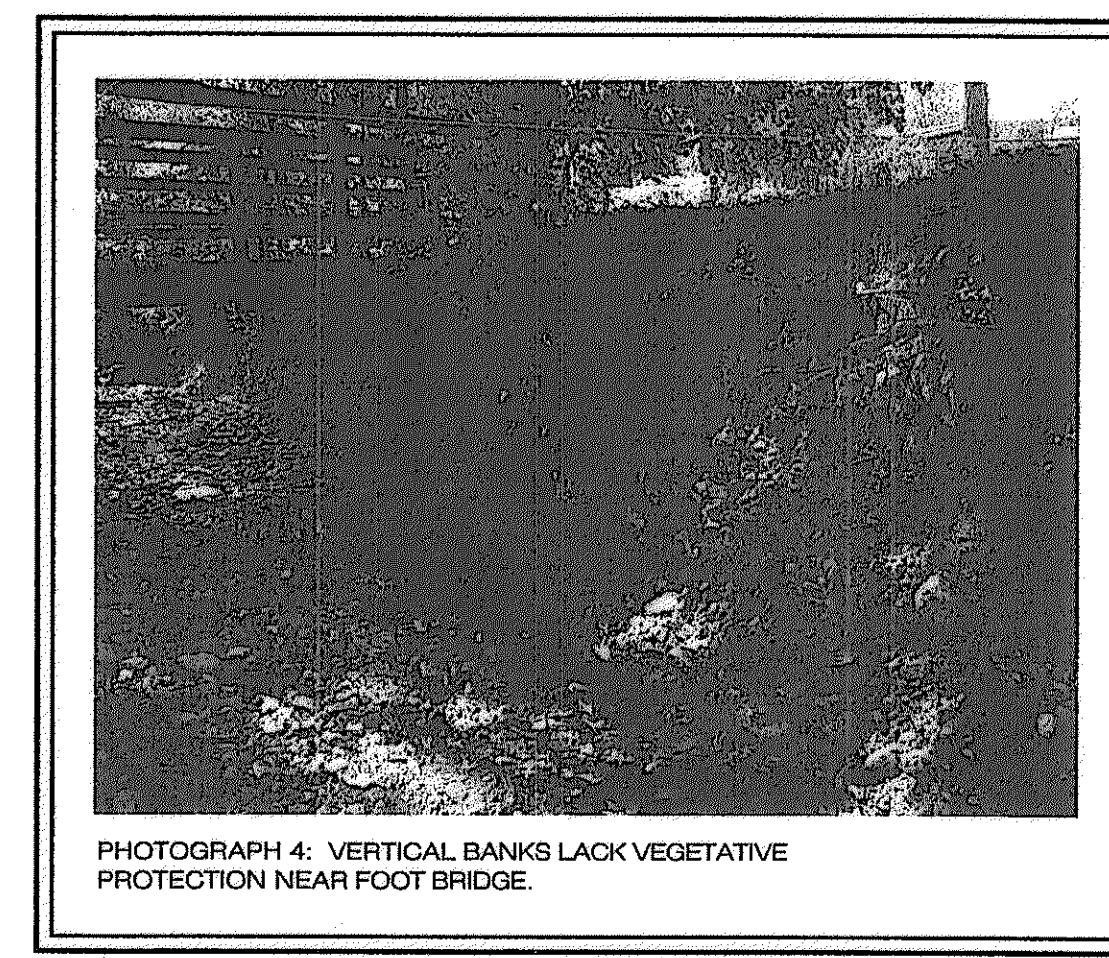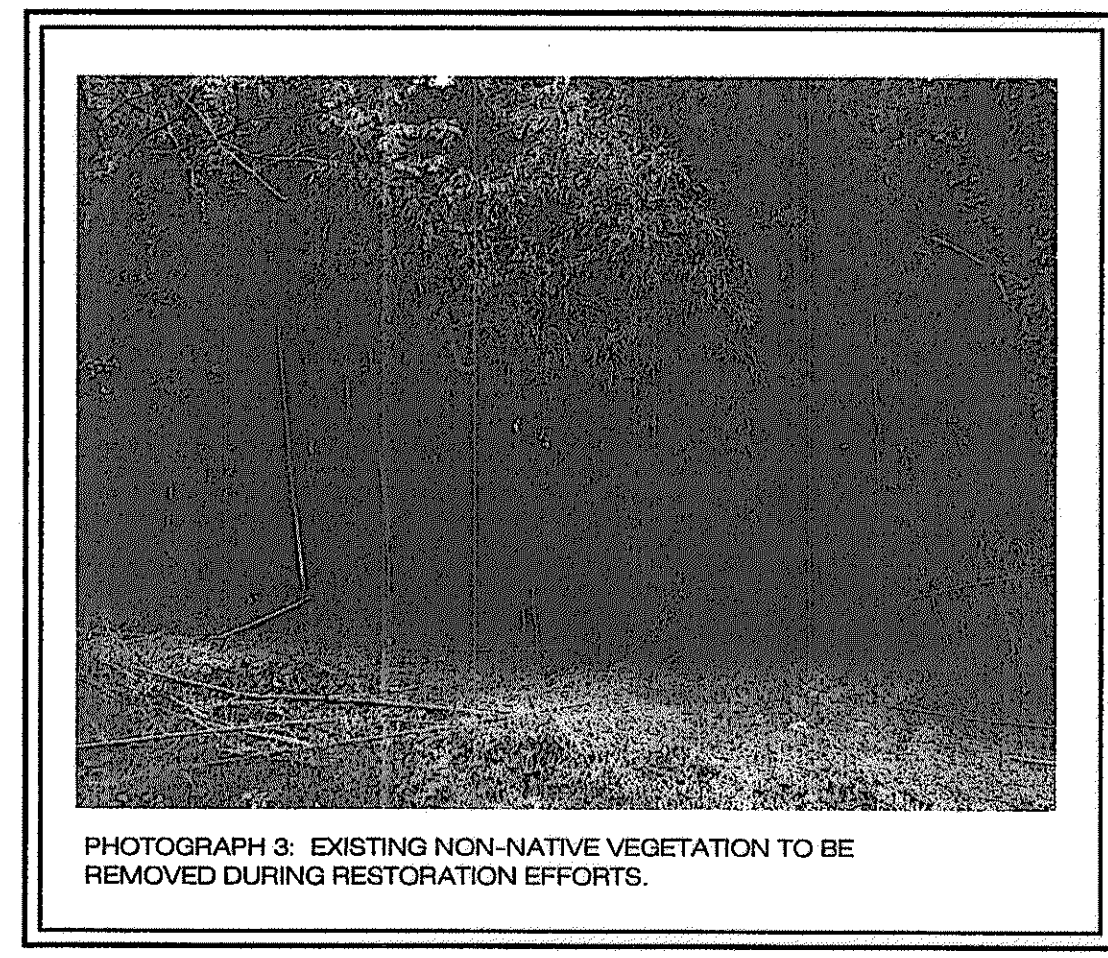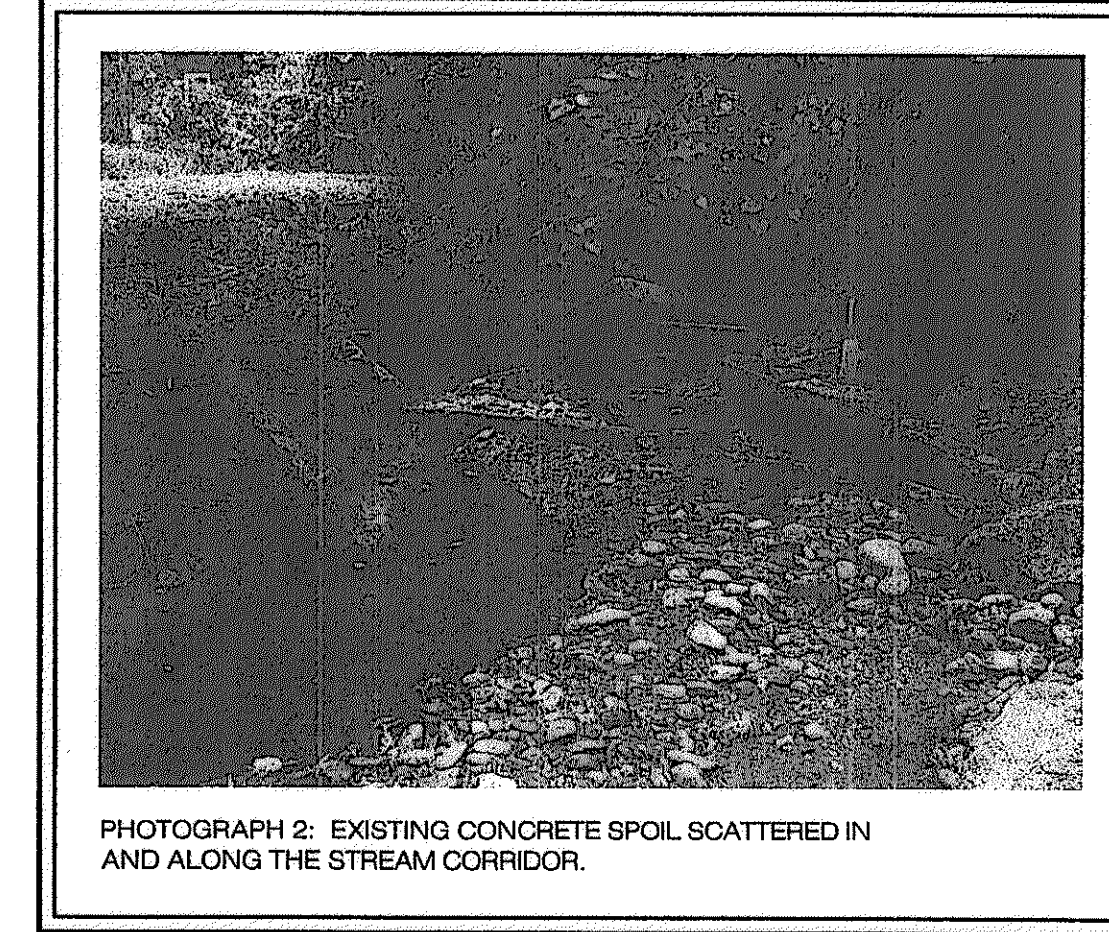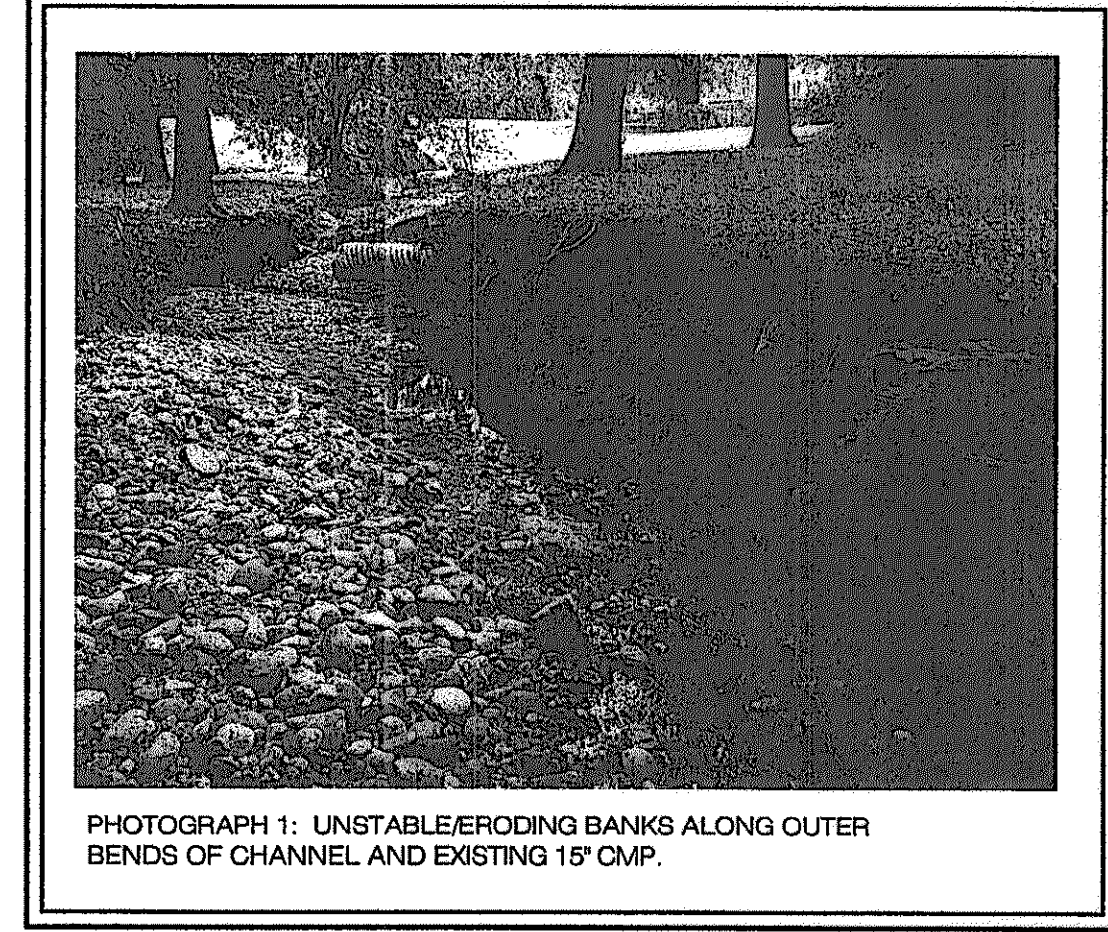

- LEGEND:**
- PROJECT LIMITS
 - APPROXIMATE STREAM CHANNEL LIMITS
 - EXISTING BUILDINGS
 - EXISTING CONTOURS
 - RESOURCE PROTECTION AREA LIMITS
 - EXISTING TREE AND DRIP LINE
 - EXISTING BANK EROSION
 - EXISTING NON-NATIVE VEGETATION
 - EXISTING CONCRETE DEBRIS
 - PHOTOGRAPH LOCATION

V:\2200s\2256 - Taft\Stream Restoration\Construction Plans 10-10-07.dwg

PROPOSED CONDITIONS

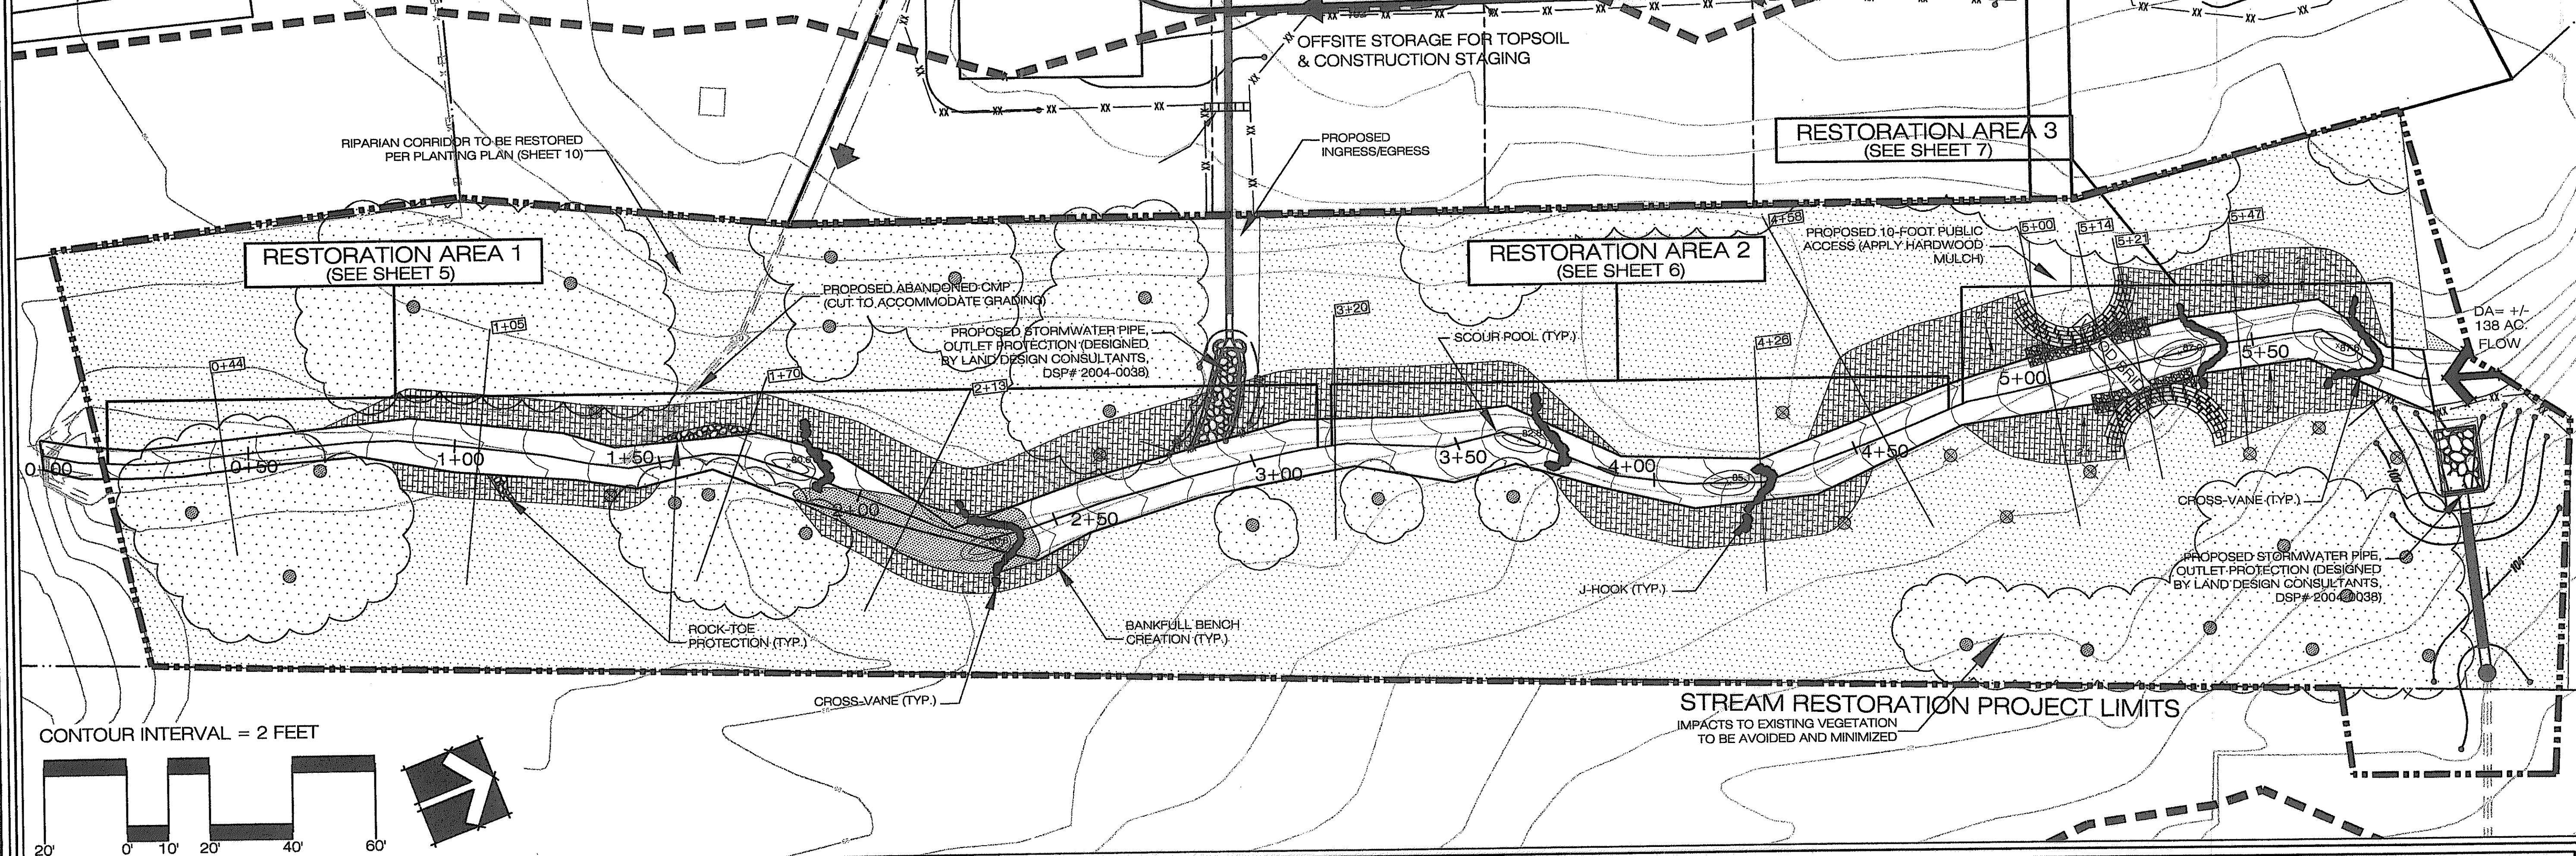

13821 Park Center Road
Suite 100
Williamsburg, Virginia 23188
(757) 220-0888
FAX: (757) 220-0889

7501 Boulders View Drive
Williamsburg, Virginia 23125
(800) 287-3474

Environmental Consultants
WEG
WILLIAMSBURG ENVIRONMENTAL GROUP, INC.

MASTER PLAN
Taft Avenue
CITY OF ALEXANDRIA, VIRGINIA

COMMONWEALTH OF VIRGINIA
Jeffrey T. Hancock
Lic. No. 37017
01/14/2008
PROFESSIONAL ENGINEER

REVISIONS:

DATE	DESCRIPTION
04/22/08	REVISED BUFFER VEGETATION TO REFLECT BARRIERS
04/22/08	REVISED EXISTING TO STORMWATER PIPE AND OUTLET PROTECTION
12/18/07	UPDATED LEGISLATIONAL PEOPLE PROTECTION
12/18/07	REVISED BRIDGE EXTENDED
04/22/07	BRIDGE DELAYED
04/22/07	REVISED CITY REVISION LETTER
03/16/07	REVISED CITY REVISION LETTER
11/26/07	PER LEGISLATIVE COMMENT
07/16/07	REVISED CITY COMMENT


DRAWN BY: EBG/MAM
DESIGNED BY: TWC/EBG/NJL
DATE: 12/27/05
CHECKED BY: TWC/JTH

SHEET: **3**
JOB#: 2256

APPROVED
SPECIAL USE PERMIT NO. 2007-0018
DEPARTMENT OF PLANNING & ZONING
2-4-08
DATE
DIRECTOR
DEPARTMENT OF TRANSPORTATION
& ENVIRONMENTAL SERVICES
SITE PLAN NO. 2007-0018
DATE
DIRECTOR
CHAIRMAN, PLANNING COMMISSION
DATE
DATE RECORDED

LEGEND:

	PROJECT LIMITS		PROPOSED CROSS-VANE		UN-SURVEYED CROSS-SECTION
	APPROXIMATE STREAM CHANNEL LIMITS		PROPOSED J-HOOK		SURVEYED CROSS-SECTION
	RESOURCE PROTECTION AREA LIMITS		PROPOSED SCOUR POOL		PROPOSED ROCK STABILIZATION
	EXISTING CONTOURS		PROPOSED BUFFER RESTORATION AREA		PROPOSED OUTLET PROTECTION
	EXISTING TREES (TO BE PROTECTED)		PROPOSED BANKFULL BENCH AND BANK GRADING		PROPOSED CHANNEL SHAPING
	EXISTING TREES (TO BE REMOVED)		PROPOSED GRADING FOR STORMWATER OUTFALL (BY OTHERS)		PROPOSED BRIDGE STABILIZATION

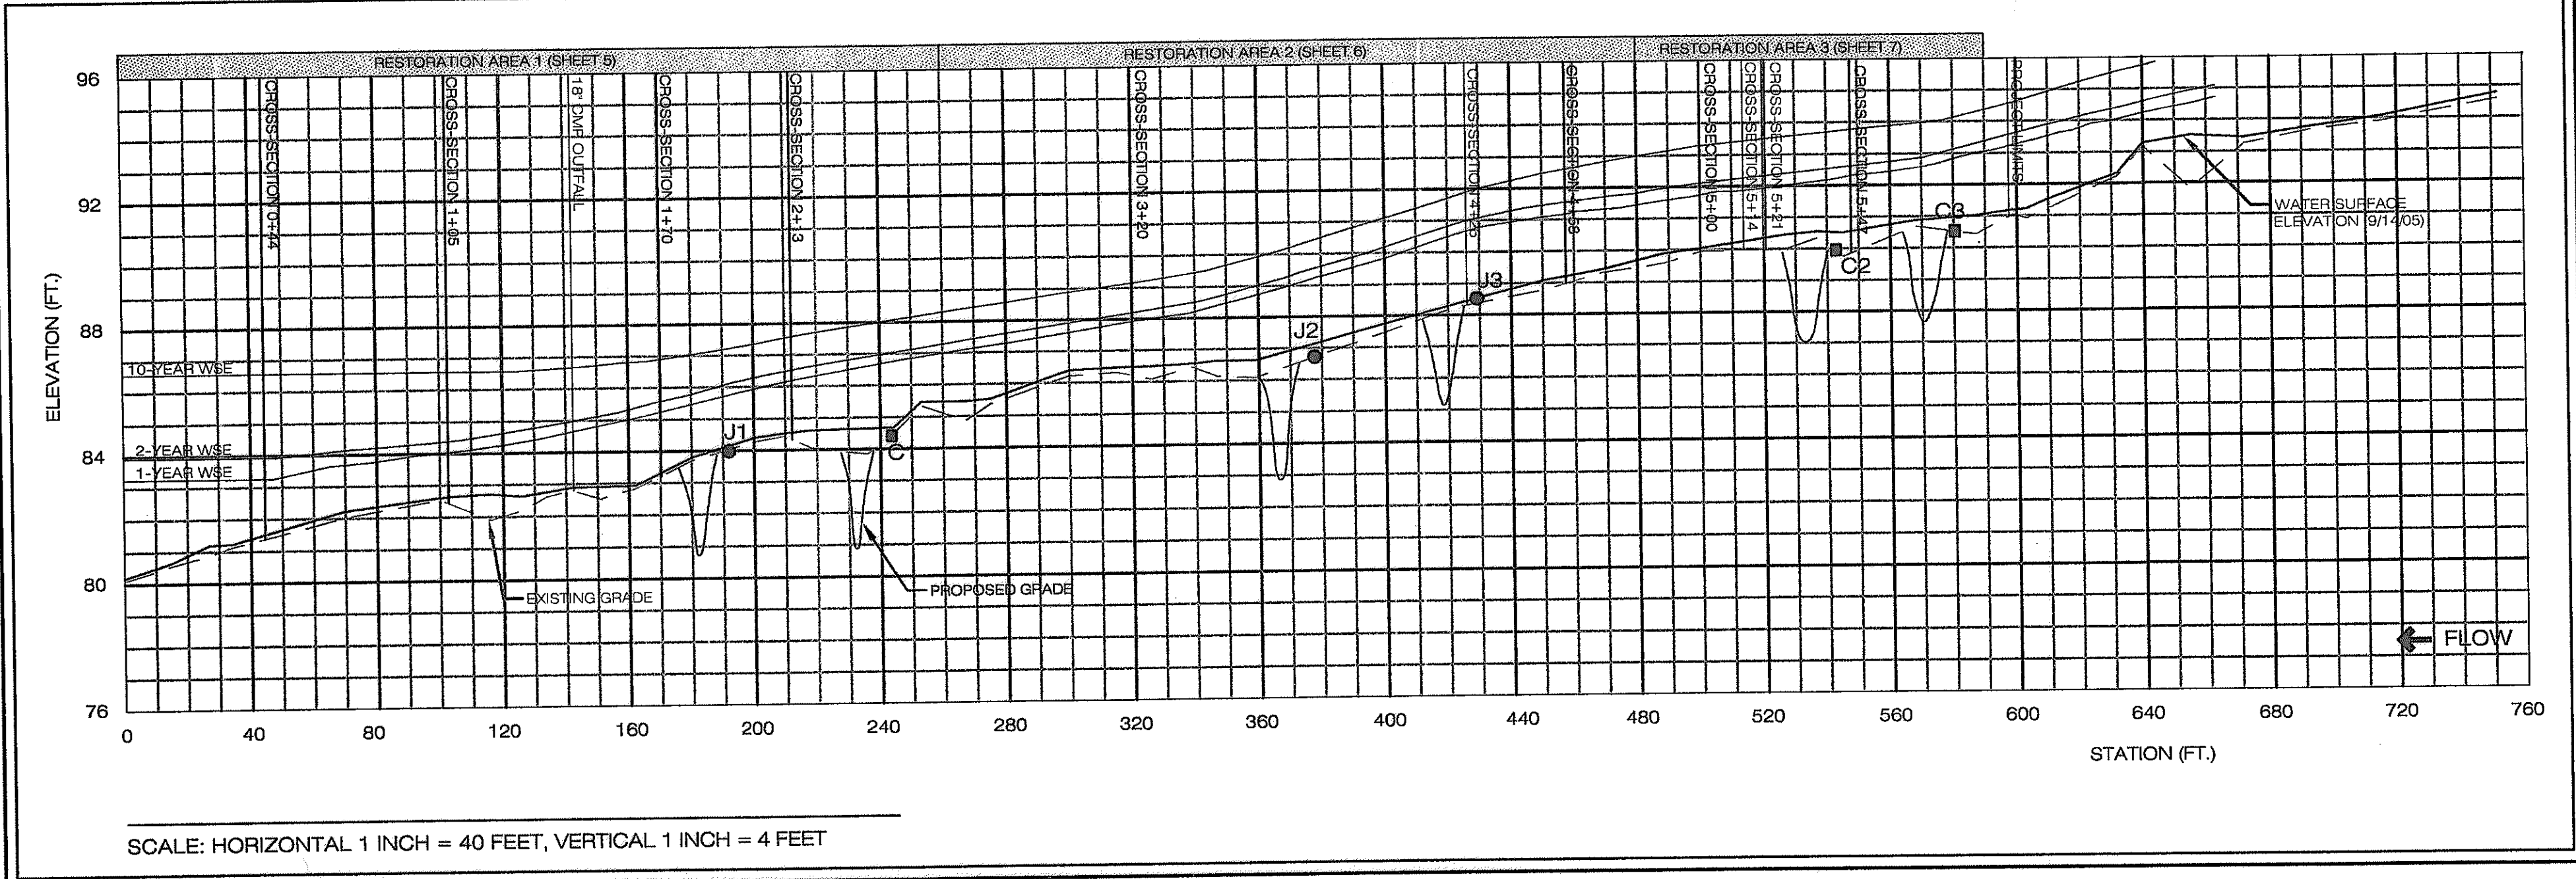

PROPOSED RESTORATION SUMMARY

THE PROPOSED RESTORATION WITHIN STRAWBERRY RUN COMBINES IN-STREAM STRUCTURES WITH CHANNEL SHAPING AND BANK STABILIZATION TECHNIQUES. EXISTING CONCRETE DEBRIS WILL BE REMOVED FROM THE STREAM BED AND BANKS IN ORDER TO RESTORE NATURAL FLOW DYNAMICS. IN-STREAM STRUCTURES, INCLUDING J-HOOKS, AND CROSS-VANES, SHALL PROVIDE GRADE CONTROL AND DIVERT EROSION FLOWS FROM OUTER BANKS. OUTLET PROTECTION AT THE PROPOSED 18" CMP WILL ATTENUATE STORMWATER FLOWS AND PREVENT FURTHER DEGRADATION OF THE BENDS. ROCK-TOE PROTECTION WILL PROTECT THE CONFLUENCE OF THE CHANNEL AND AN EXISTING DRAINAGE SWALE, IN ADDITION TO STABILIZING HIGH STRESS AREAS. BANKFULL BENCHES SHALL PROVIDE SLOPE STABILIZATION IN EXISTING ERODED AREAS, WHERE PRACTICABLE, IN ADDITION TO ENHANCING CONNECTIVITY TO THE FLOODPLAIN. THE EXISTING WOOD FOOT BRIDGE WILL BE RETAINED AND ENHANCED WITH A PROPOSED CONCRETE FOUNDATION. PROPOSED ROCK STABILIZATION, ROCK-TOE PROTECTION, AND CEMENT GROUTED RIPRAP WILL PROTECT THE EXISTING VERTICAL BANKS NEAR THE BRIDGE DURING HIGH FLOW EVENTS.

THE RESTORATION PLAN ALSO INCORPORATES APPROXIMATELY 1.3 ACRES OF RIPARIAN CORRIDOR RESTORATION. NON-NATIVE VEGETATION (E.G., BAMBOO) SHALL BE MANAGED AND NATIVE VEGETATION SHALL BE USED TO RESTORE THE RIPARIAN BUFFER. IMPACTS TO EXISTING MATURE TREES SHALL BE AVOIDED AND MINIMIZED. TREES, SHRUBS, LIVE-STAKES, AND A HERBACEOUS SEED MIX SHALL PROVIDE AN EFFECTIVE ROOTING DEPTH TO STABILIZE THE GRADED BANKS.

PROPOSED DESIGN GUIDELINES

THE PROPOSED DESIGN SHALL MIMIC, TO THE CLOSEST EXTENT PRACTICABLE, THE "C" CHANNEL PARAMETERS OUTLINED BY THE ROSGEN CLASSIFICATION METHOD. THE PARAMETERS INCLUDE ENTRENCHMENT RATIO, WIDTH/DEPTH RATIO, SINUOSITY, AND SLOPE. AN AVERAGE OF EXISTING CONDITIONS AND PROPOSED CONDITIONS IS PRESENTED BELOW.

	ENTRENCHMENT RATIO	WIDTH/DEPTH RATIO	SINUOSITY	SLOPE
"C" CHANNEL GUIDELINES	>2.2	>12	>1.2	<.02
EXISTING CONDITION	1.5 - >2.2	10.6"	1.03	.02
PROPOSED CONDITION	1.9 - >2.2	16.5"	1.03	.02

* WIDTH-DEPTH RATIO CALCULATED AS TOP WIDTH DIVIDED BY AVERAGE DEPTH

J1 J-HOOK (1-3)
C1 CROSS-VANE (1-3)

WSE WATER SURFACE ELEVATION


V:\2200s\2256 - TaftStream Restoration\Construction Plans 10-10-07.dwg



TAFT AVENUE: DRAINAGE AREA
SCALE: 1 INCH = 500 FEET

TAFT AVENUE: HYDROLOGIC AND HYDRAULIC SUMMARY
SCALE: 1 INCH = 50 FEET

Station	Profile	Plan	Q Total (cfs)	W.S. Elev (ft)	Vel Chnl (ft/s)	Shear Chnl (lb/ft ²)	Power Chnl (ft ³ /s)	Flow Area (ft ²)	Top Width (ft)	Prods # Cnt
547.00	1-YR EXISTING	110.00	92.49	8.31	1.75	0.27	30.72	11.69	0.70	
547.00	1-YR PROPOSED	110.00	92.22	8.08	1.63	0.27	29.26	10.93	0.75	
547.00	2-YR EXISTING	150.00	92.85	8.96	2.11	0.46	38.78	15.59	0.73	
547.00	2-YR PROPOSED	150.00	92.60	8.34	1.89	0.35	30.48	11.53	0.70	
521.00	1-YR EXISTING	110.00	92.27	8.99	0.69	2.49	30.65	18.12	0.44	
521.00	1-YR PROPOSED	110.00	92.09	8.94	0.41	1.61	27.92	14.89	0.51	
521.00	2-YR EXISTING	150.00	92.69	4.05	0.99	3.50	38.78	15.59	0.47	
521.00	2-YR PROPOSED	150.00	92.43	4.02	0.81	2.30	33.21	15.30	0.51	
514.00	1-YR EXISTING	110.00	92.14	3.82	0.80	3.04	28.97	12.95	0.49	
514.00	1-YR PROPOSED	110.00	92.01	4.11	0.45	1.85	29.70	14.79	0.51	
514.00	2-YR EXISTING	150.00	92.83	4.33	0.96	4.24	34.06	15.50	0.51	
514.00	2-YR PROPOSED	150.00	92.34	4.72	0.99	2.89	31.81	15.23	0.58	
500.00	1-YR EXISTING	110.00	91.90	4.33	1.06	4.99	29.59	14.62	0.59	
500.00	1-YR PROPOSED	110.00	91.90	3.84	0.87	3.44	29.83	22.50	0.55	
500.00	2-YR EXISTING	150.00	92.33	4.65	1.27	6.18	30.97	15.19	0.60	
500.00	2-YR PROPOSED	150.00	92.29	4.32	0.98	4.25	30.00	24.53	0.54	
458.00	1-YR EXISTING	110.00	91.36	4.04	0.97	3.91	27.25	14.53	0.52	
458.00	1-YR PROPOSED	110.00	91.35	3.99	0.83	3.67	28.60	17.78	0.51	
458.00	2-YR EXISTING	150.00	91.69	4.64	1.24	5.78	32.35	15.67	0.57	
458.00	2-YR PROPOSED	150.00	91.70	4.49	1.14	4.31	35.15	19.29	0.54	
320.00	1-YR EXISTING	110.00	87.82	5.69	1.98	11.13	19.42	14.87	0.87	
320.00	1-YR PROPOSED	110.00	88.02	4.54	1.21	6.49	24.88	19.98	0.67	
320.00	2-YR EXISTING	150.00	88.09	6.35	2.38	18.00	23.61	16.60	0.91	
320.00	2-YR PROPOSED	150.00	88.99	5.65	1.42	7.20	31.69	21.25	0.69	
213.00	1-YR EXISTING	110.00	88.12	3.50	0.74	2.89	31.40	23.65	0.54	
213.00	1-YR PROPOSED	110.00	88.33	3.74	1.84	6.12	33.80	28.49	0.50	
213.00	2-YR EXISTING	150.00	89.48	3.73	0.70	2.93	40.22	24.64	0.51	
213.00	2-YR PROPOSED	150.00	86.65	4.12	1.88	7.74	43.18	29.79	0.51	
170.00	1-YR EXISTING	110.00	85.40	4.61	1.24	5.79	23.66	14.64	0.64	
170.00	1-YR PROPOSED	110.00	85.32	4.02	1.99	7.99	28.10	20.62	0.57	
170.00	2-YR EXISTING	150.00	85.78	5.10	1.45	7.41	29.42	18.73	0.66	
170.00	2-YR PROPOSED	150.00	85.60	4.43	2.29	10.16	35.19	22.00	0.59	
105.00	1-YR EXISTING	110.00	84.29	4.91	1.37	6.71	22.87	16.95	0.65	
105.00	1-YR PROPOSED	110.00	84.16	4.99	1.09	4.77	25.29	17.29	0.59	
105.00	2-YR EXISTING	150.00	84.63	5.82	1.84	9.06	29.87	26.81	0.67	
105.00	2-YR PROPOSED	150.00	84.50	4.92	1.29	6.35	32.84	27.51	0.61	
44.00	1-YR EXISTING	110.00	83.29	4.45	1.39	6.07	24.71	21.40	0.73	
44.00	1-YR PROPOSED	110.00	83.29	4.45	1.39	6.07	24.72	21.40	0.73	
44.00	2-YR EXISTING	150.00	83.97	3.72	0.82	3.05	44.78	45.49	0.49	
44.00	2-YR PROPOSED	150.00	83.97	3.72	0.82	3.05	44.77	45.48	0.48	

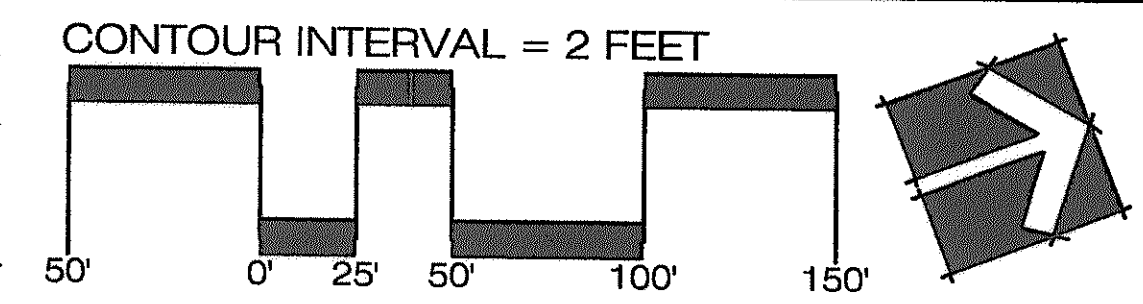

HYDROLOGIC SUMMARY

HYDROLOGIC ANALYSIS
HYDROLOGIC ANALYSES WERE PERFORMED FOR STRAWBERRY RUN, A TRIBUTARY TO CAMERON RUN, NORTH OF VA STATE RTE 288 AND SOUTH OF INTERSTATE 395 IN THE CITY OF ALEXANDRIA, VIRGINIA, IN ORDER TO DETERMINE RUNOFF CHARACTERISTICS DURING VARIOUS STORM EVENTS, AS WELL AS TO DETERMINE DISCHARGES THAT ARE ASSOCIATED WITH BANKFULL ELEVATIONS.

THE DRAINAGE AREA SUPPLYING THE STRAWBERRY RUN TRIBUTARY WAS DELINEATED USING 2 FOOT DIGITAL TOPOGRAPHY AND CURRENT AERIAL PHOTOS WITH A RESULTANT TOTAL DRAINAGE AREA OF 137.51 ACRES.

PEAK FLOWS FOR VARIOUS RECURRENCE INTERVALS WERE DEVELOPED USING THE NATURAL RESOURCES CONSERVATION SERVICE (FORMERLY SC5) METHODOLOGY AND RUNOFF PROCEDURES AS IMPLEMENTED IN PONDPAK MODELING SOFTWARE BY HAESTAD METHODS.

THE FLOWS USED FOR THE VARIOUS DESIGN STORM EVENTS ARE SUMMARIZED IN THE HYDROLOGIC SUMMARY TABLE.

WEG EVALUATED THE 1 AND 2 YEAR STORM EVENTS FOR PEAK DISCHARGE RATES. THESE DESIGN STORM EVENTS WERE THEN INPUT INTO THE US ARMY CORPS OF ENGINEERS' HEC-RAS; RIVER ANALYSIS SYSTEM IN ORDER TO DETERMINE BASELINE FLOW RATES, BOUNDARY CONDITIONS AND FLOW PARAMETERS THAT WERE USED IN THE STREAM RESTORATION DESIGN.

MODEL INPUT DATA

WATERSHED	AREA (AC)	CN	Tc (HR)
TAFT AVE.	137.51	82	0.65

HYDROLOGIC SUMMARY

STORM EVENT (YR)	RAINFALL (IN)	PEAK DISCHARGE (CFS)
1	2.7	109.76
2	3.2	149.15

HYDRAULIC SUMMARY

HYDRAULIC ANALYSIS
HYDRAULIC ANALYSIS OF STRAWBERRY RUN, A TRIBUTARY TO CAMERON RUN, WAS PERFORMED USING THE USACE HEC-RAS PROGRAM TO DETERMINE THE STORM MAGNITUDE AND RECURRENCE INTERVAL CAUSING OVER-BANK FLOODING AT DIFFERENT CROSS-SECTIONS, AS WELL AS AREAS OF HIGH SHEAR STRESS AND STREAM POWER THAT INDICATE AREAS WHERE STREAM RESTORATION TECHNIQUES AND BANK STABILIZATION ARE NEEDED.

CROSS SECTIONS WERE DEVELOPED FROM EXISTING 2-FOOT DIGITAL TOPOGRAPHY WHICH WAS SUPPLEMENTED WITH CROSS SECTIONS SURVEYED BY WEG USING A TOPOCON LASER LEVEL. THESE CROSS SECTIONS DESCRIBE THE CHANNEL GEOMETRY AS WELL AS THE OVERBANK FLOODPLAIN AREAS.

MANNING'S COEFFICIENTS FOR EXISTING CONDITIONS WERE DETERMINED FROM PHOTO DOCUMENTATION AND HEC-RAS TABLES FOR CHANNELS WITH COBBLES, STONES, AND SOME VEGETATION (0.048 - 0.05) AND FLOODPLAINS WITH MEDIUM TO DENSE BRUSH (0.01). FOR PROPOSED CONDITIONS, MANNING'S COEFFICIENTS WERE ADJUSTED, FROM 0.048-0.05 TO 0.07, IN REACHES WHERE CROSS VANES, PLUNGE POOLS, AND J-HOOKS ARE PROPOSED TO EFFECTIVELY MODEL THE PROPOSED STREAM RESTORATION TECHNIQUES.


THE HYDRAULIC ANALYSIS WAS USED TO DETERMINE THE OVERALL CONVEYANCE CAPACITY CHARACTERISTICS OF THE PRIMARY, AND BANKFULL BENCH ELEVATIONS THAT WOULD ALLOW FLOW CONVEYANCE DURING LARGER STORM EVENTS.

THE FLOW CHARACTERISTICS GENERATED BY THIS ANALYSIS ARE SUMMARIZED IN THE HYDRAULIC SUMMARY TABLE.


MODELING INDICATED THAT WITH EXISTING CONDITIONS CHANNEL GEOMETRY, OVER-BANK FLOODING DOES NOT OCCUR FOR SMALLER RECURRENCE INTERVALS (1-YR STORM AND 2-YR STORM).

THE RESULTS OF THE MODEL INDICATE THAT BANKFULL WIDTH AND DEPTH MEASUREMENTS DERIVED FROM THE GEOMORPHIC ASSESSMENT (FIELD INDICATORS) OF THE STREAM ARE GENERALLY CONSISTENT WITH THE MODELED WATER SURFACE ELEVATIONS FOR THE 1-YEAR STORM EVENT (CHANNEL FORMING FLOW).

EXISTING CONDITIONS

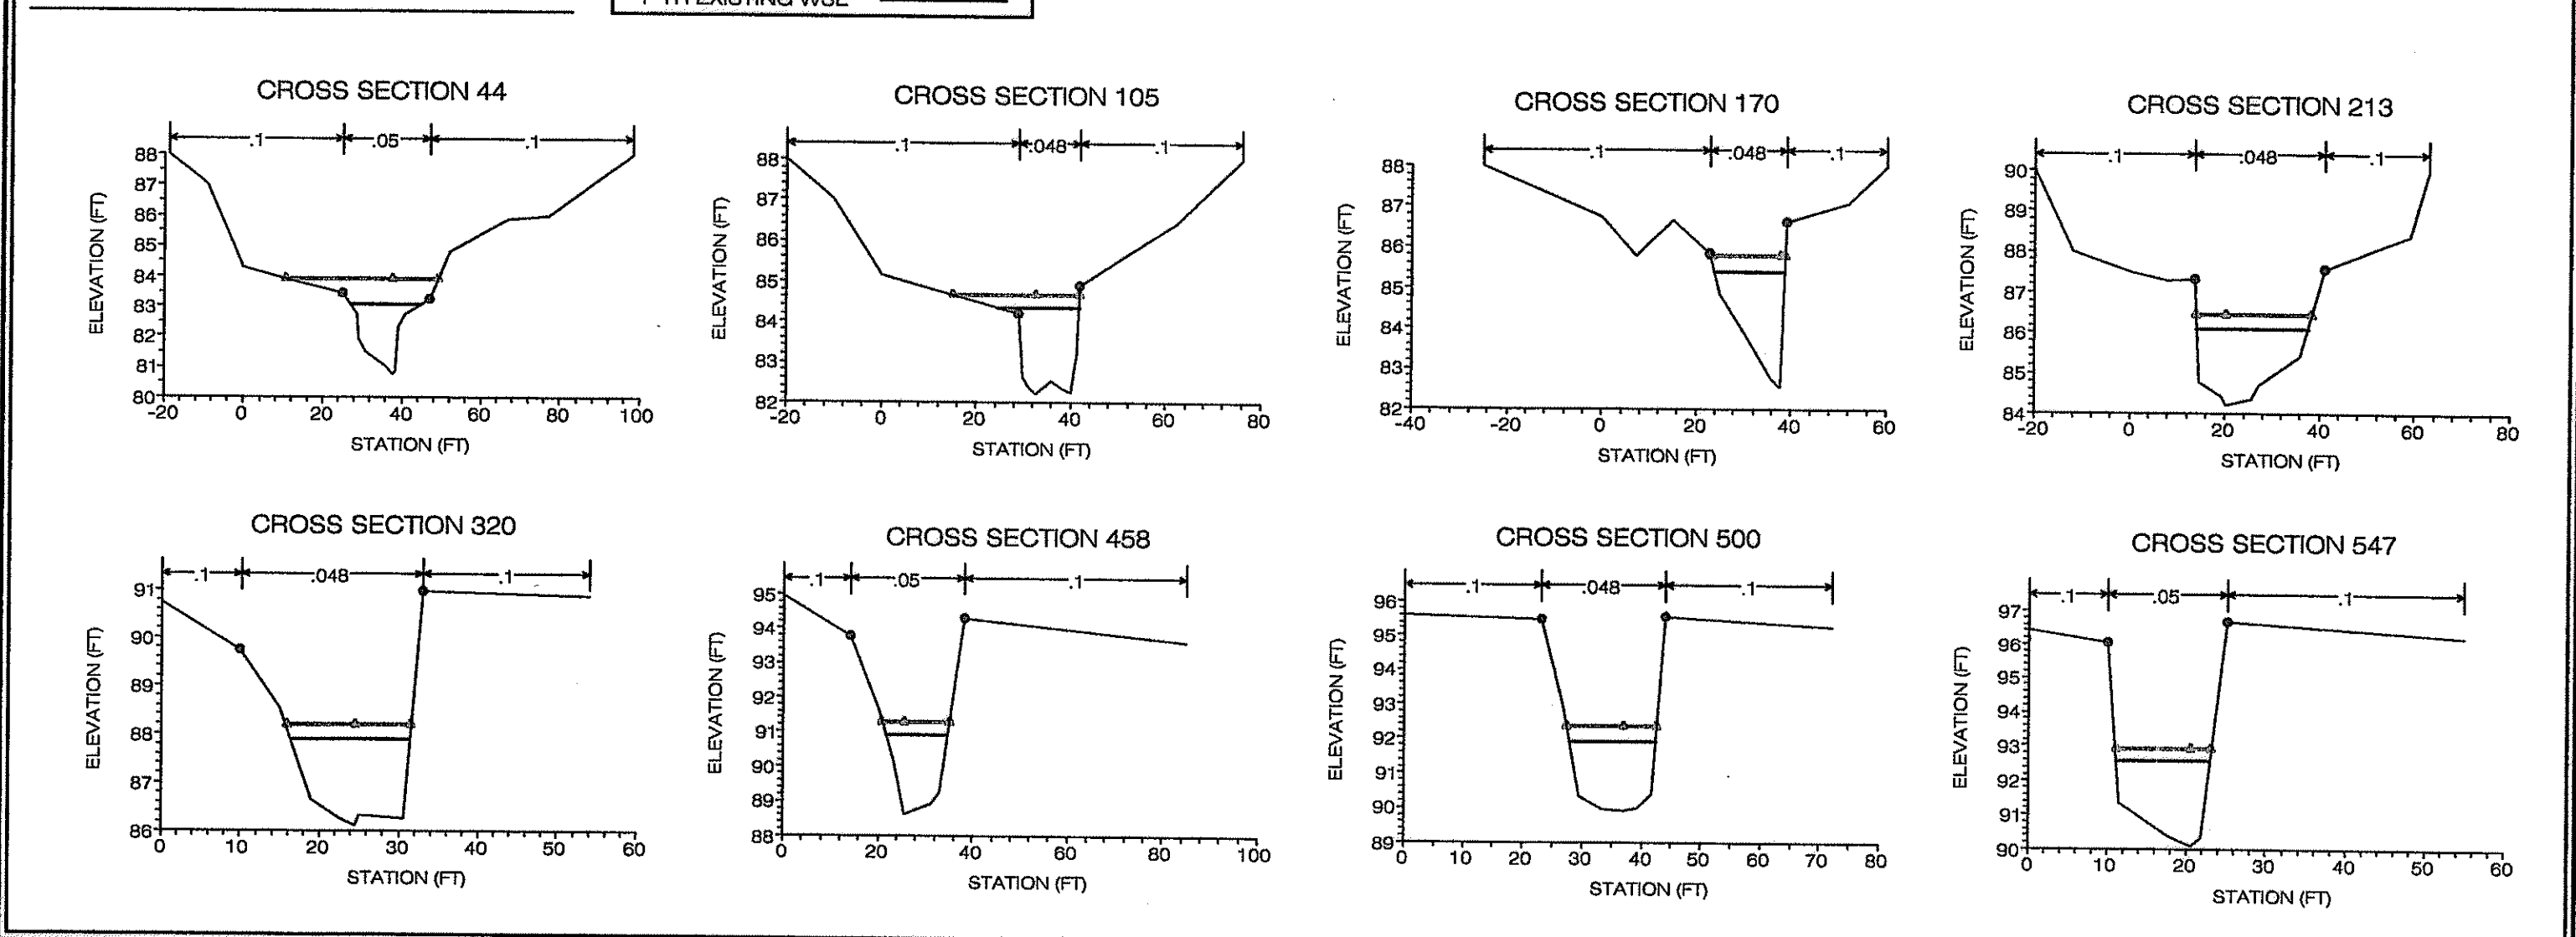

PROPOSED CONDITIONS

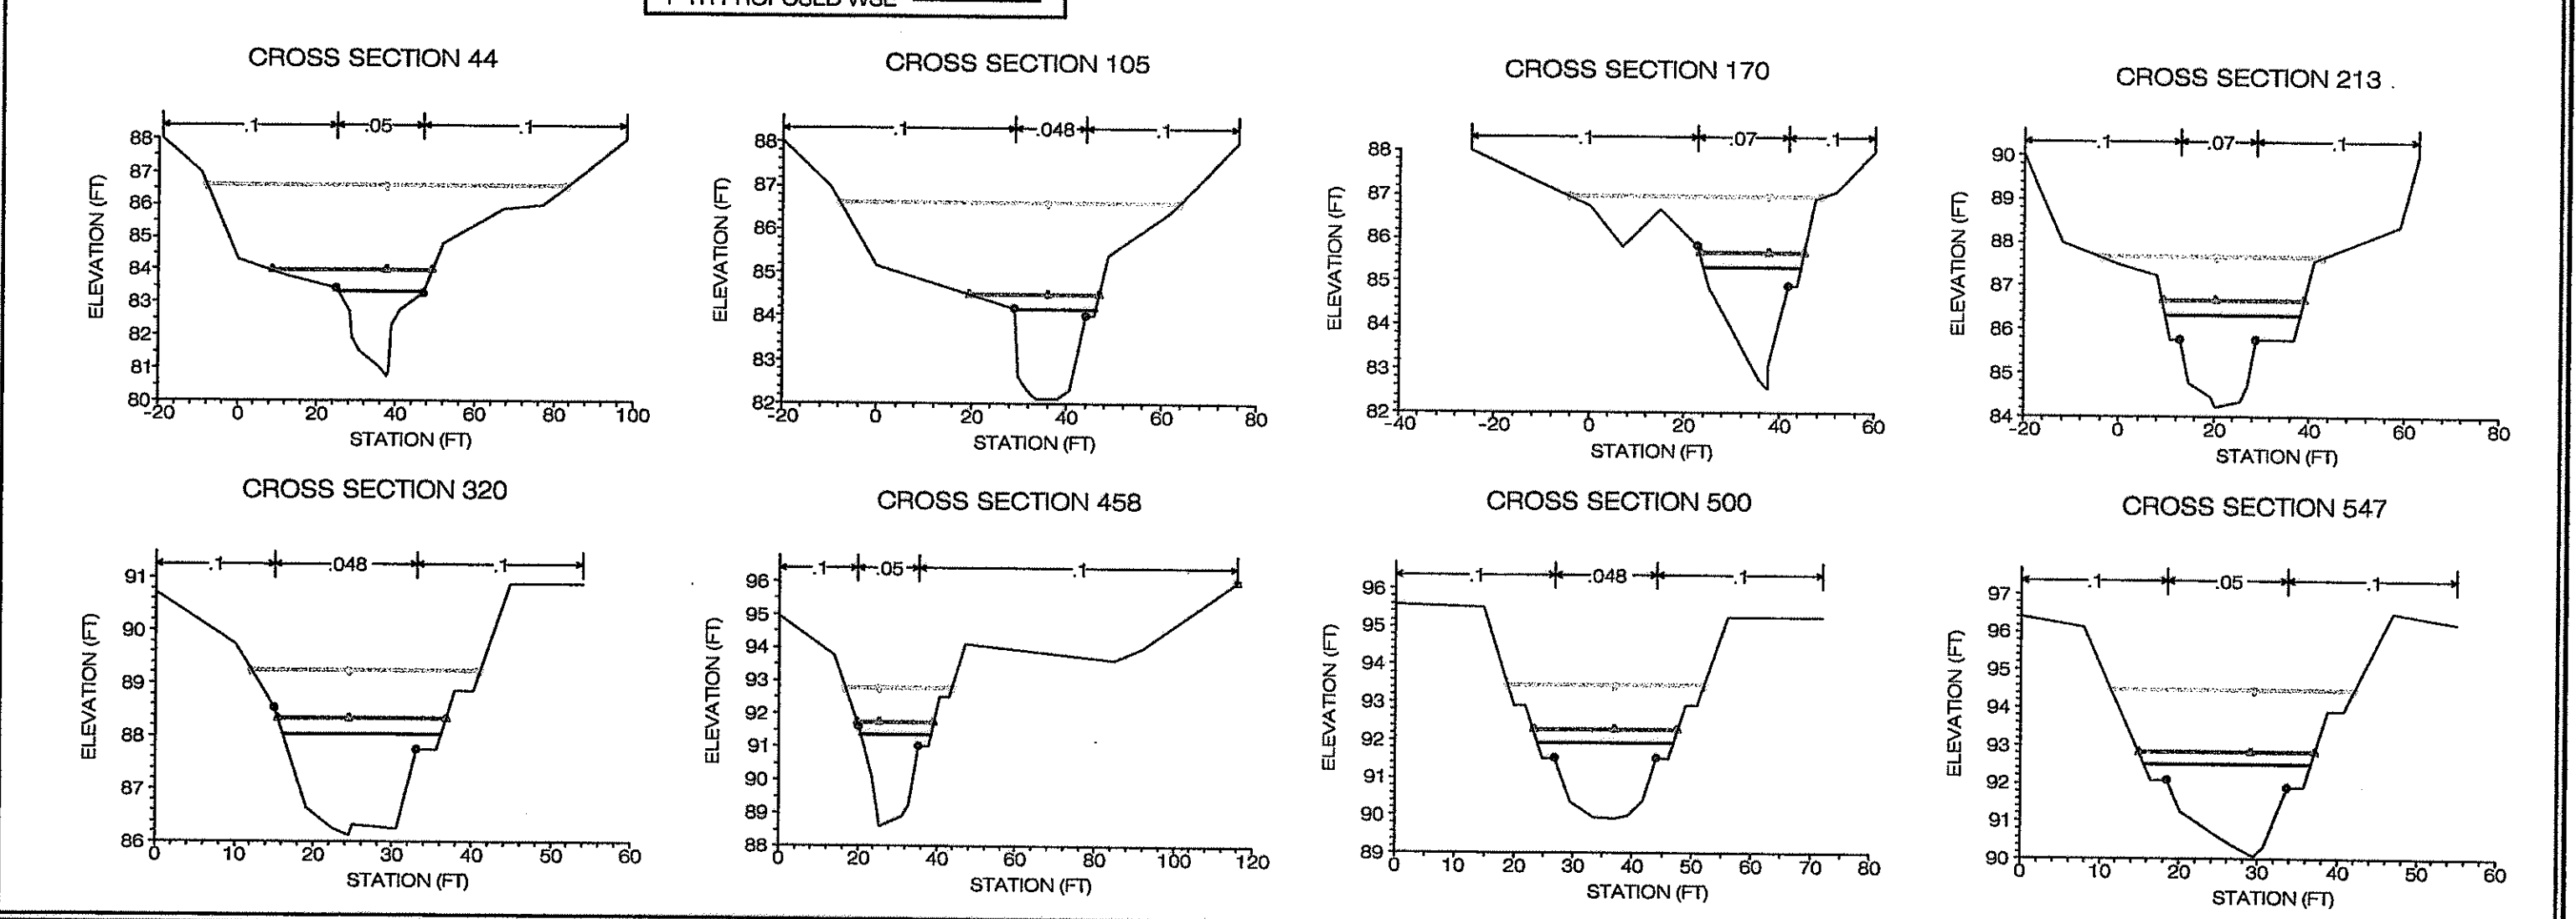

LEGEND:

- PROJECT LIMITS
- APPROXIMATE STREAM CHANNEL LIMITS
- EXISTING CONTOURS
- EXISTING BUILDING (TYP)
- EXISTING TREE AND DRIP LINE
- EXISTING 88" CULVERT (DUKE STREET)
- EXISTING STORMWATER PIPE/OUTFALL
- PROPOSED STORMWATER PIPE/OUTFALL
- PROPOSED GRADING
- PROPOSED BUILDING (TYP.)
- RESOURCE PROTECTION AREA LIMITS
- UN-SURVEYED CROSS-SECTION LOCATION
- SURVEYED CROSS-SECTION LOCATION
- STREAM PROFILE (TYP)

WEG
WILLIAMSBURG ENVIRONMENTAL GROUP, INC.
15000 Corner Street
Newport News, Virginia 23608
757-220-8200
2008 Squires View Drive
Newport News, Virginia 23602
757-220-4474

HYDROLOGIC AND HYDRAULIC SUMMARY
TAFT AVENUE
CITY OF ALEXANDRIA, VIRGINIA

COMMONWEALTH OF VIRGINIA
Cheyrey T. Hancock
Lic. No. 37017
01/14/2008
PROFESSIONAL ENGINEER

REVISIONS:


NO.	DATE	DESCRIPTION
1	12/27/08	UPDATED HYDRAULIC SUMMARY
2	03/27/09	BRIDGE RESTORED
3	04/22/09	REVISED REVIEW LETTER

DRAWN BY: NJL/MAM
DESIGNED BY: TWC/BGN/UL
DATE: 12/27/08
CHECKED BY: TWC/UTH
SHEET: 4
JOB#: 2256

APPROVED
SPECIAL USE PERMIT NO. 2007-009
DEPARTMENT OF PLANNING & ZONING
DIRECTOR: *[Signature]* 2/4/09
CHAIRMAN, PLANNING COMMISSION: *[Signature]* 2/4/09
DATE RECORDED: 2/4/09
INSTRUMENT NO. BIDD BOOK NO. PAGE NO.

V:\2200s\2256 - TaftStream Restoration\Construction Plans 10-10-07.dwg

V:\2200s\2256 - TallStream Restoration\Construction Plans 10-10-07.dwg

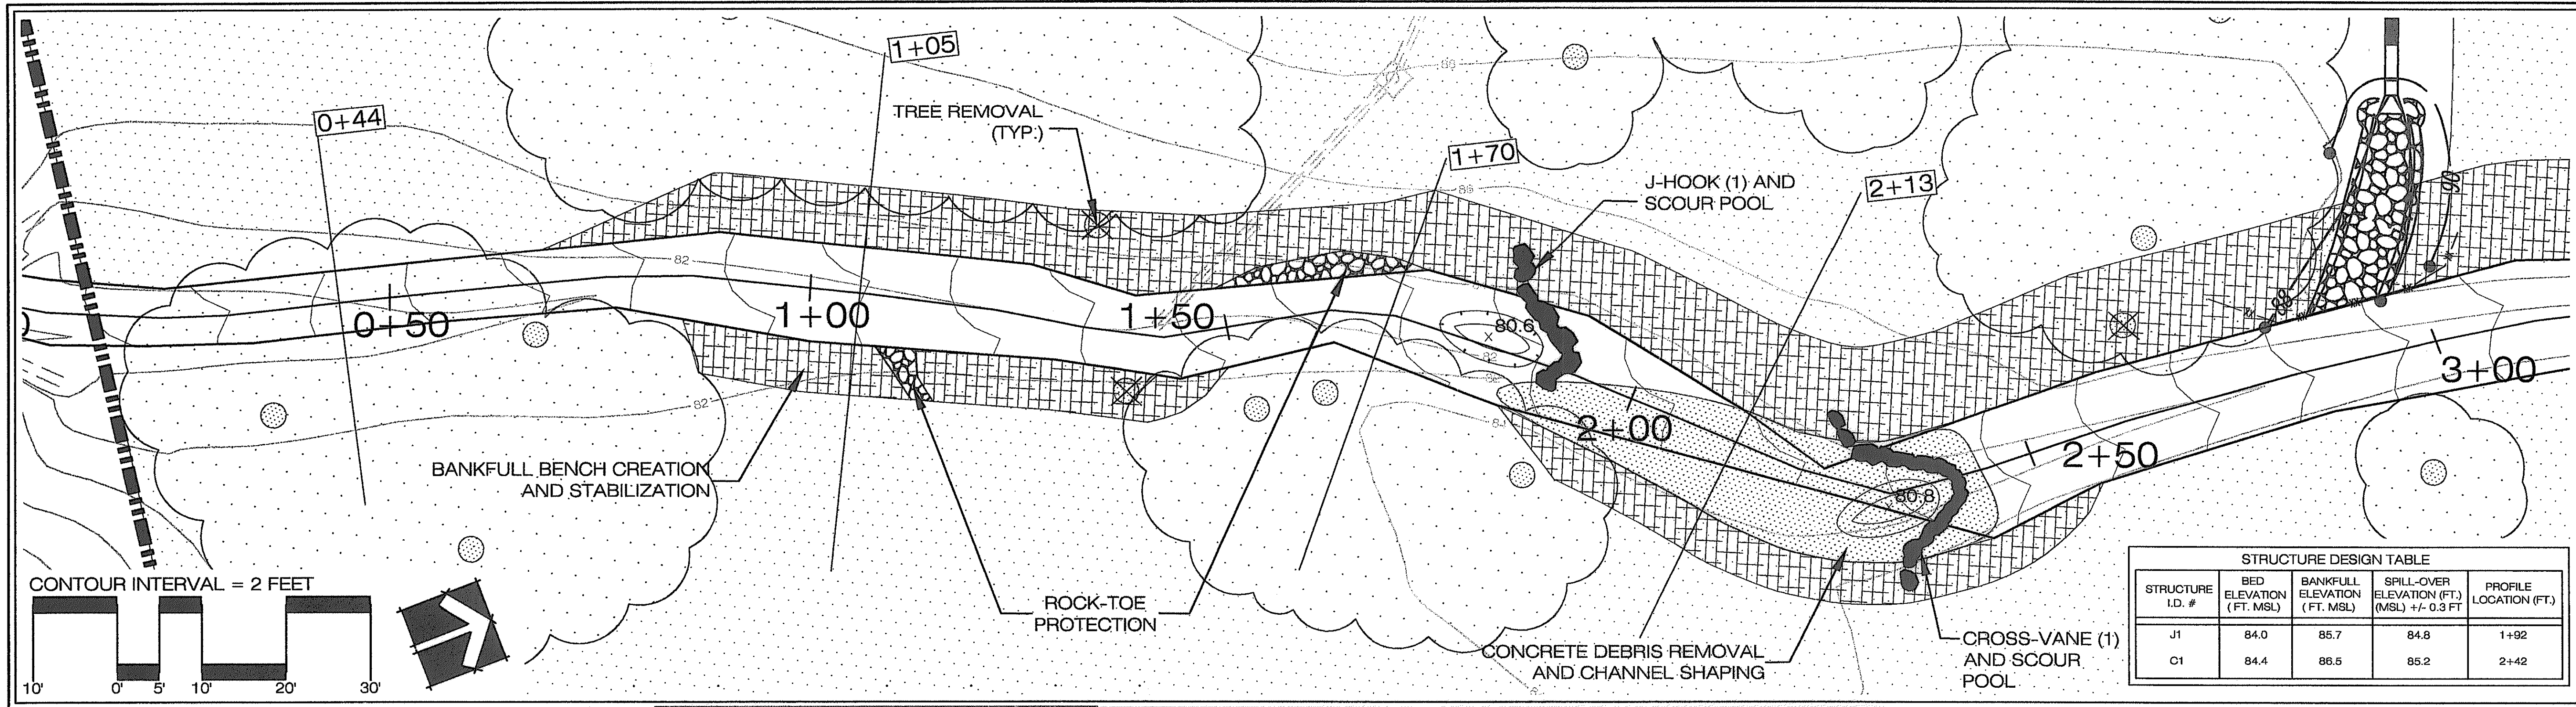


STRUCTURE DESIGN TABLE				
STRUCTURE I.D. #	BED ELEVATION (FT. MSL)	BANKFULL ELEVATION (FT. MSL)	SPILL-OVER ELEVATION (FT. MSL) +/- 0.5 FT	PROFILE LOCATION (FT.)
J1	84.0	85.7	84.8	1+92
C1	84.4	86.5	85.2	2+42

**RESTORATION AREA 1:
CONSTRUCTION ACTIVITIES**

- REMOVE EXISTING CONCRETE DEBRIS
- STABILIZE DRAINAGE SWALE OUTFALL WITH ROCK-TOE PROTECTION
- IMPLEMENT ROCK-TOE PROTECTION
- INSTALL CROSS-VANE AND J-HOOK
- CHANNEL SHAPING AND STABILIZATION
- CREATE AND STABILIZE BANKFULL BENCH
- ADD SEEDING AND MATTING
- INSTALL BANK AND BUFFER PLANTINGS

WSE WATER SURFACE ELEVATION
 WATER SURFACE ELEVATION (9/14/05)


NOTE: NO STREAM RESTORATION ACTIVITIES ARE PLANNED FOR CROSS-SECTION 0+44.

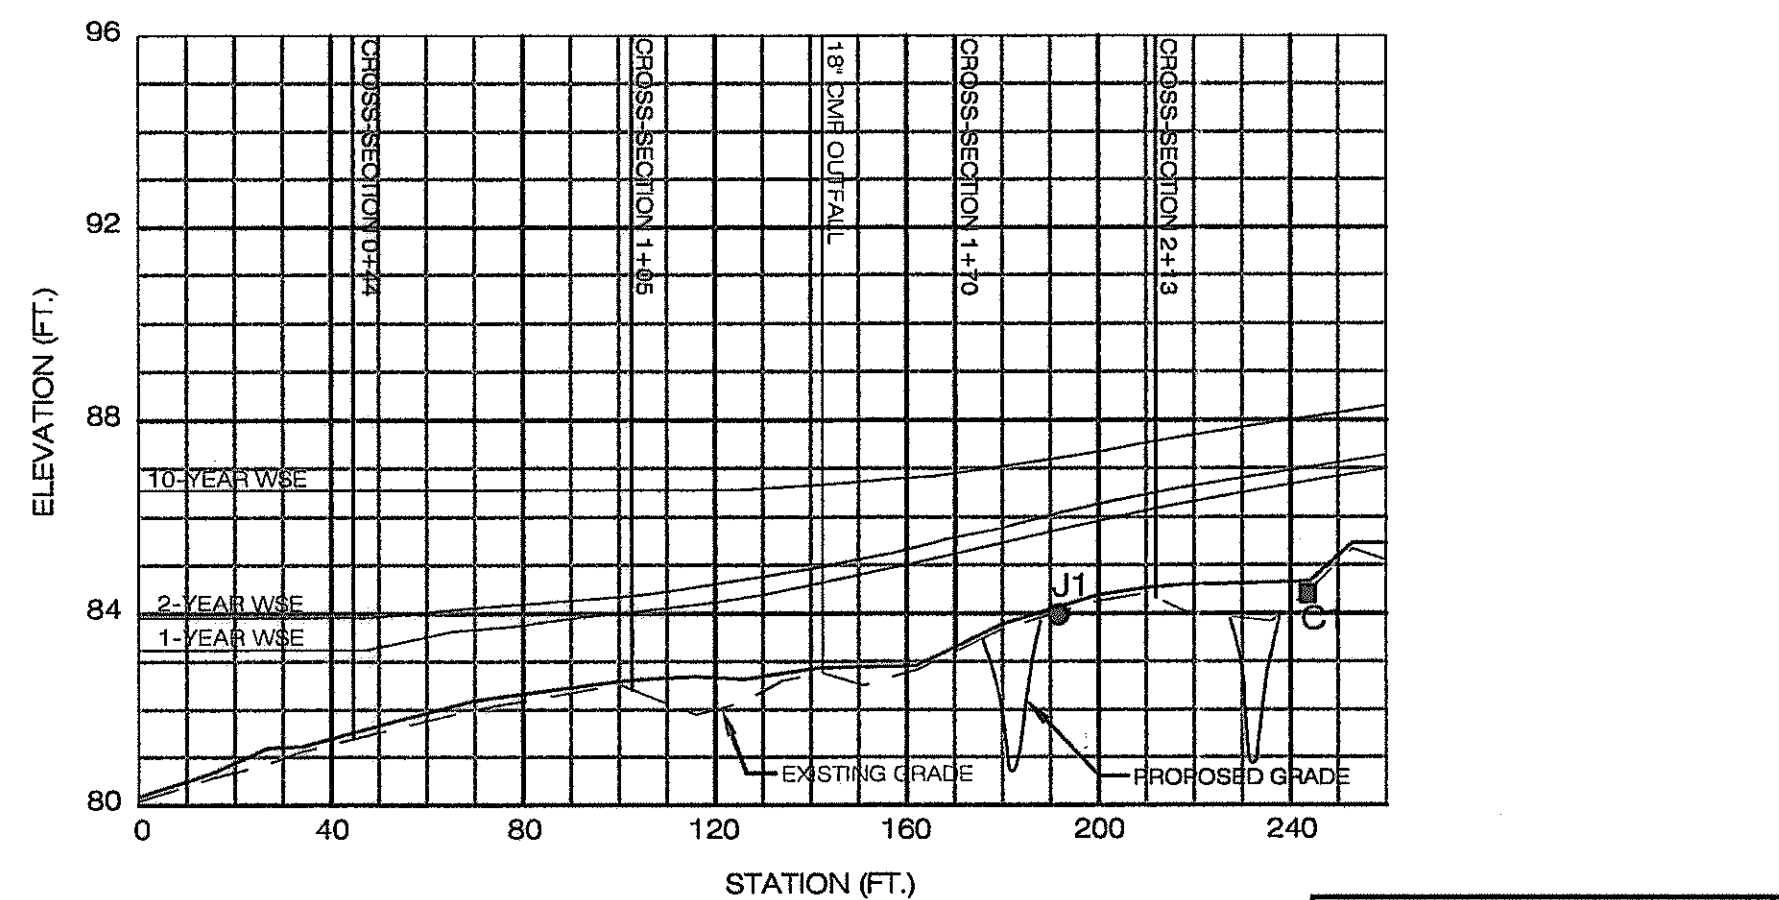

RESTORATION AREA 1 PROFILE

SCALE: HORIZONTAL 1 INCH = 40 FEET, VERTICAL 1 INCH = 4 FEET

● J1 J-HOOK (1)
 ■ C1 CROSS-VANE (1)

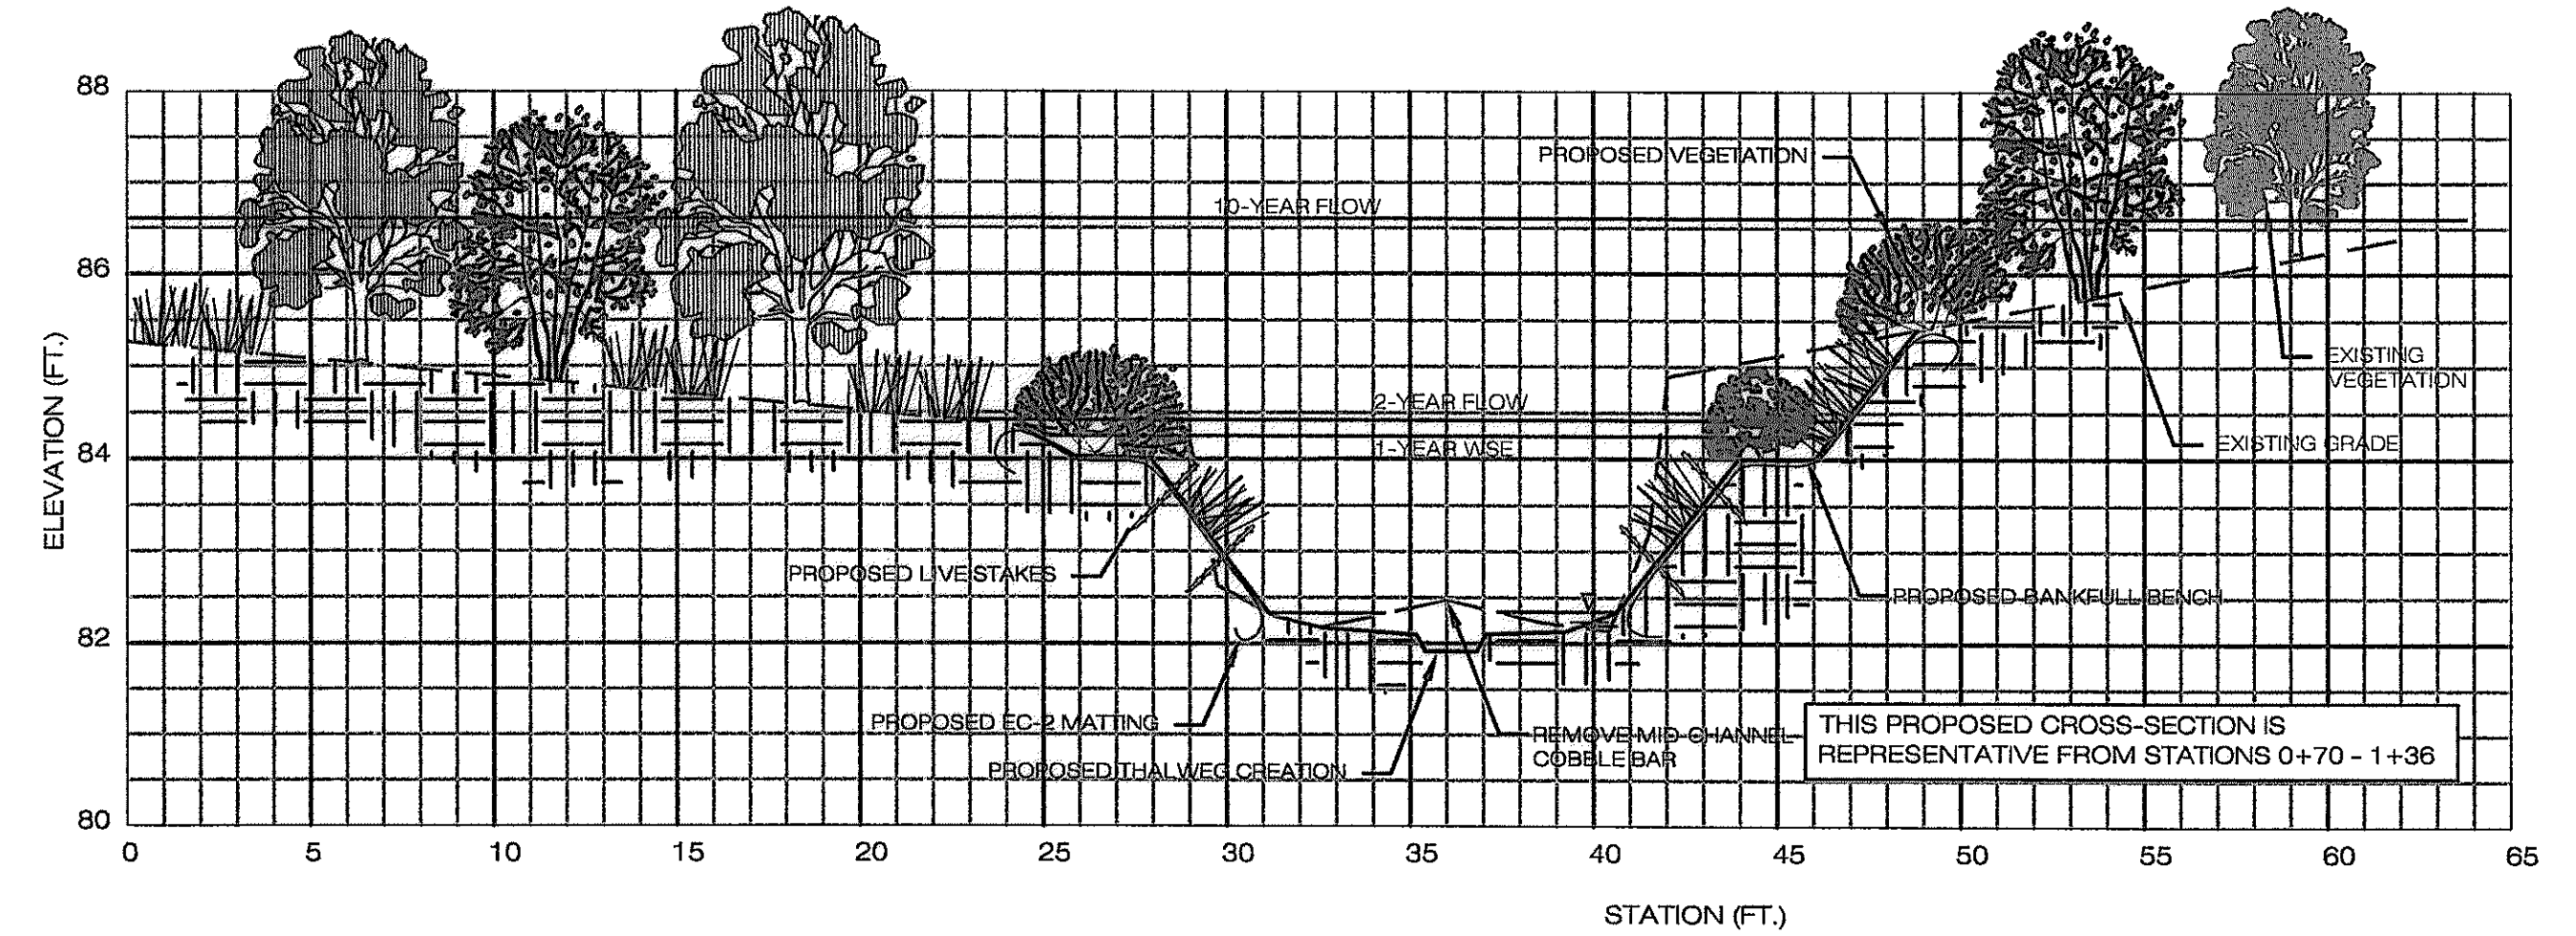


REPRESENTATIVE CROSS-SECTION 1+05

SCALE: HORIZONTAL 1 INCH = 5 FEET, VERTICAL 1 INCH = 2 FEET


**RESTORATION AREA 1:
CONSTRUCTION DETAILS**

- STATION 0+70 - 3+16: SHEET 8
- RIGHT BANKFULL BENCH CREATION AND STABILIZATION
- STATION 0+70 - 1+50, 1+92 - 2+56: SHEET 8
- LEFT BANKFULL BENCH CREATION AND STABILIZATION
- STATION 1+07 - 1+12: SHEET 8
- ROCK-TOE PROTECTION AT OUTFALL OF DRAINAGE SWALE
- STATION 1+50- 1+73: SHEET 8
- RIGHT BANK ROCK-TOE PROTECTION
- STATION 1+92: SHEET 8
- J-HOOK (1)
- STATION 2+42: SHEET 8
- CROSS-VANE (1)
- STATION 2+90: SHEET 8
- OUTLET PROTECTION (DESIGNED BY LAND DESIGN CONSULTANTS, DSP# 2004-0038)

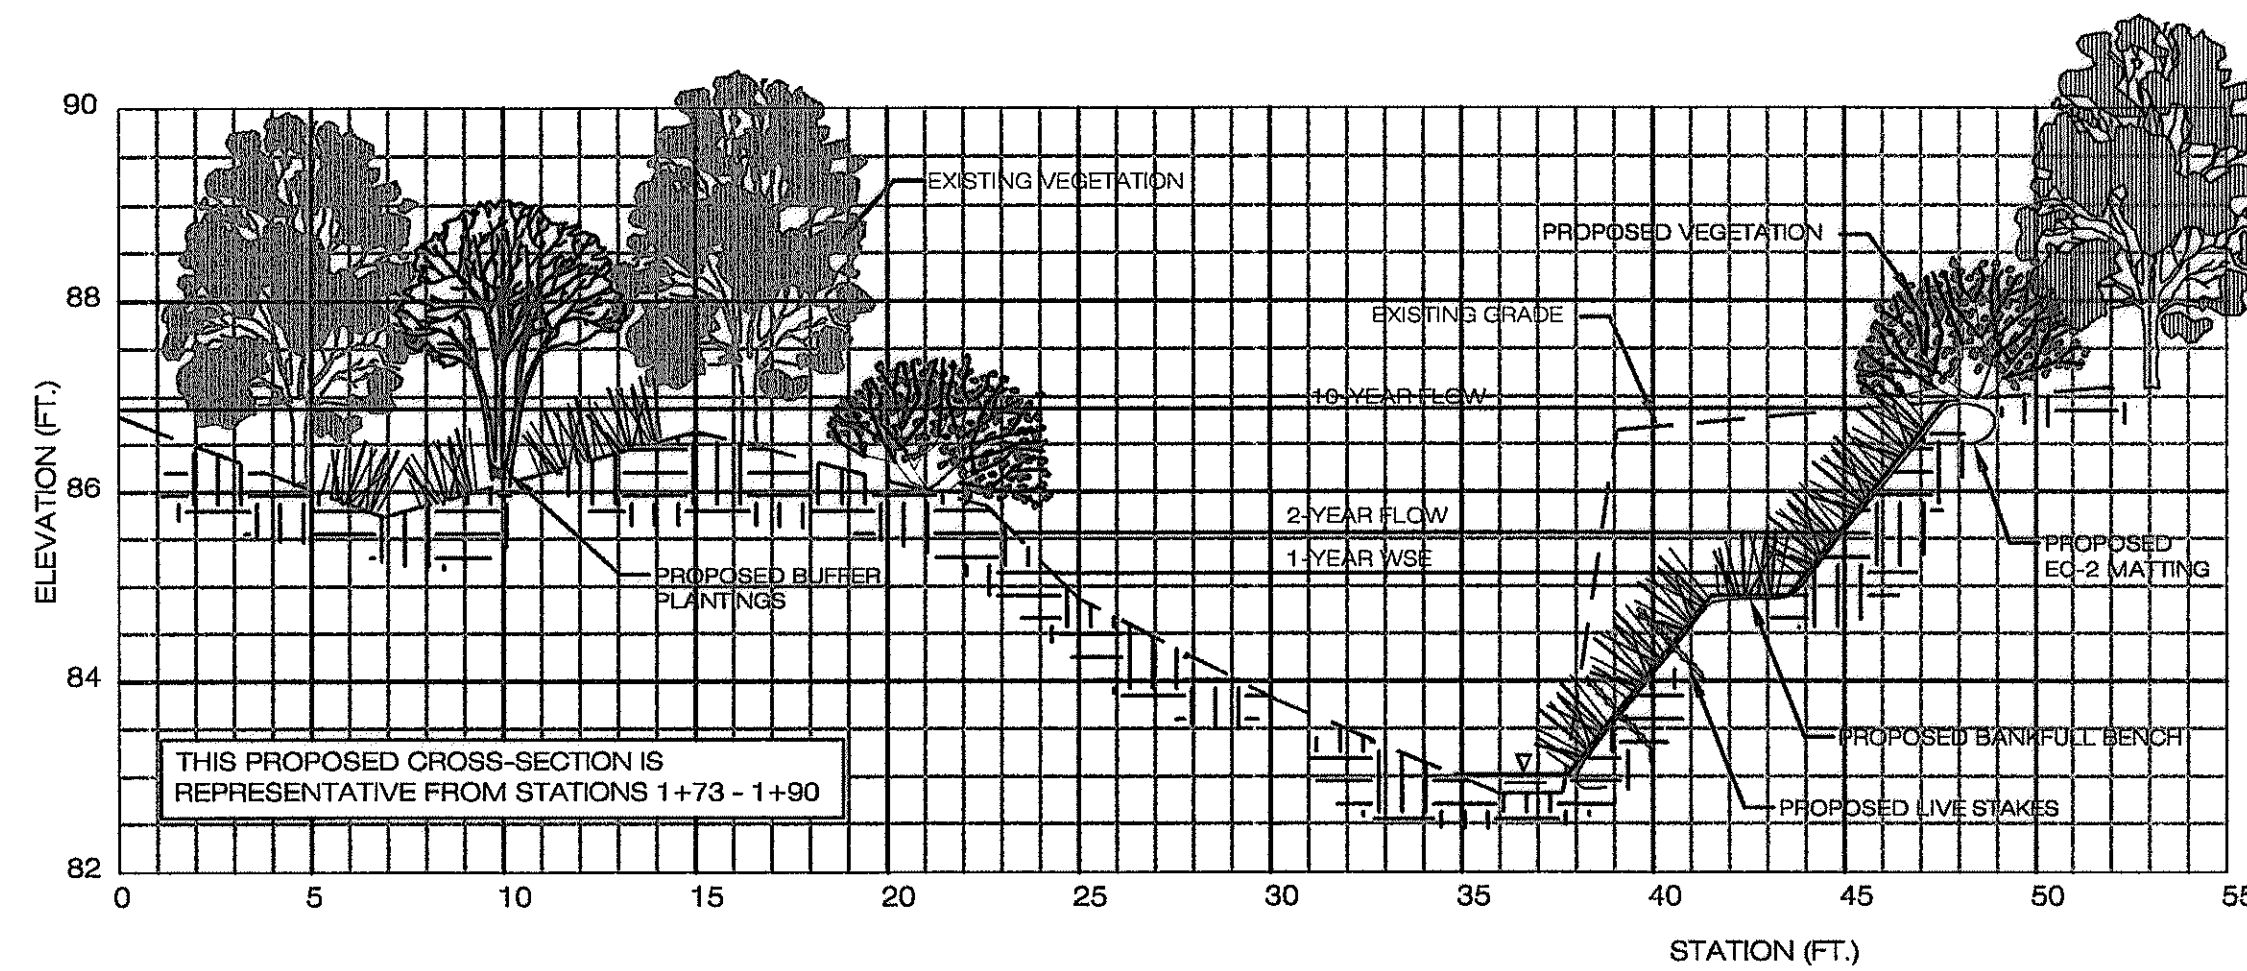

REPRESENTATIVE CROSS-SECTION 1+70

SCALE: HORIZONTAL 1 INCH = 5 FEET, VERTICAL 1 INCH = 2 FEET

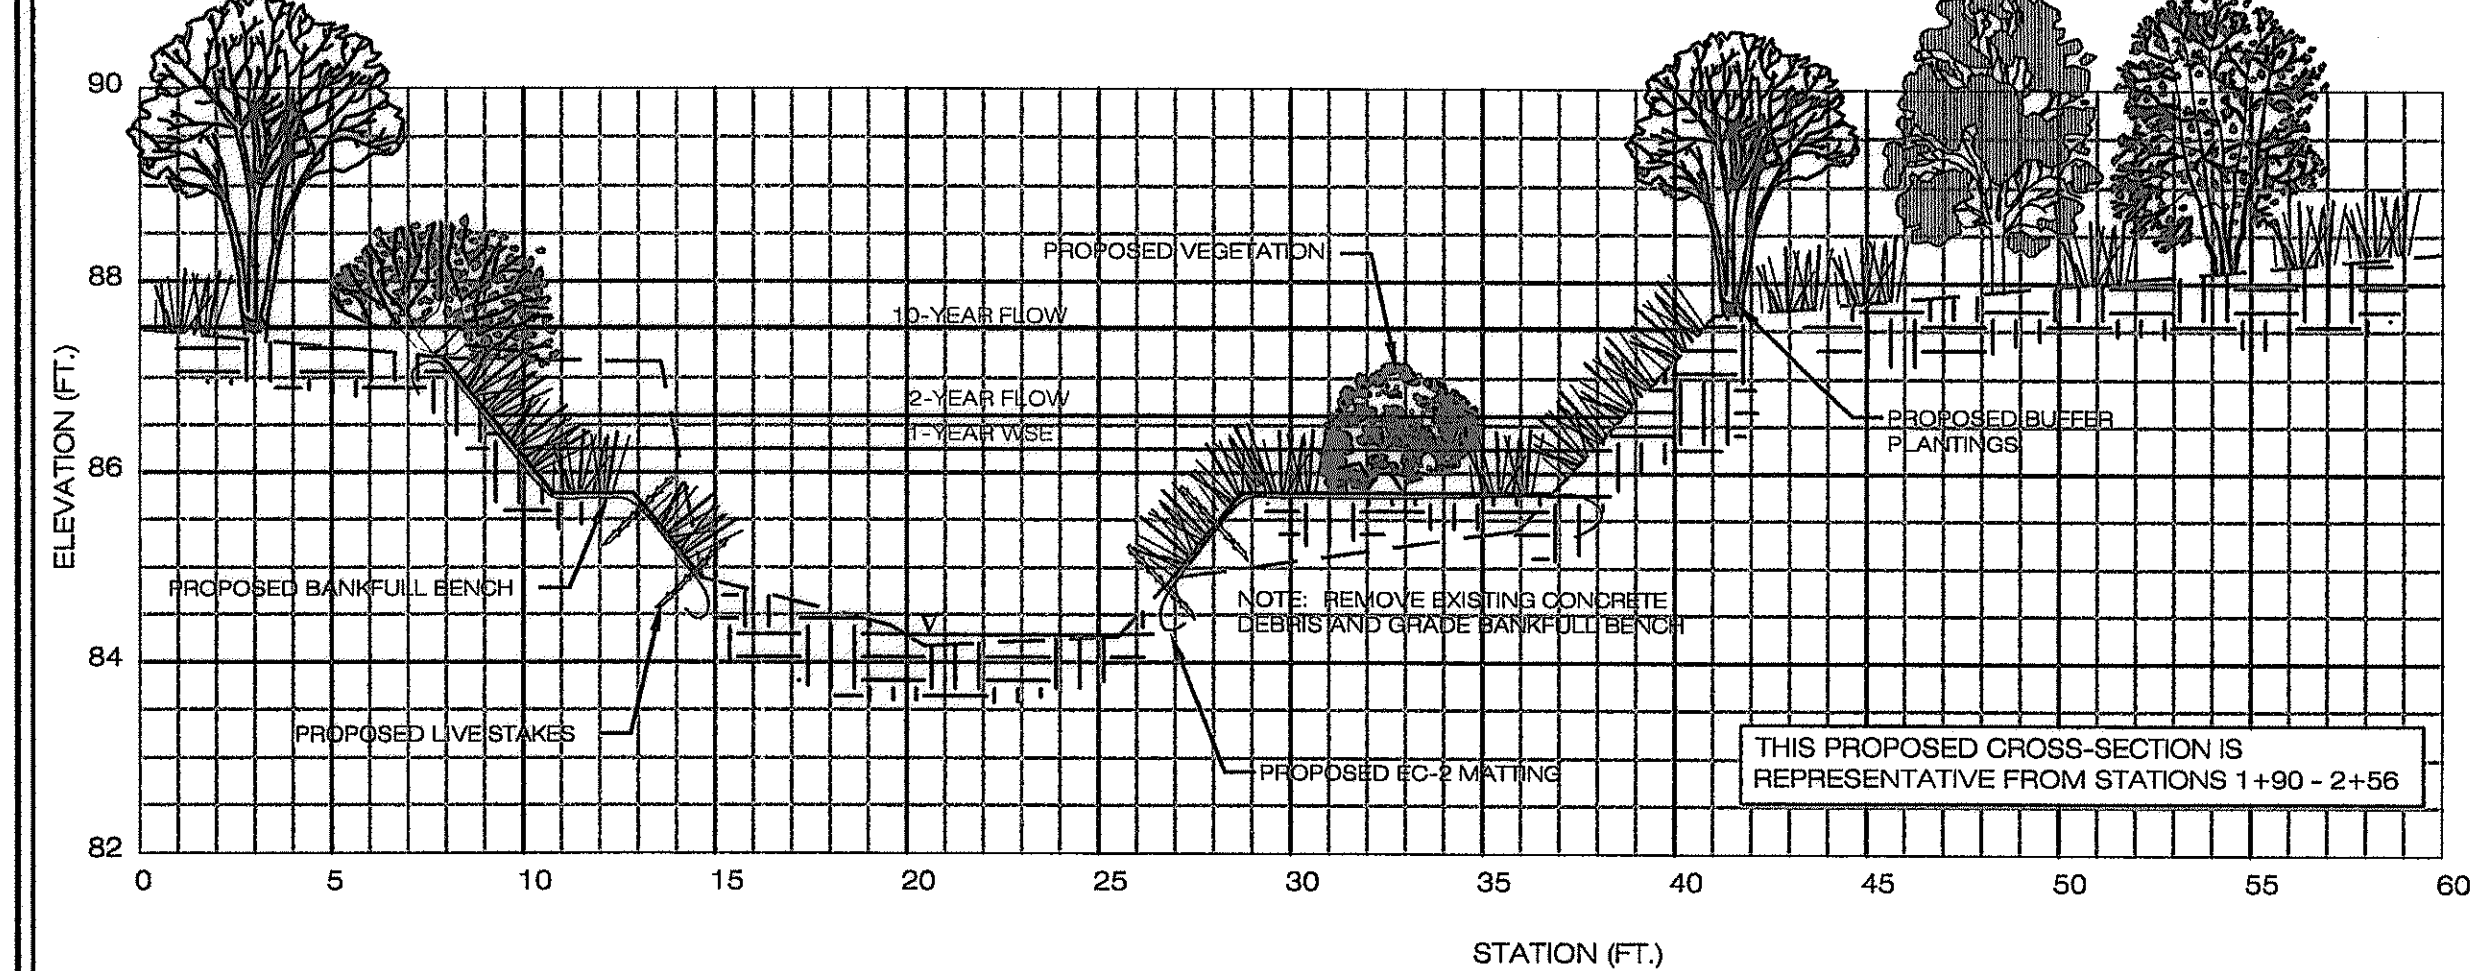

REPRESENTATIVE CROSS-SECTION 2+13

SCALE: HORIZONTAL 1 INCH = 5 FEET, VERTICAL 1 INCH = 2 FEET

13621 Park Center Road
 Reston, VA 20190
 (703) 427-5000
 Environmental Consultants

3000 Center Street
 Virginia 20188
 (703) 220-0000

7001 Boulder View Drive
 Reston, VA 20190
 (703) 220-0000

8706 Salem Run Blvd.
 Front Royal, VA 22625
 (540) 251-5412

WEG
 WILLIAMSBURG
 ENVIRONMENTAL
 GROUP, INC.

PLAN AND PROFILE: {0+00 - 2+56}
RESTORATION AREA 1
Taft Avenue
CITY OF ALEXANDRIA, VIRGINIA

COMMONWEALTH OF VIRGINIA
 JEFFREY T. HAWOCKY
 Lic. No. 37017
 01/16/2008
 PROFESSIONAL ENGINEER

REVISIONS:	DATE:
12/16/05 UPDATED LONGITUDINAL PROFILE	
04/27/07 (SERIES REVISION)	
08/14/07 FIRST REVIEW LETTER	
07/05/08 PER CITY COMMENT	

DRAWN BY: EBG/MAM
 DESIGNED BY: TWCEBG/MUL
 DATE: 12/27/05
 CHECKED BY: TWU/JTH




SHEET: **5**
 JOB#: 2256

APPROVED
 SPECIAL USE PERMIT NO. 2007-0008
 DEPARTMENT OF PLANNING & ZONING
 2/4/08
 DIRECTOR

DEPARTMENT OF TRANSPORTATION & ENVIRONMENTAL SERVICES
 SITE PLAN NO. 2007-0018
 2/1/08
 DIRECTOR



CHAIRMAN, PLANNING COMMISSION
 DATE RECORDED

INSTRUMENT NO. DEED BOOK NO. PAGE NO.

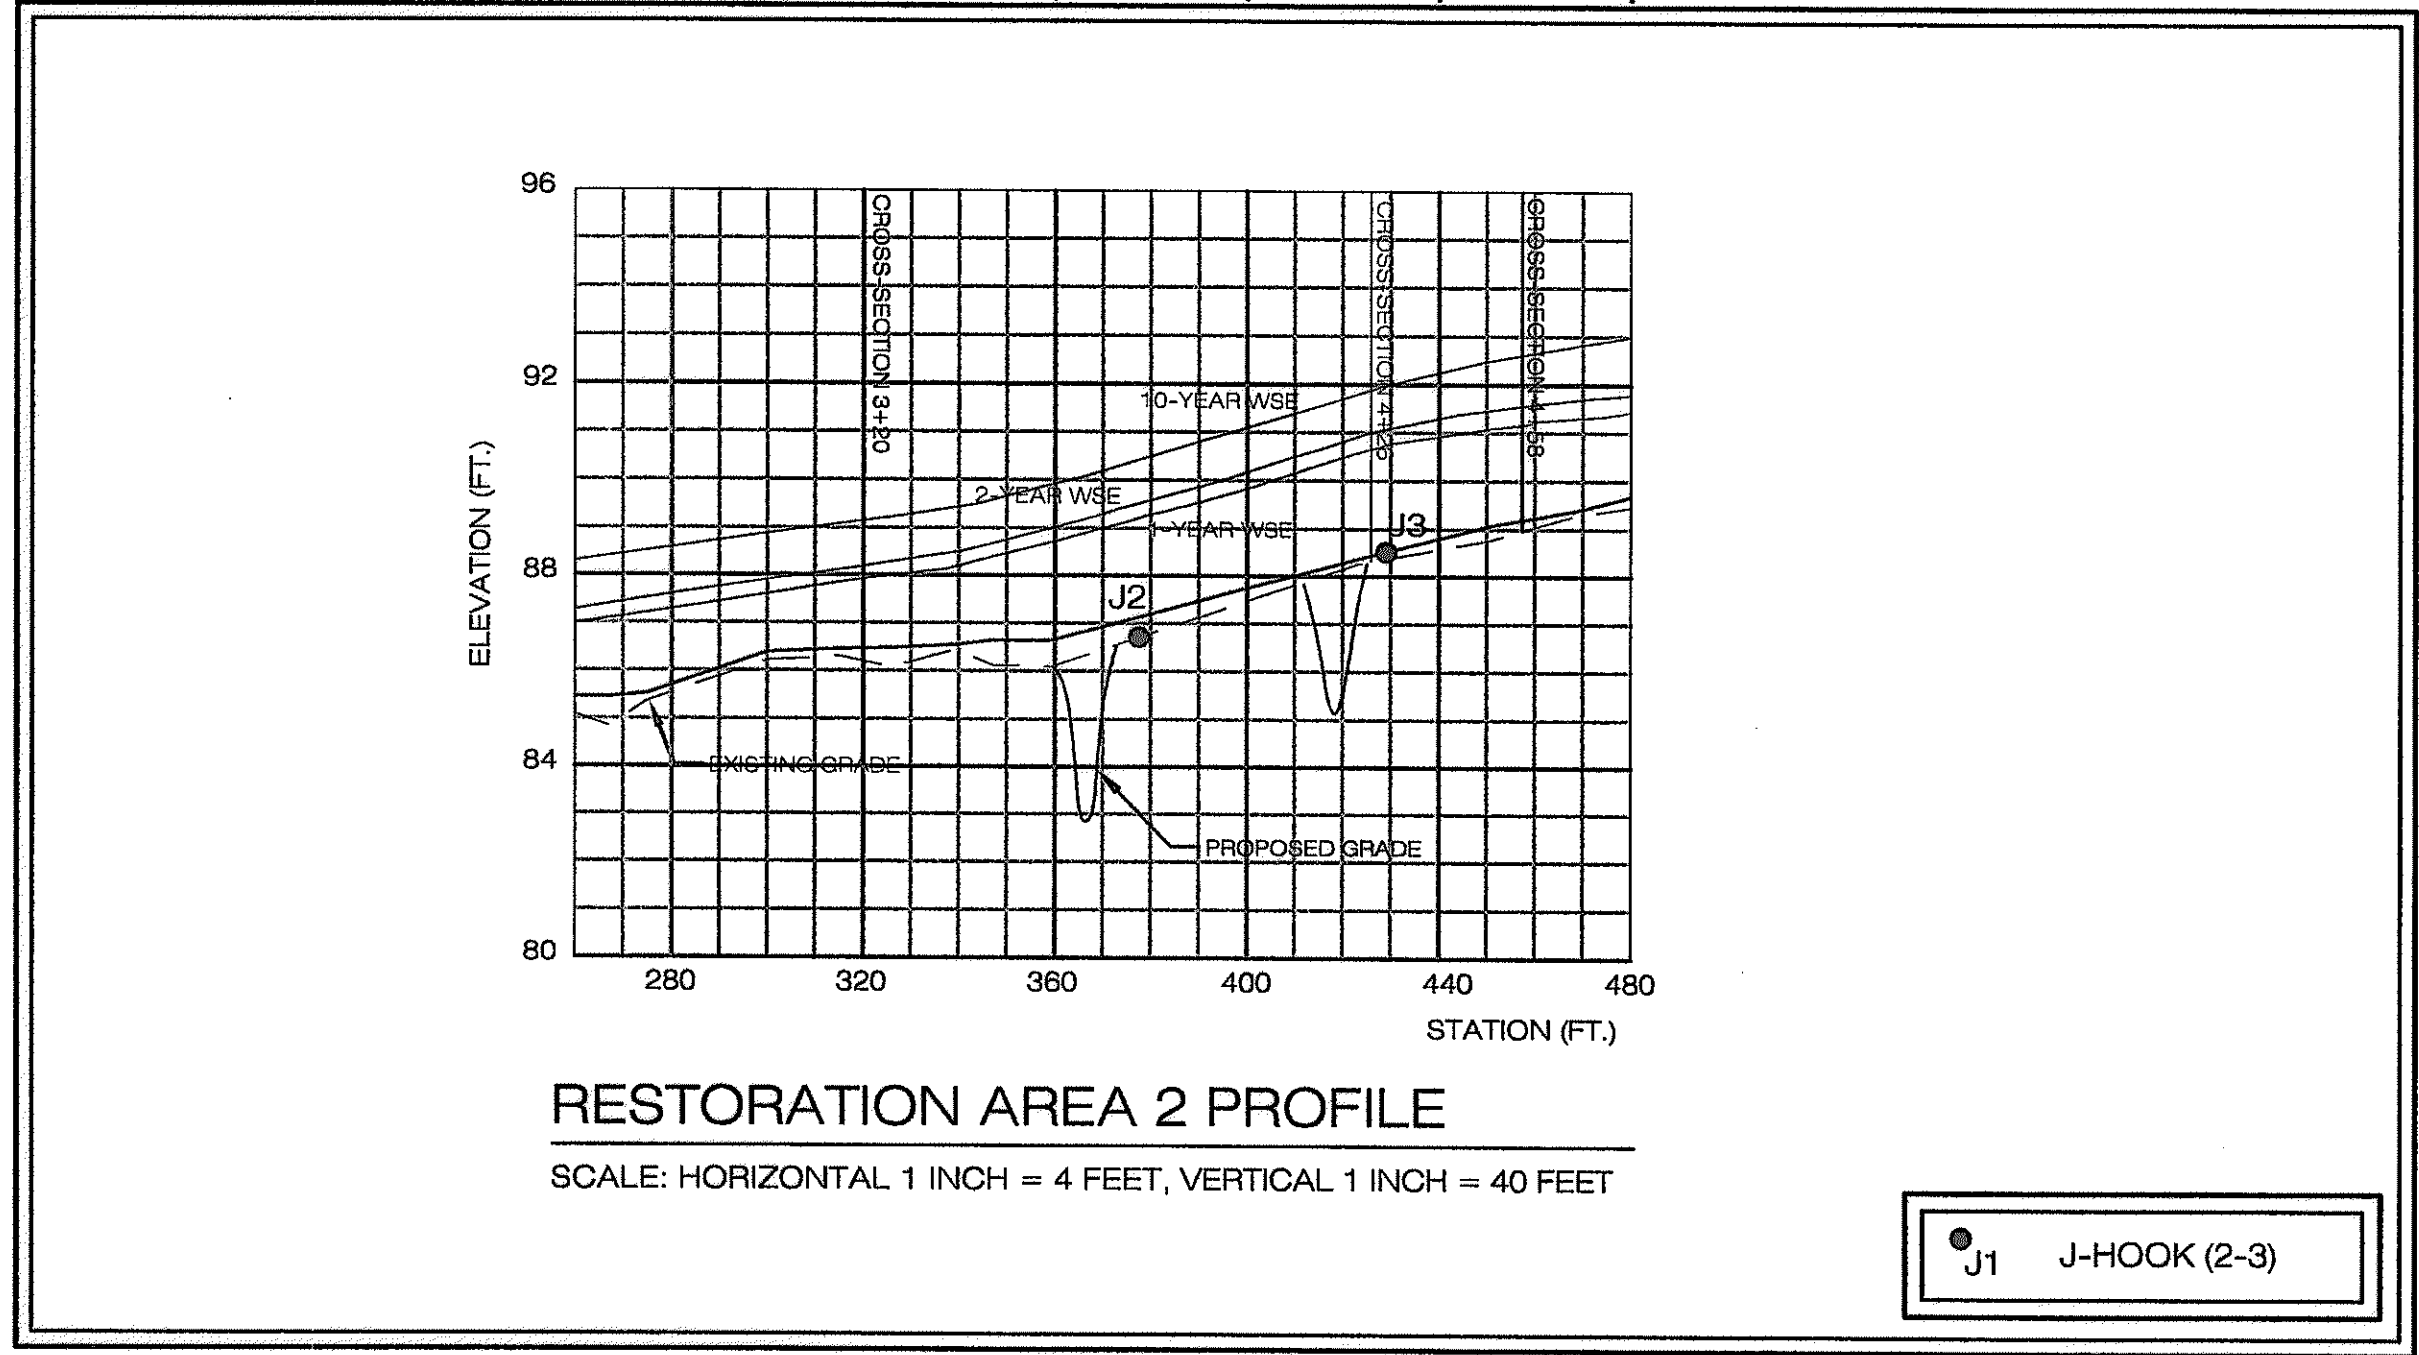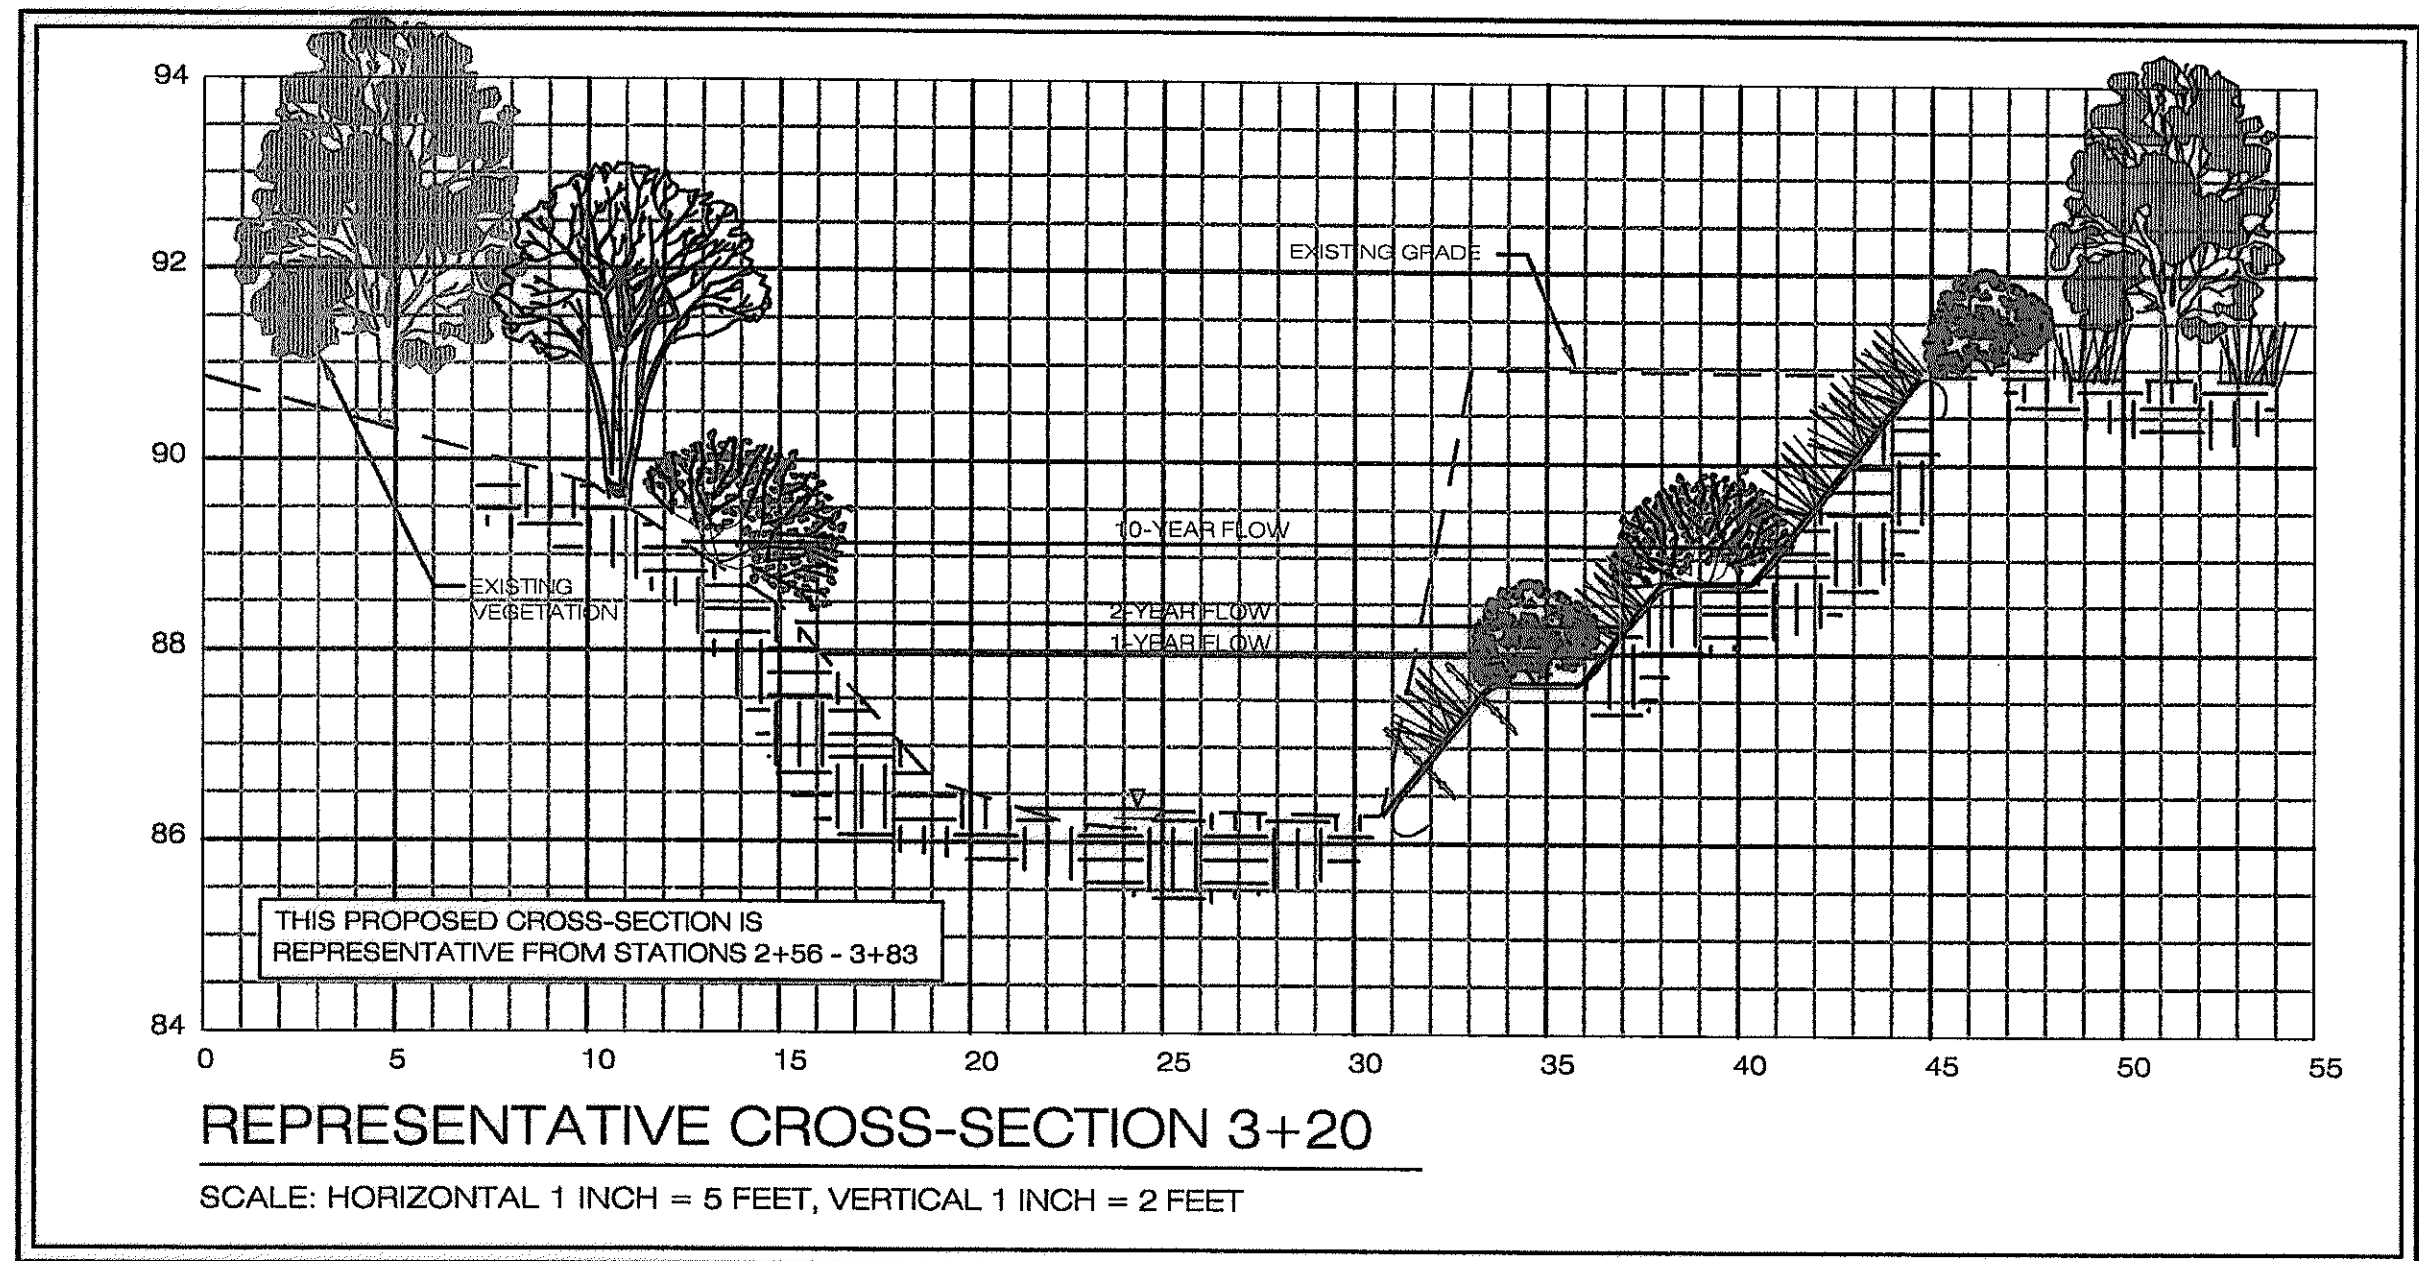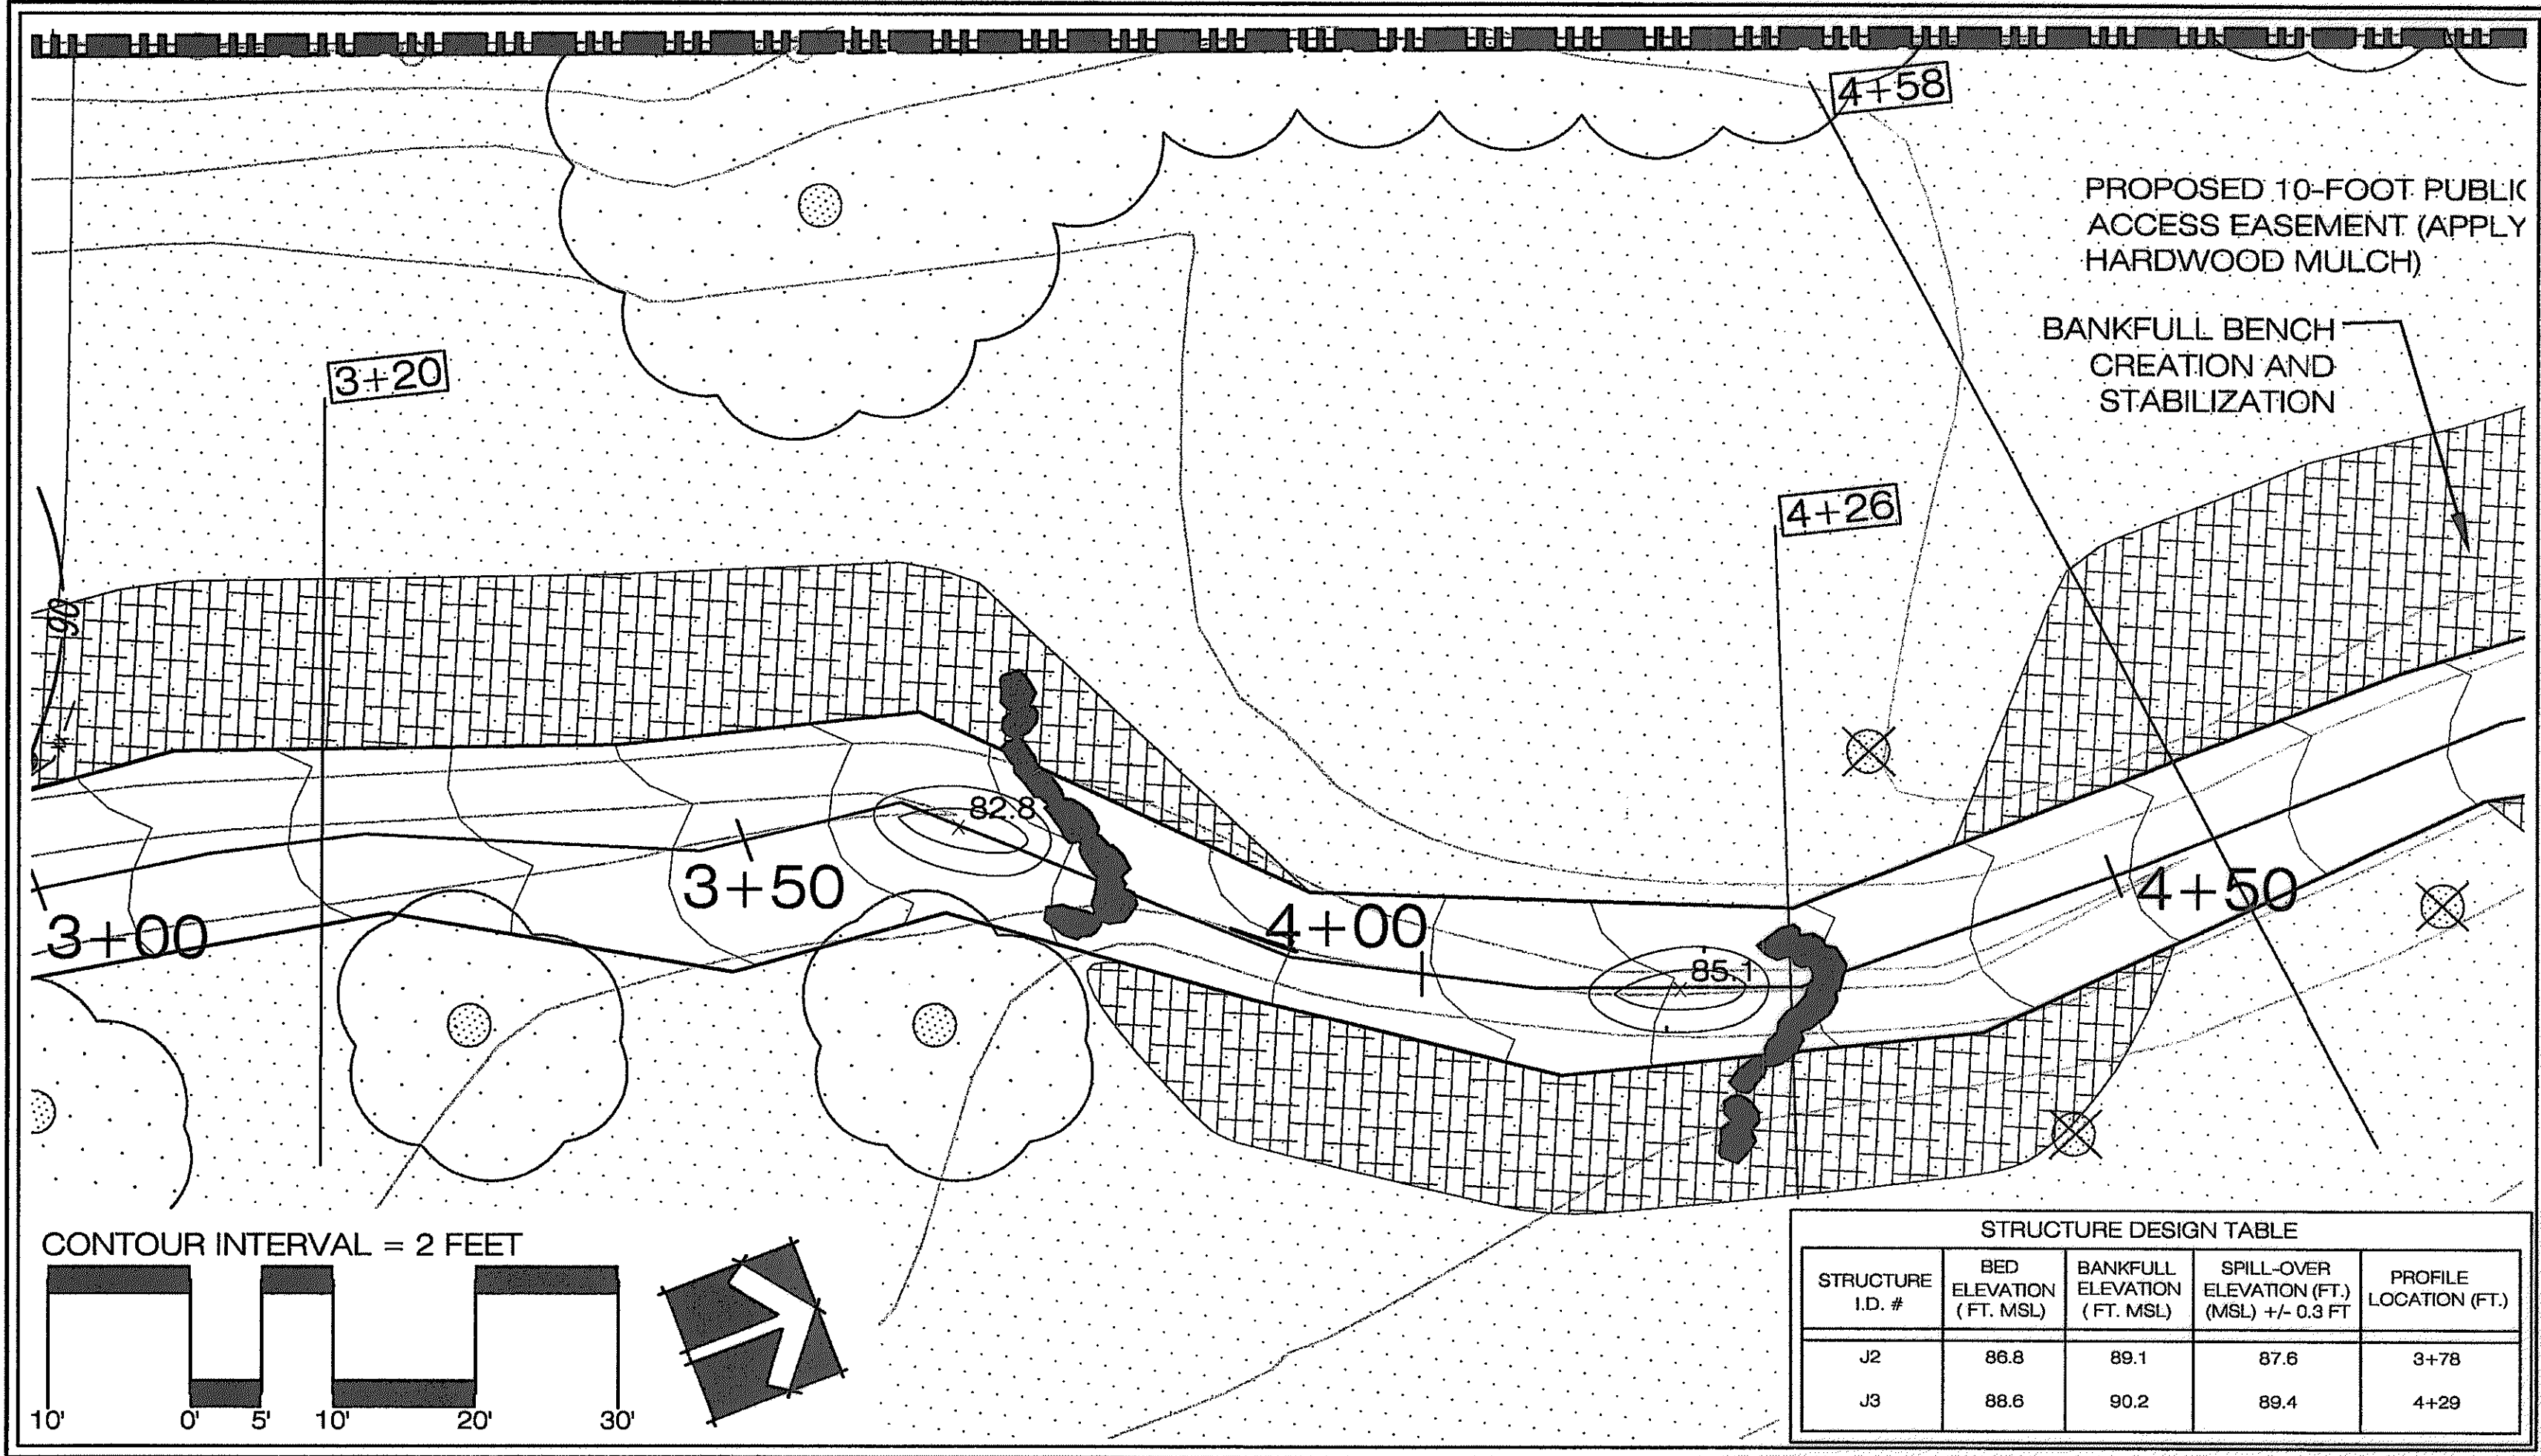

- RESTORATION AREA 2: CONSTRUCTION ACTIVITIES**
- REMOVE EXISTING CONCRETE DEBRIS
 - MANAGE NON-NATIVE VEGETATION
 - INSTALL J-HOOKS
 - CREATE AND STABILIZE BANKFULL BENCH
 - ADD SEEDING AND MATTING
 - INSTALL BANK AND BUFFER PLANTINGS

- RESTORATION AREA 2: CONSTRUCTION DETAILS**
- STATION 3+16 - 3+83: SHEET 8
- RIGHT BANKFULL BENCH CREATION AND STABILIZATION
- STATION 3+83 - 4+45: SHEET 8
- LEFT BANKFULL BENCH CREATION AND STABILIZATION
- STATION 3+78 & 4+29: SHEET 8
- J-HOOKS (2-3)
- STATION 4+45 - 4+80: SHEET 8
- RIGHT BANKFULL BENCH CREATION AND STABILIZATION

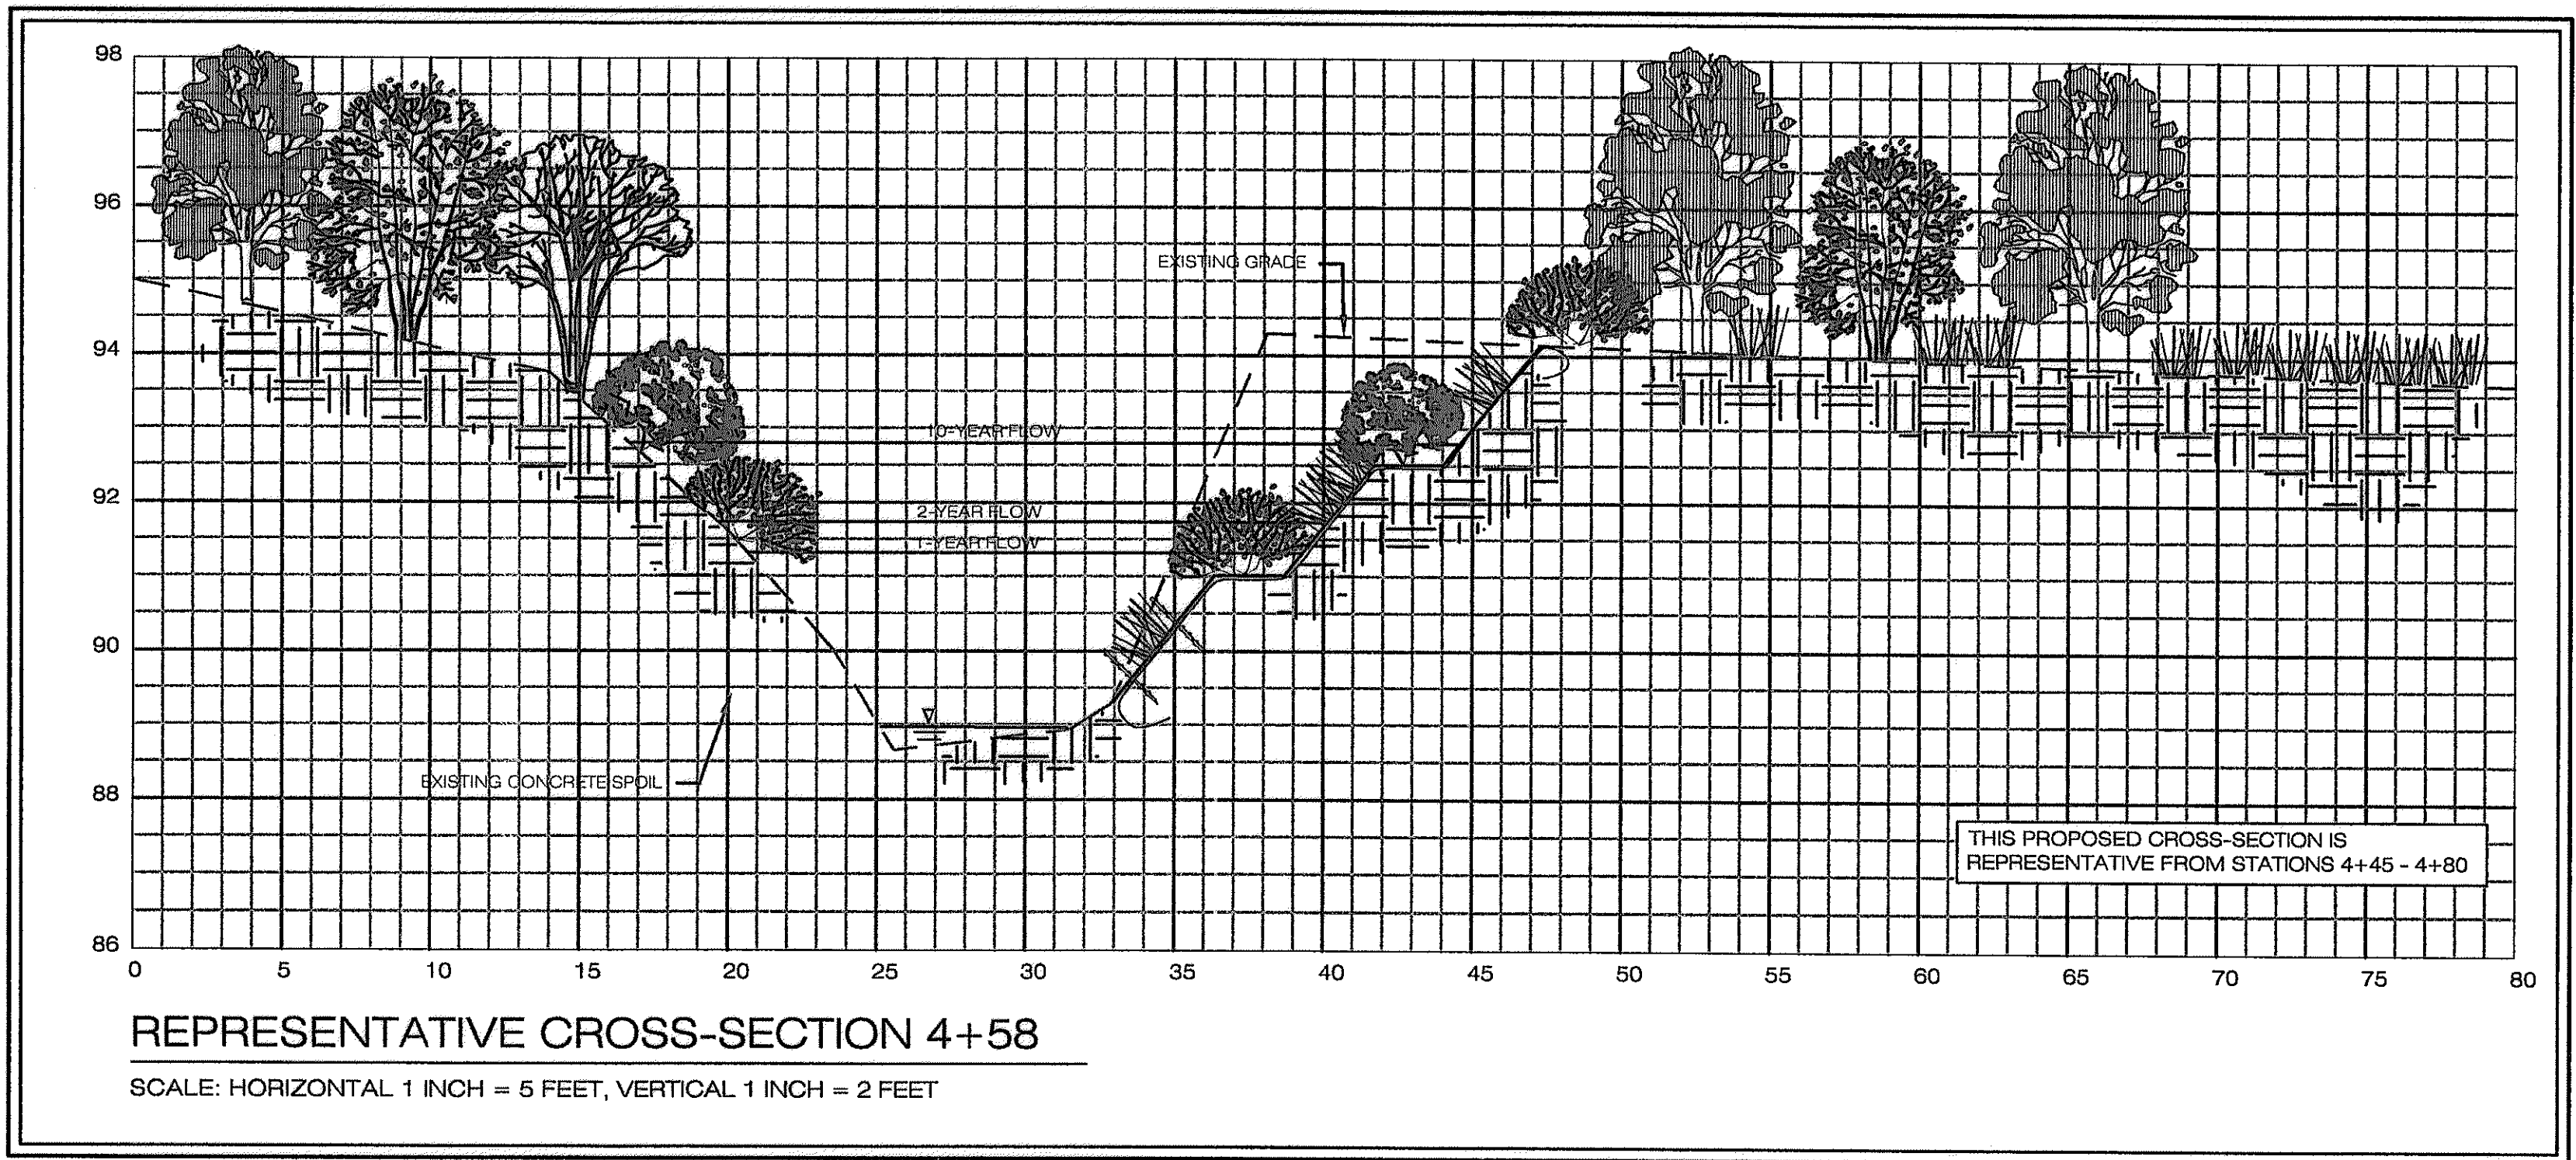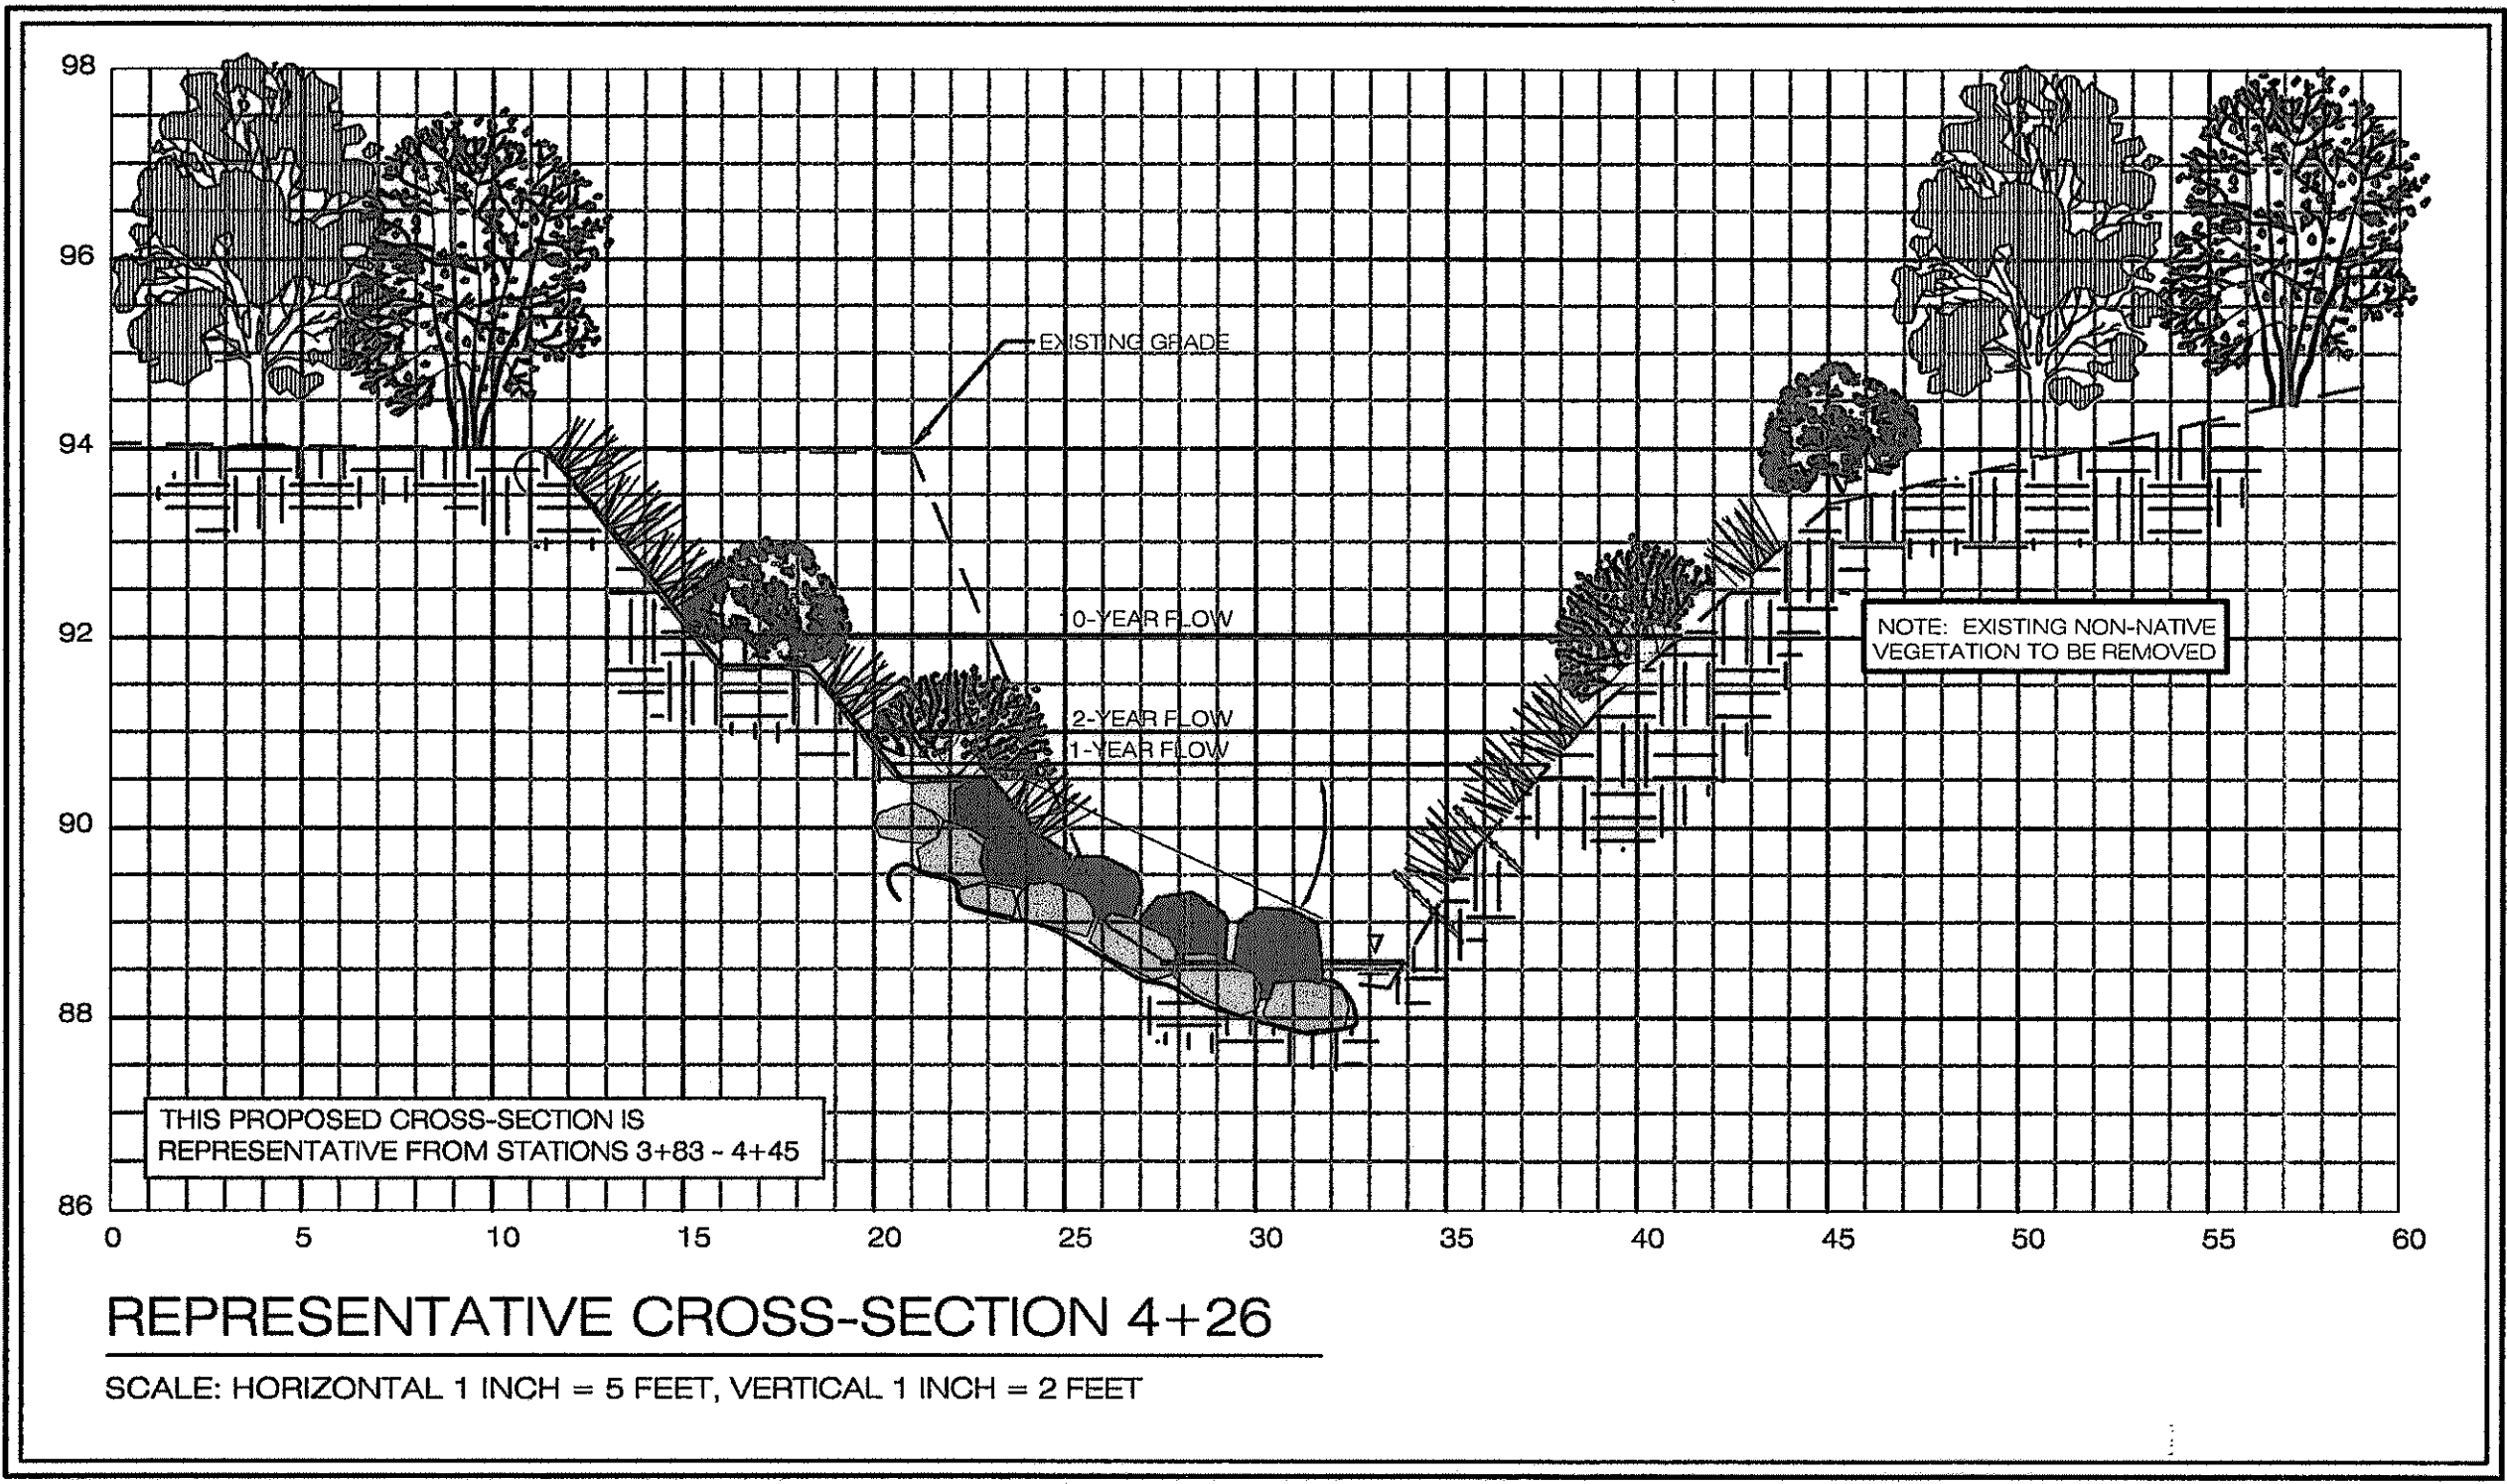

13001 Park Center Road
Williamsburg, Virginia 23188
(757) 235-0088
(757) 437-3088

5000 Center Street
Williamsburg, Virginia 23188
(757) 235-0088

7501 Bourne View Drive
Richmond, Virginia 23225
(804) 287-3474

Environmental Consultants
WILLIAMSBURG ENVIRONMENTAL GROUP, INC.

PLAN AND PROFILE: {2+56 - 4+80}

RESTORATION AREA 2

Taft Avenue

CITY OF ALEXANDRIA, VIRGINIA

COMMONWEALTH OF VIRGINIA

Jeffrey T. Hancock

JEFFREY T. HANCOCK

Lic. No. 37017

01/16/2008

PROFESSIONAL ENGINEER

REVISIONS:

DATE	DESCRIPTION
12/27/05	UPDATE LONGITUDINAL PROFILE
04/19/07	BRIDGE REVISED
08/14/07	PER 6270 CITY REVIEW LETTER

DRAWN BY: EBG/MAM

DESIGNED BY: TWCEBG/MUL

DATE: 12/27/05

CHECKED BY: TWCE/ETH

SHEET: **6**

JOB#: 2256

APPROVED

SPECIAL USE PERMIT NO. 2007-009

DEPARTMENT OF PLANNING & ZONING

Shirley Ann 2/4/08

DIRECTOR DATE

DEPARTMENT OF TRANSPORTATION

ENVIRONMENTAL SERVICES

SITE PLAN NO. 2007-0019

Mark 2/1/08

DIRECTOR DATE


CITY OF ALEXANDRIA

DATE RECORDED


INSTRUMENT NO. DEED BOOK NO. PAGE NO.

V:\22009\2256 - TaftStream Restoration\Construction Plans 10-10-07.dwg

V:\2200s\2256 - TaftStream Restoration\Construction Plans 10-10-07.dwg

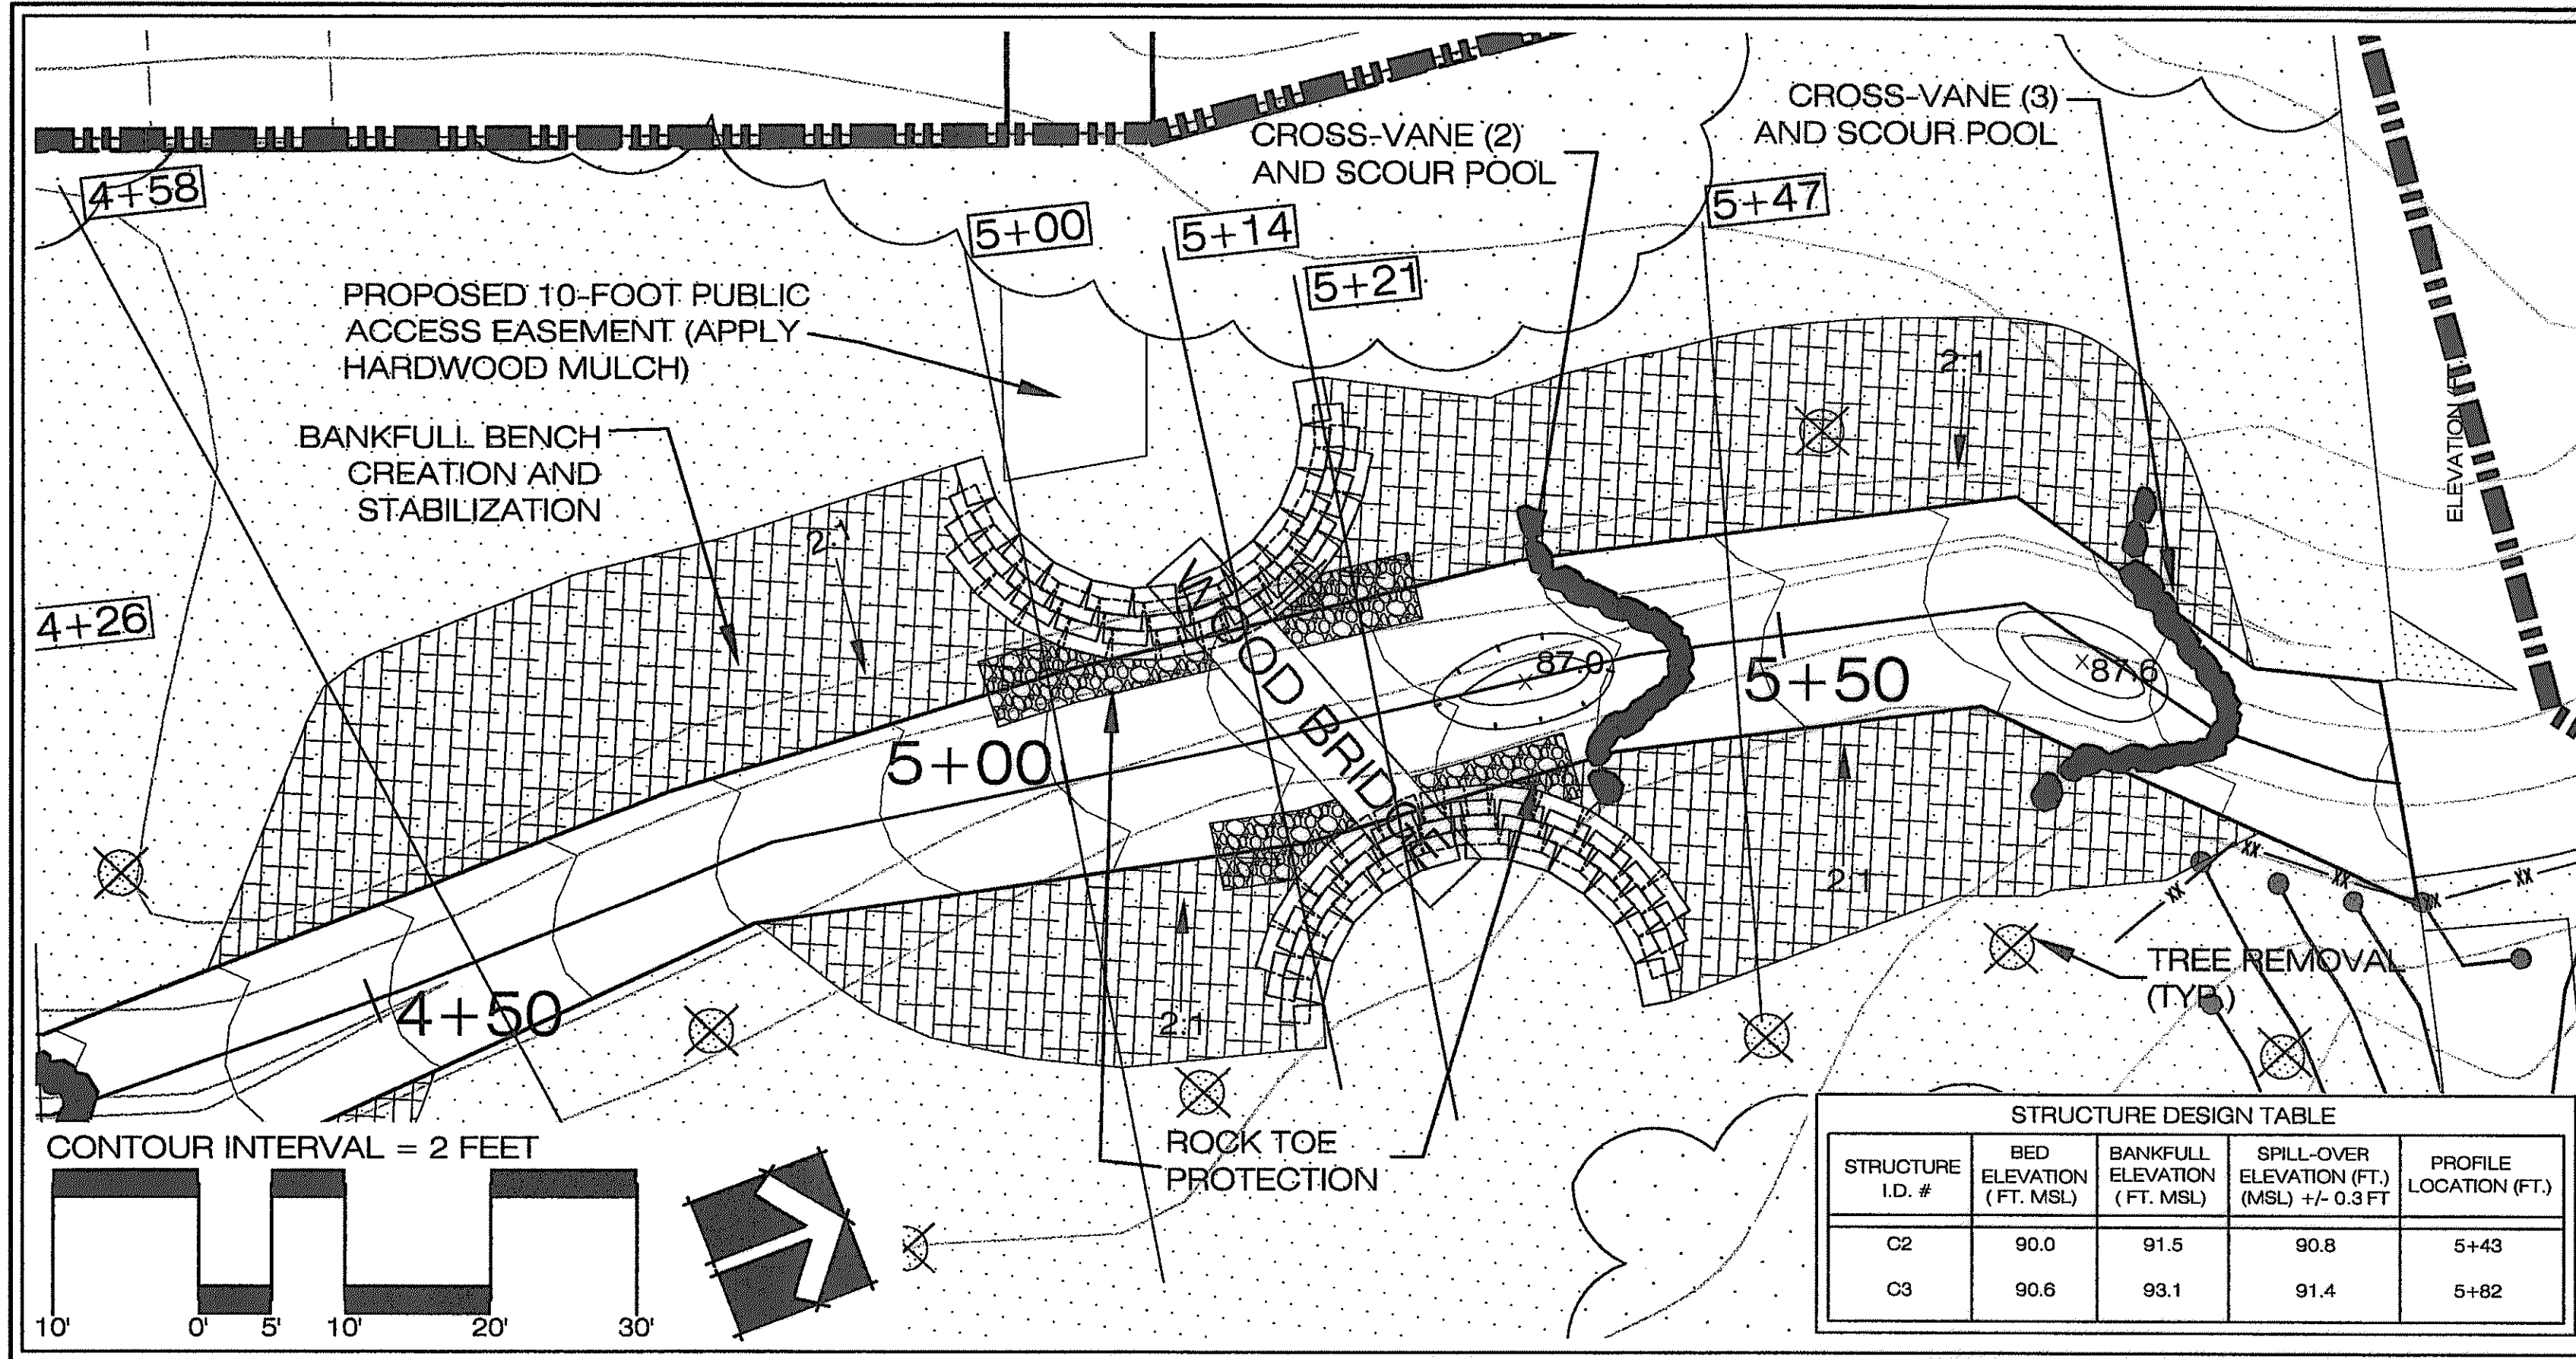

STRUCTURE DESIGN TABLE				
STRUCTURE I.D. #	BED ELEVATION (FT. MSL)	BANKFULL ELEVATION (FT. MSL)	SPILL-OVER ELEVATION (FT.) (MSL) +/- 0.3 FT	PROFILE LOCATION (FT.)
C2	90.0	91.5	90.8	5+43
C3	90.6	93.1	91.4	5+82

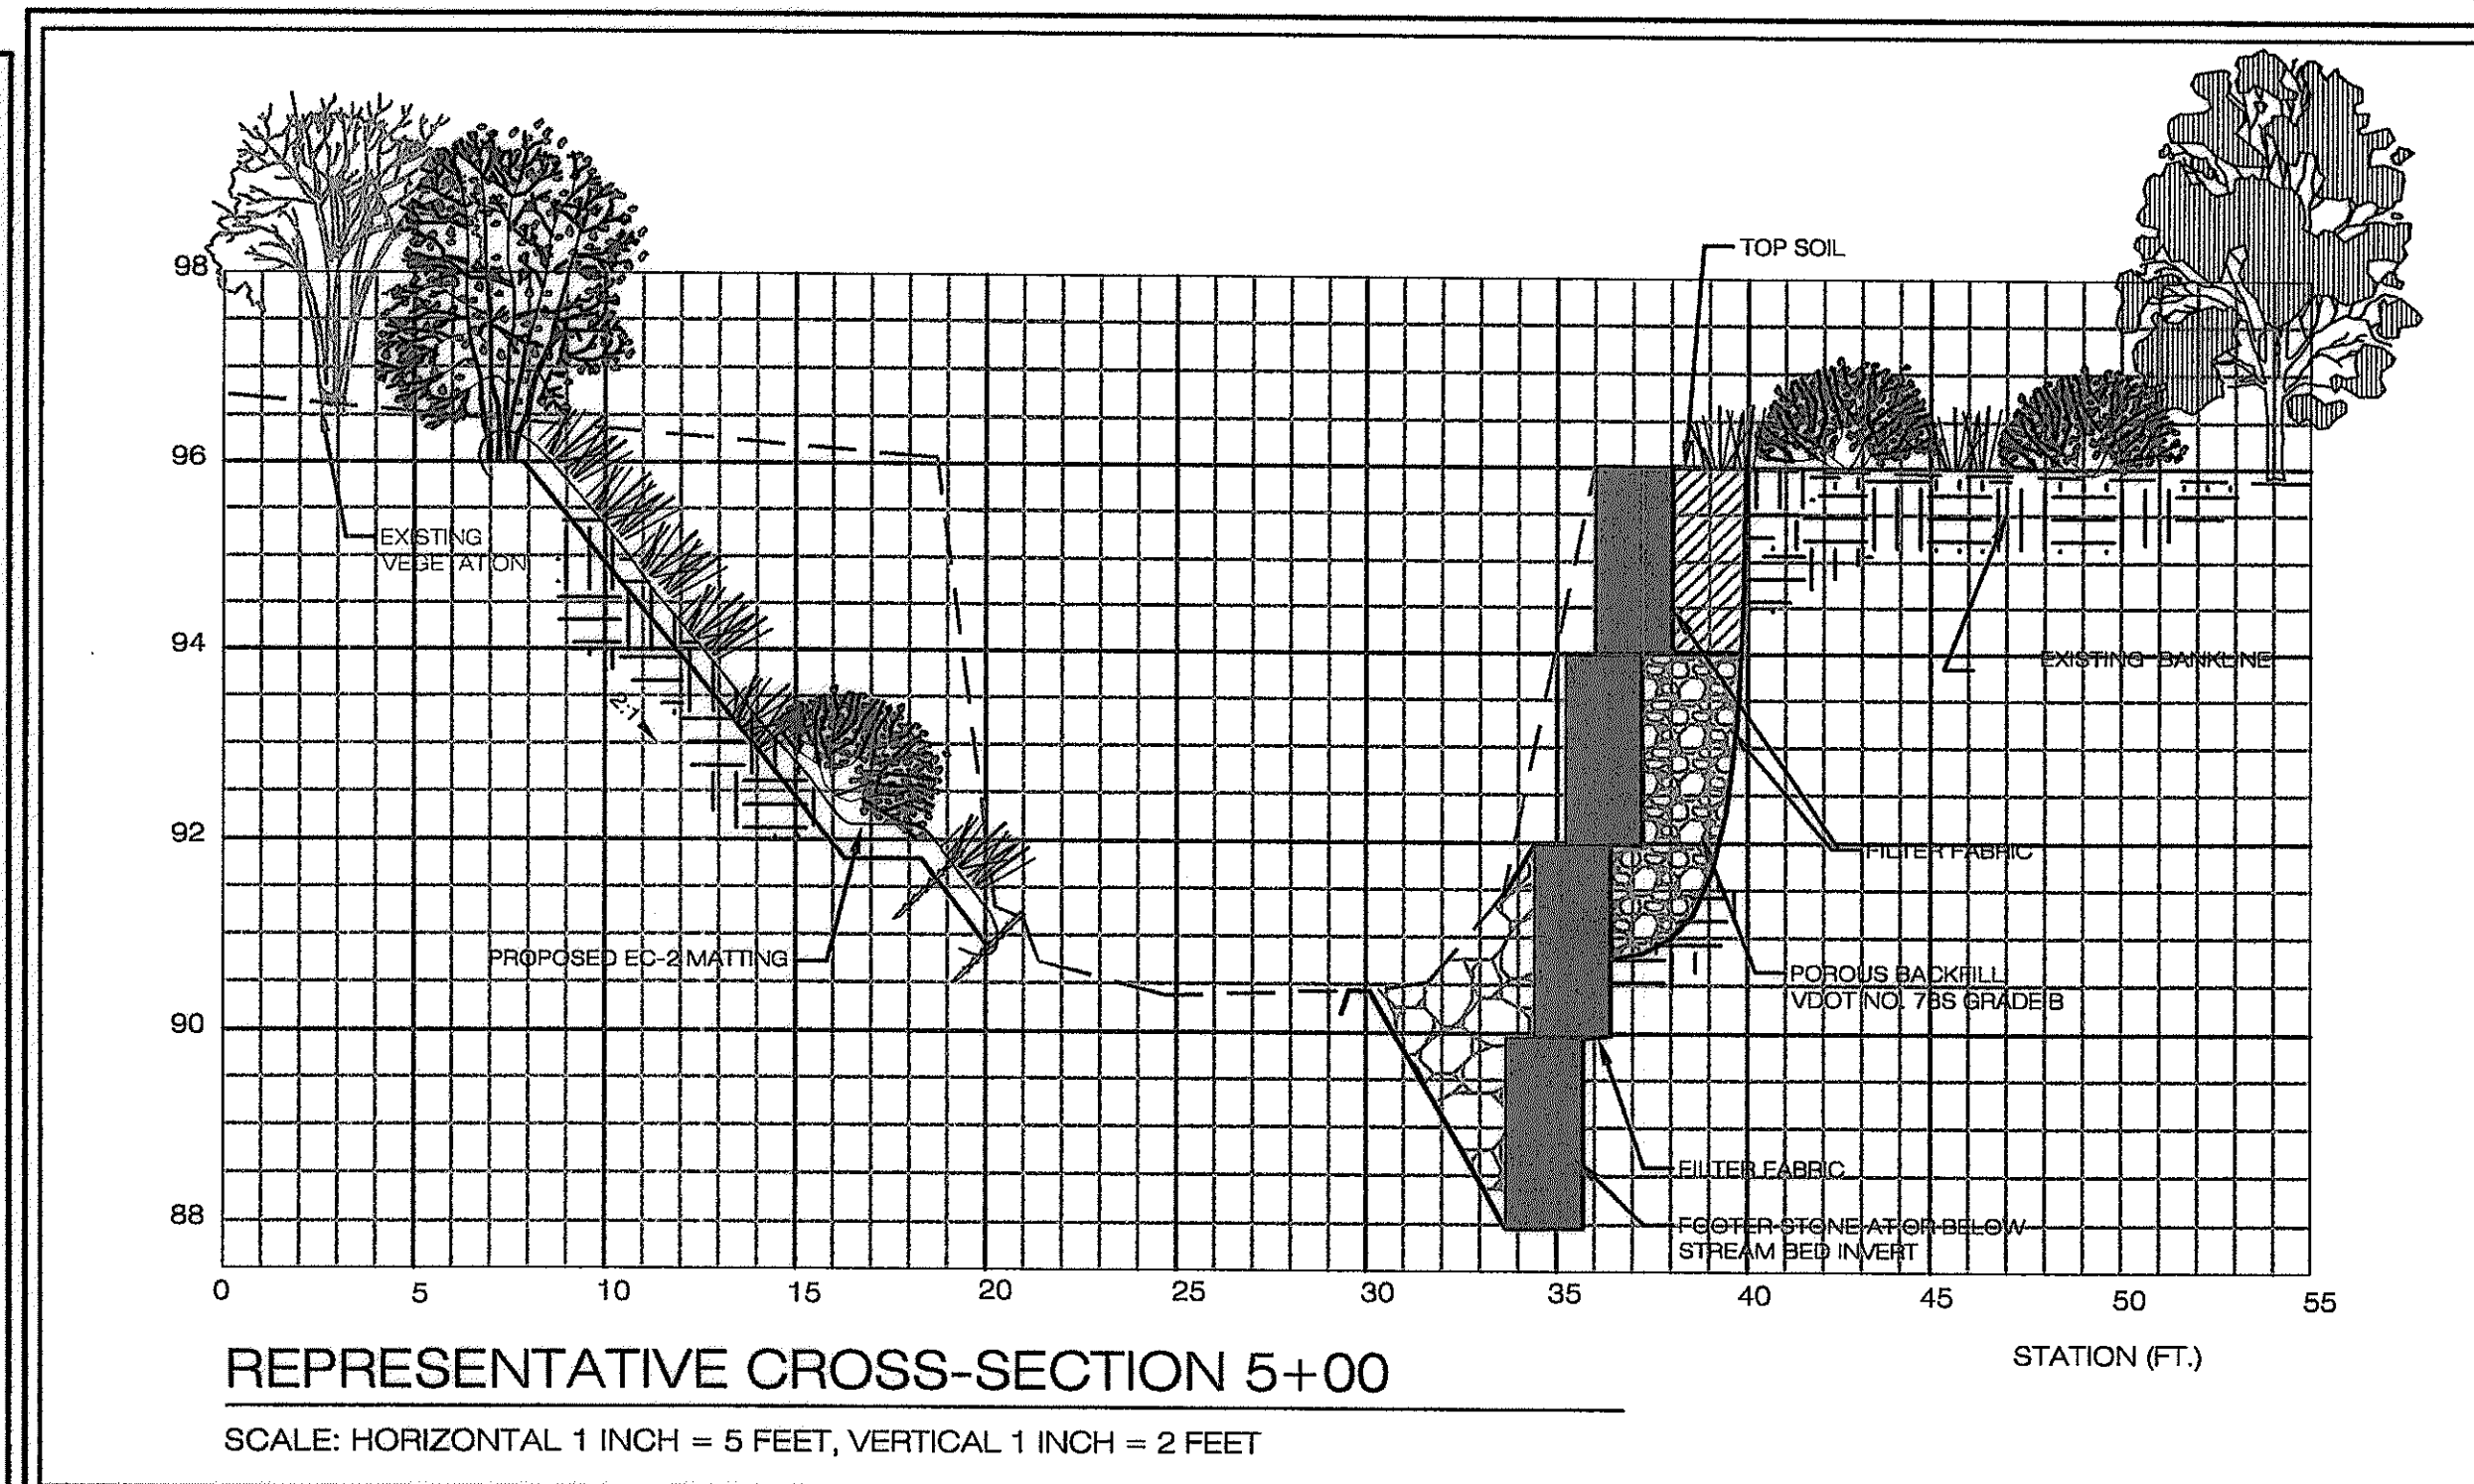

REPRESENTATIVE CROSS-SECTION 5+00
SCALE: HORIZONTAL 1 INCH = 5 FEET, VERTICAL 1 INCH = 2 FEET

RESTORATION AREA 3: CONSTRUCTION ACTIVITIES

- REMOVE EXISTING CONCRETE DEBRIS
- STABILIZE WOOD BRIDGE
- PROVIDE ROCK STABILIZATION AND ROCK-TOE PROTECTION
- INSTALL CROSS-VANES (2 AND 3)
- CREATE AND STABILIZE BANKFULL BENCH
- ADD SEEDING AND MATTING
- INSTALL BANK AND BUFFER PLANTINGS

RESTORATION AREA 3: CONSTRUCTION DETAILS

STATION 4+80 - 4+96: SHEET 8
- RIGHT BANKFULL BENCH CREATION AND STABILIZATION

STATION 4+80 - 5+10: SHEET 8
- LEFT BANKFULL BENCH CREATION AND STABILIZATION

STATION 4+96 - 5+23:
- RIGHT ROCK-TOE PROTECTION AND STACKED STONE WALL

STATION 5+10 - 5+44: SHEETS 8
- LEFT ROCK-TOE PROTECTION AND STACKED STONE WALL


STATION 5+23 - 5+86: SHEET 8
- RIGHT AND LEFT BANKFULL BENCH CREATION AND STABILIZATION

STATION 5+43: SHEET 8
- CROSS-VANE (2)


STATION 5+82: SHEET 8
- CROSS-VANE (3)

WSE WATER SURFACE ELEVATION (1-YEAR STORM)


WSE WATER SURFACE ELEVATION (9/14/05)

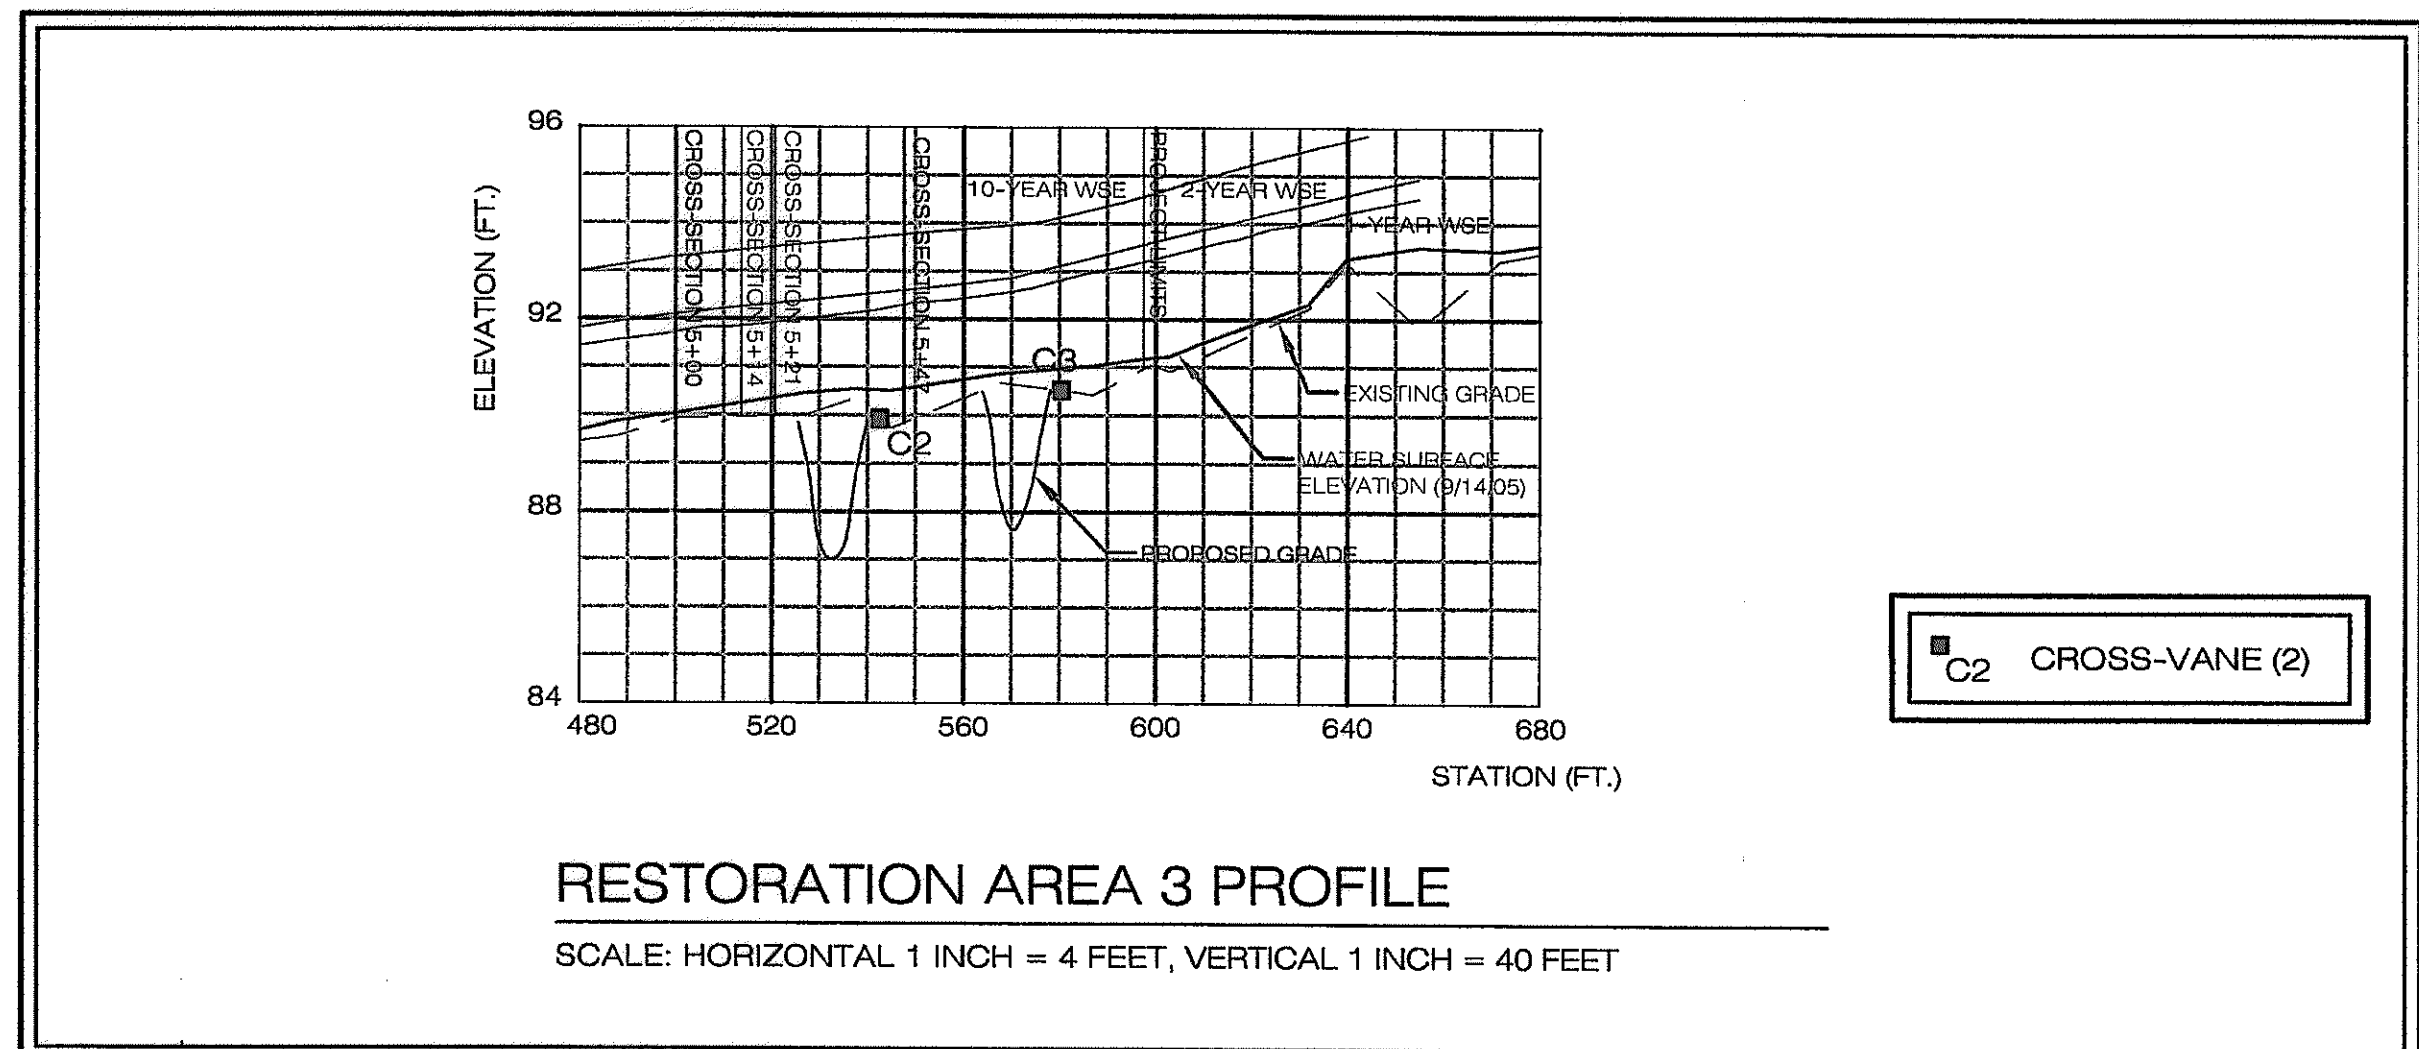

RESTORATION AREA 3 PROFILE
SCALE: HORIZONTAL 1 INCH = 4 FEET, VERTICAL 1 INCH = 40 FEET

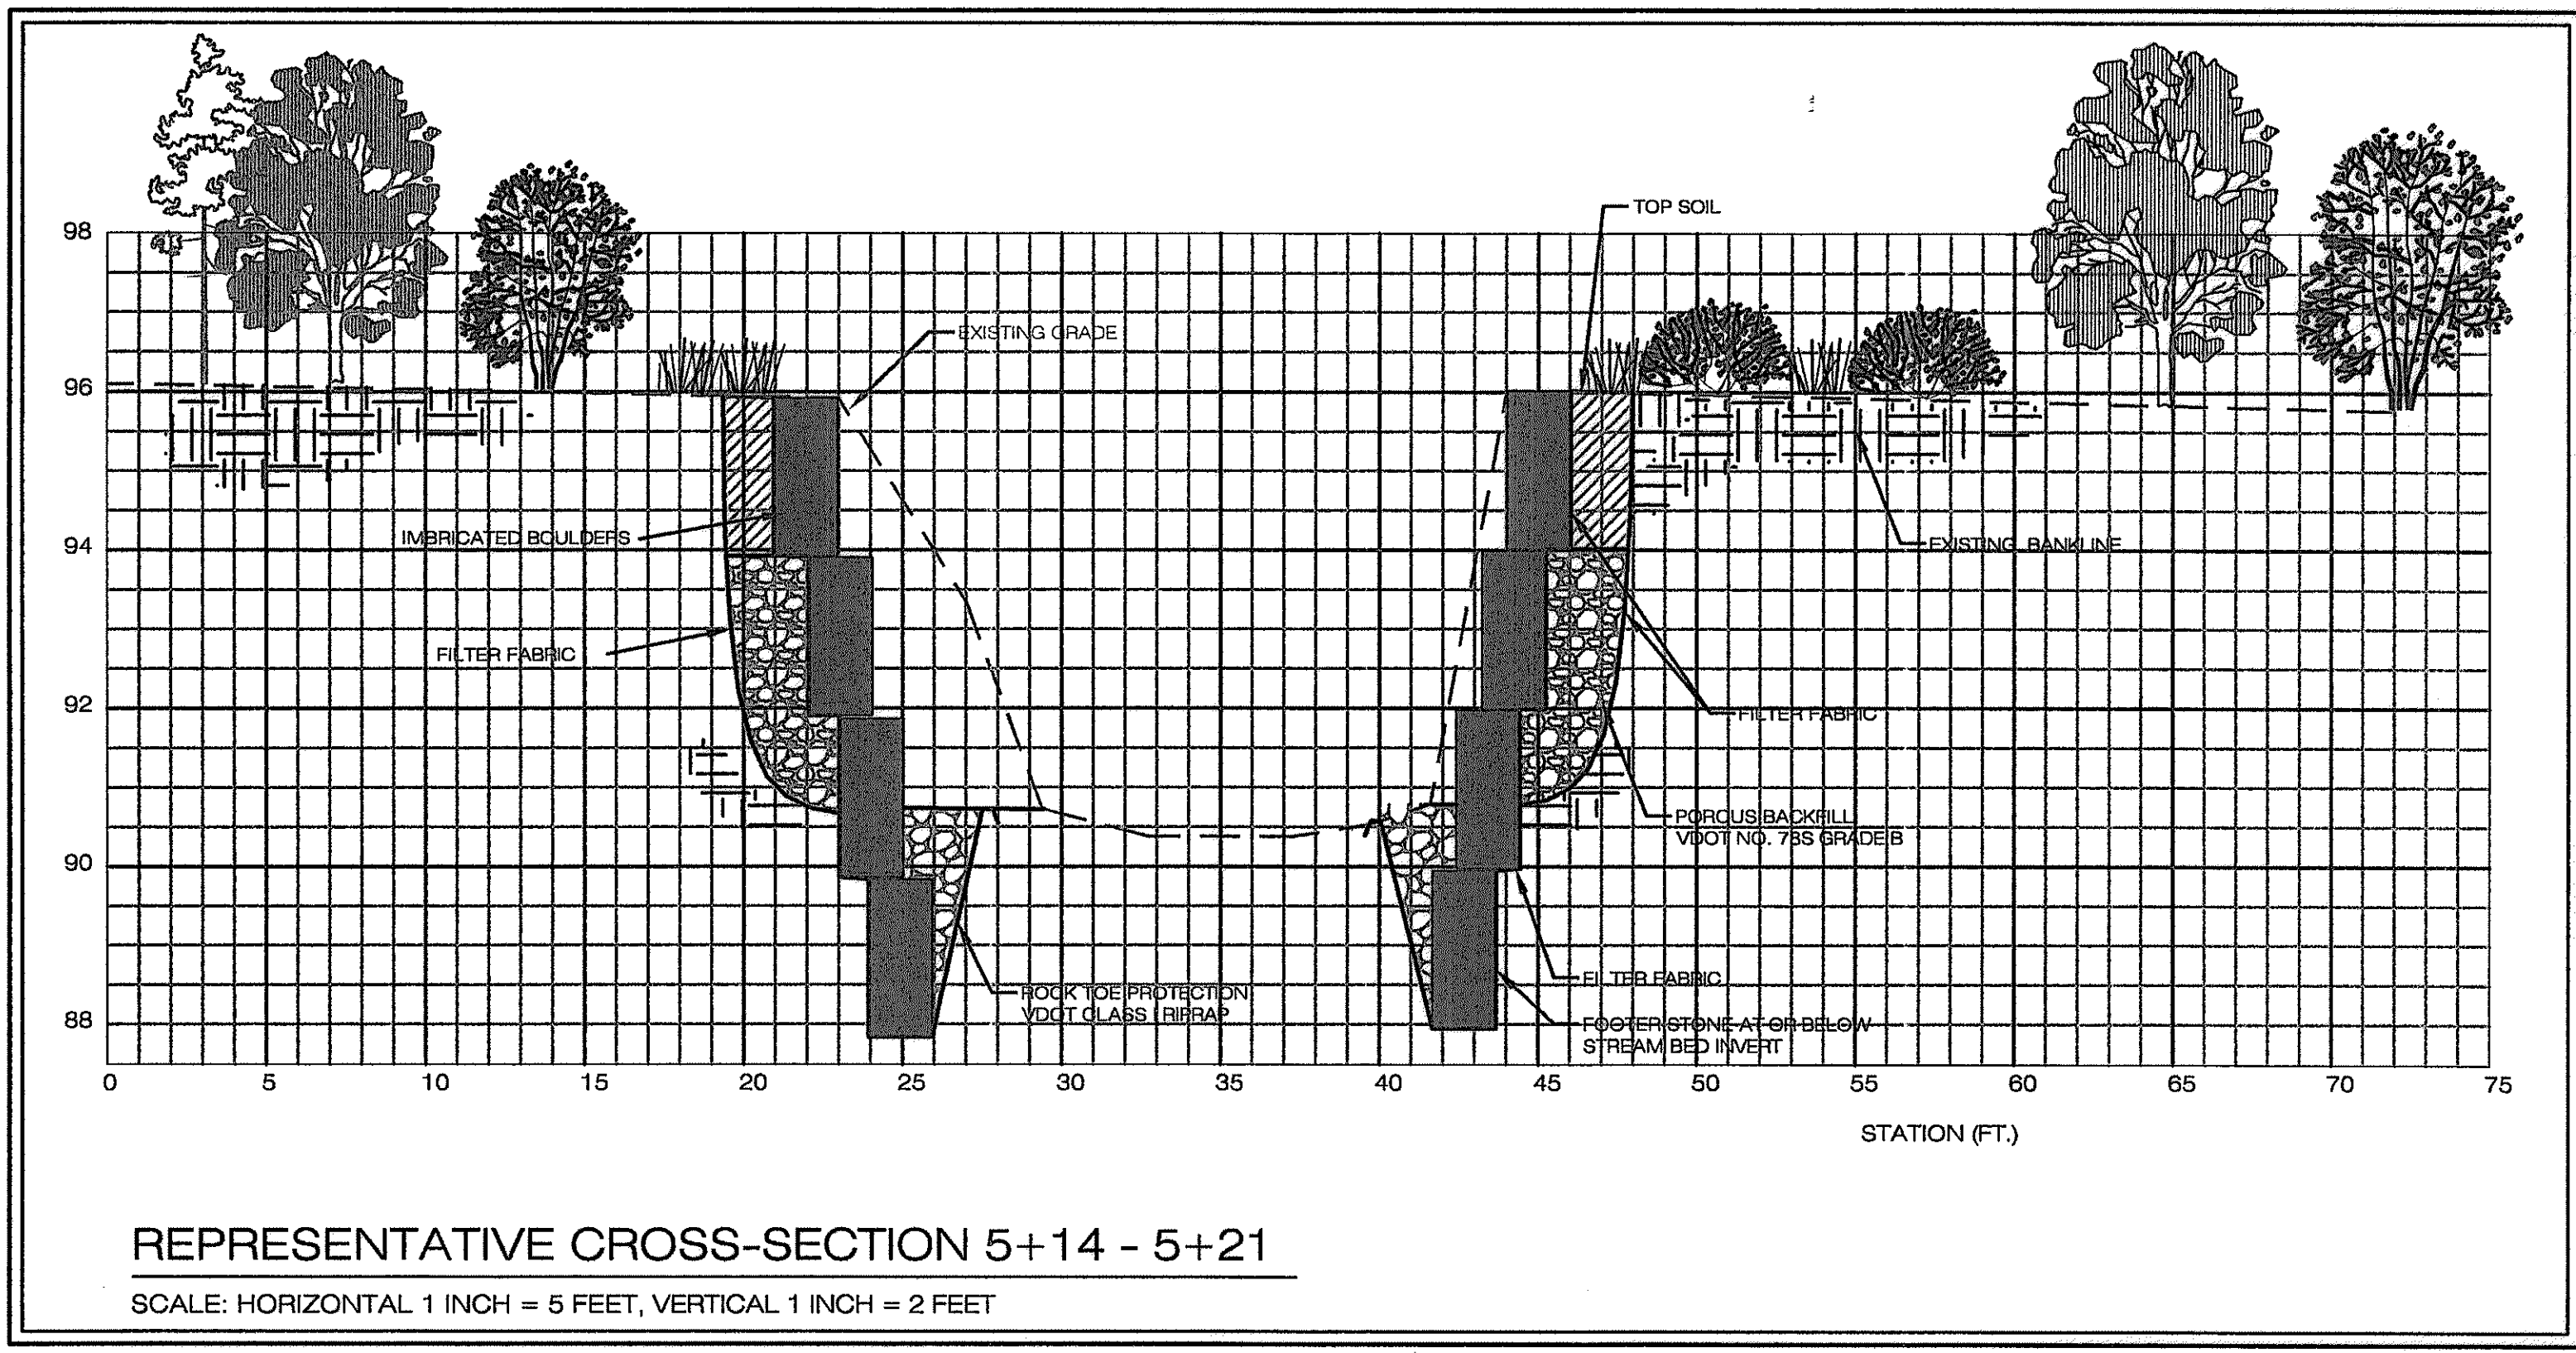

REPRESENTATIVE CROSS-SECTION 5+14 - 5+21
SCALE: HORIZONTAL 1 INCH = 5 FEET, VERTICAL 1 INCH = 2 FEET

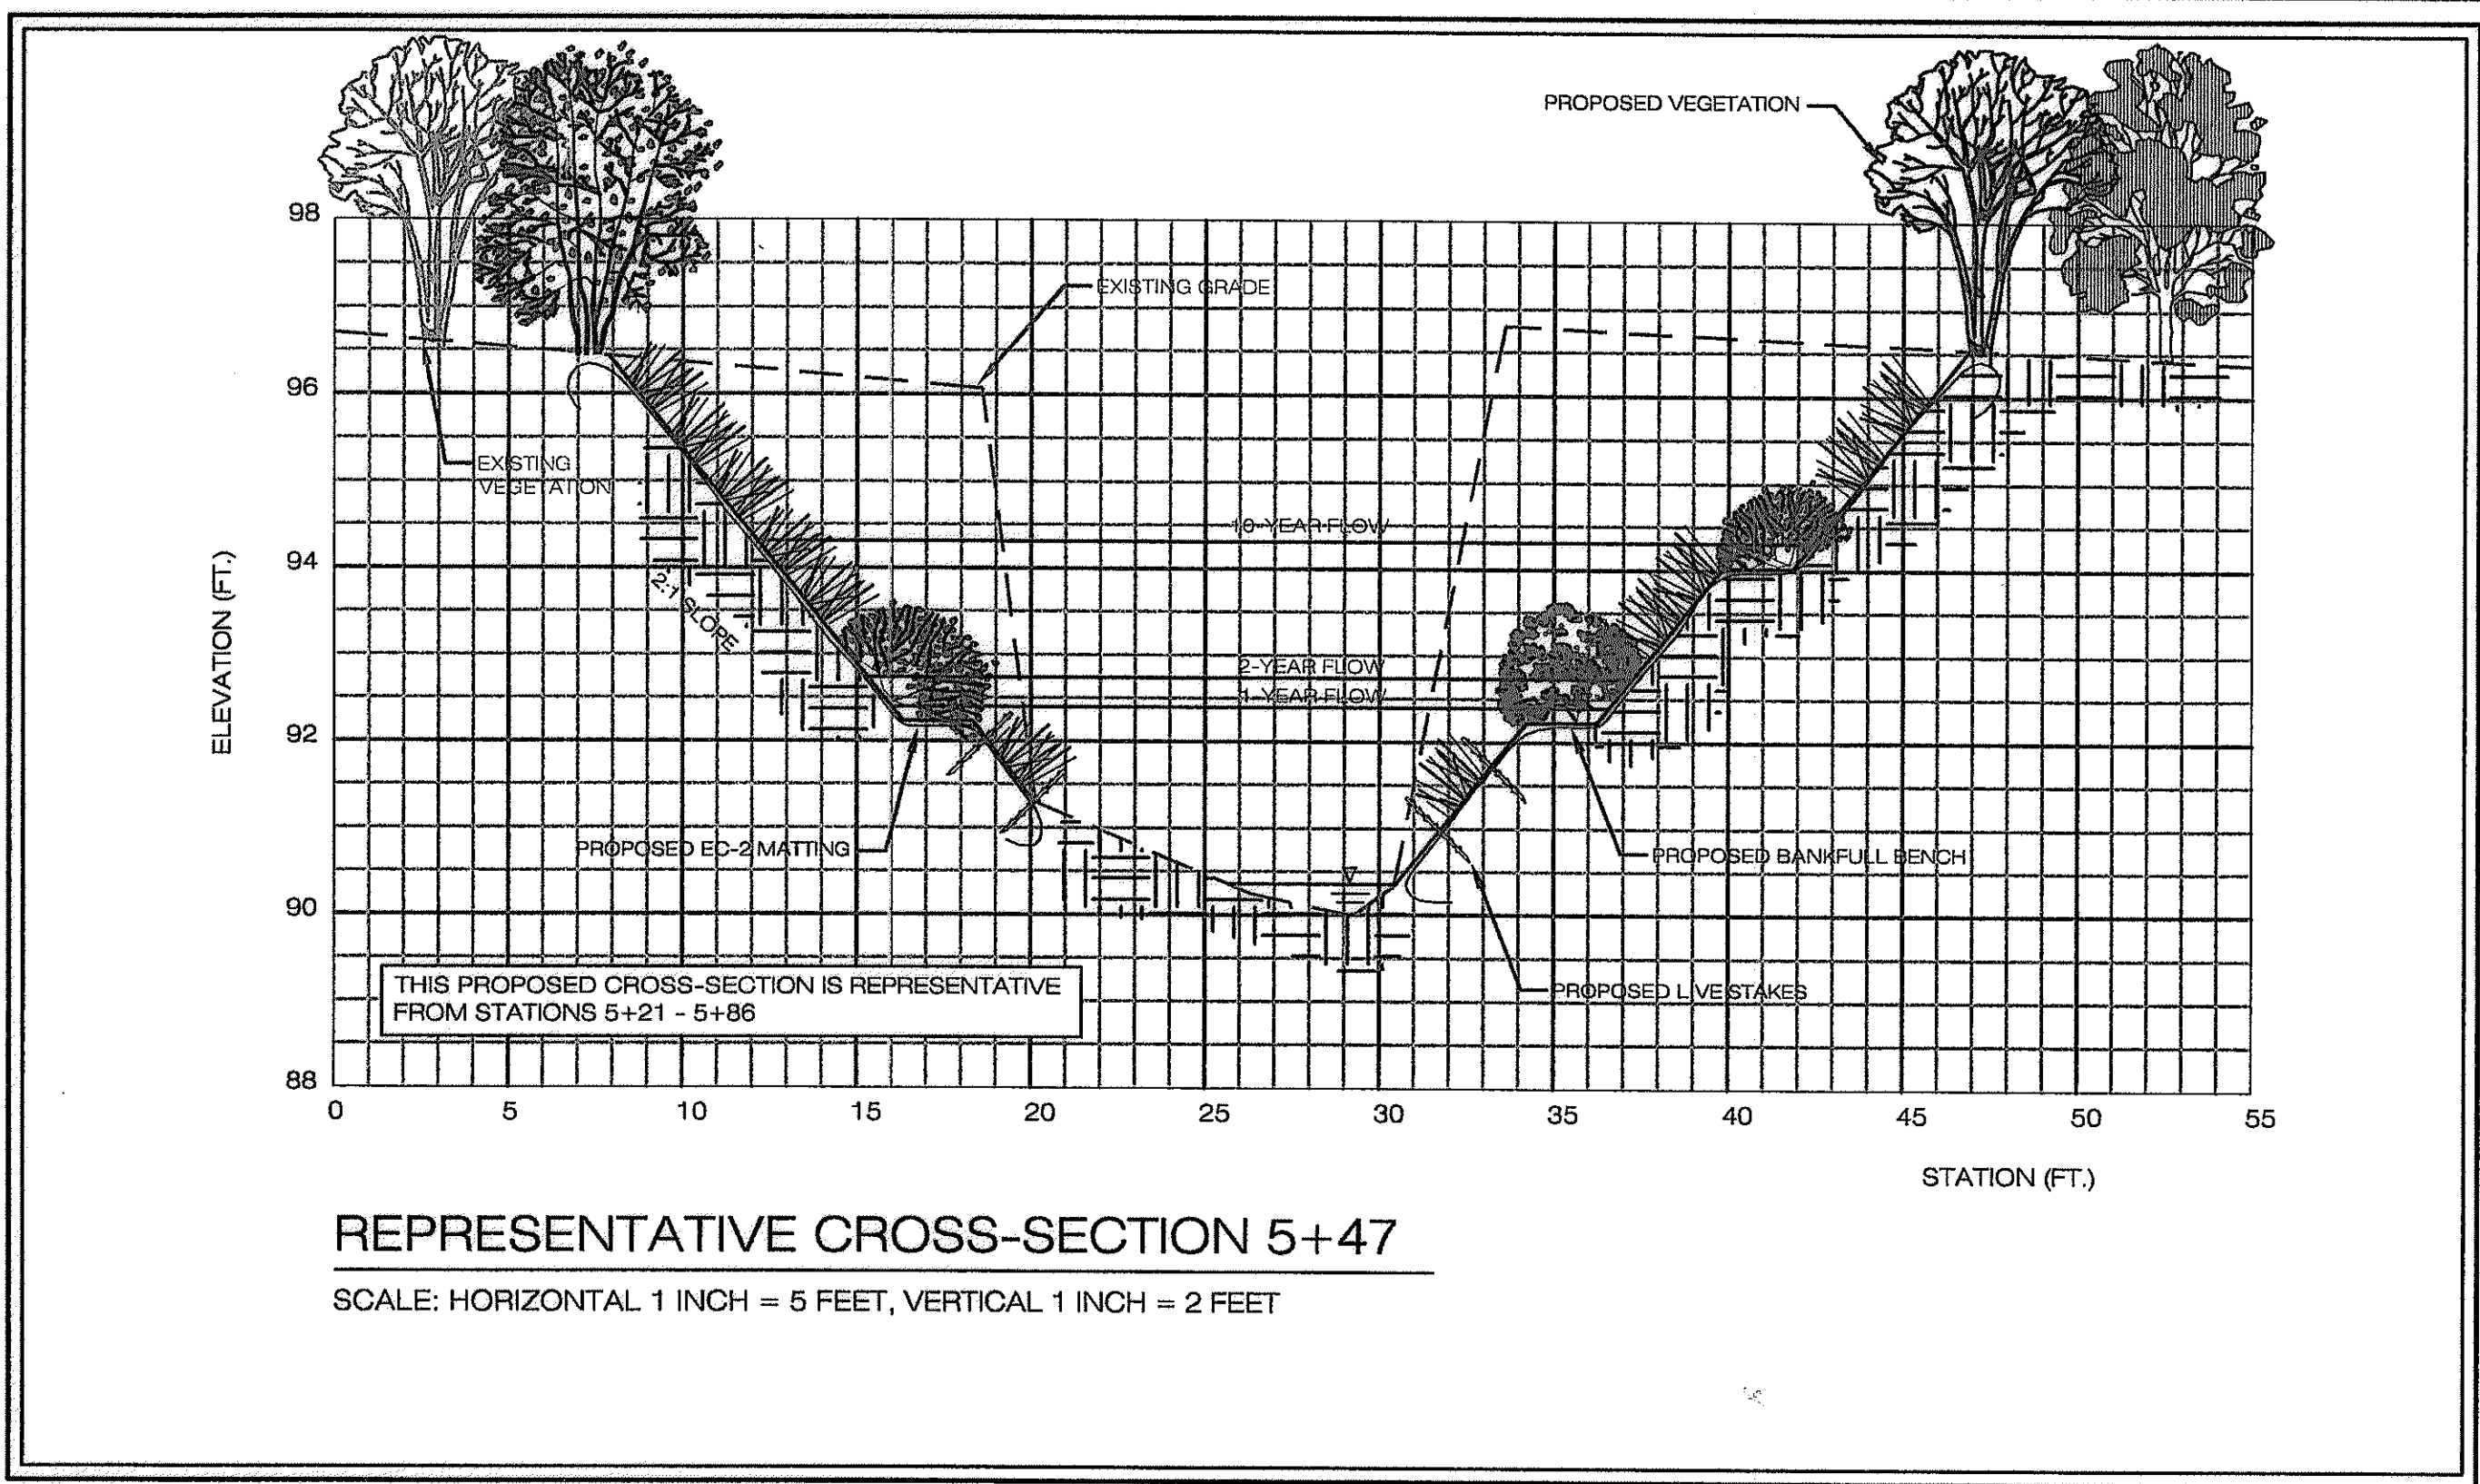

REPRESENTATIVE CROSS-SECTION 5+47
SCALE: HORIZONTAL 1 INCH = 5 FEET, VERTICAL 1 INCH = 2 FEET

13021 Pitts Creek Road
Williamsburg, Virginia 23188
(757) 235-0888
(757) 437-3289

7001 Boulevard View Drive
Suite 205
Williamsburg, Virginia 23205
(800) 287-8474

Environmental Consultants
WEG
WILLIAMSBURG ENVIRONMENTAL GROUP, INC.

PLAN AND PROFILE: {4+80 - 5+86}
RESTORATION AREA 3
TAFT AVENUE
CITY OF ALEXANDRIA, VIRGINIA

COMMONWEALTH OF VIRGINIA
Professional Engineer
HENRY T. HANCOCK
Lic. No. 37017
01/16/2008

REVISIONS:	DATE:
12/8/05 UPDATED LONGITUDINAL PROFILE	
12/8/05 REMOVED BRIDGE EXTENSION	
BANKFULL BENCH	
04/12/07 BROKE THE PAVED	
08/05/07 FIRST CITY OF ALEXANDRIA YEAR	
10/11/07 FEB 01/07 CITY REVIEW LETTER	







DRAWN BY: EBG/MAM
DESIGNED BY: TWCEB/MUL
DATE: 12/27/05
CHECKED BY: TW/CUTH

SHEET: **7**
JOB#: 2256

APPROVED
SPECIAL USE PERMIT NO. 2007-009
DEPARTMENT OF PLANNING & ZONING
DIRECTOR
DATE: 2/4/08

DEPARTMENT OF TRANSPORTATION
& ENVIRONMENTAL SERVICES
SITE PLAN NO. 2007-0018
CHAIRMAN, PLANNING COMMISSION
DATE: 2/1/08

DATE RECORDED: _____
INSTRUMENT NO. _____ DEED BOOK NO. _____ PAGE NO. _____

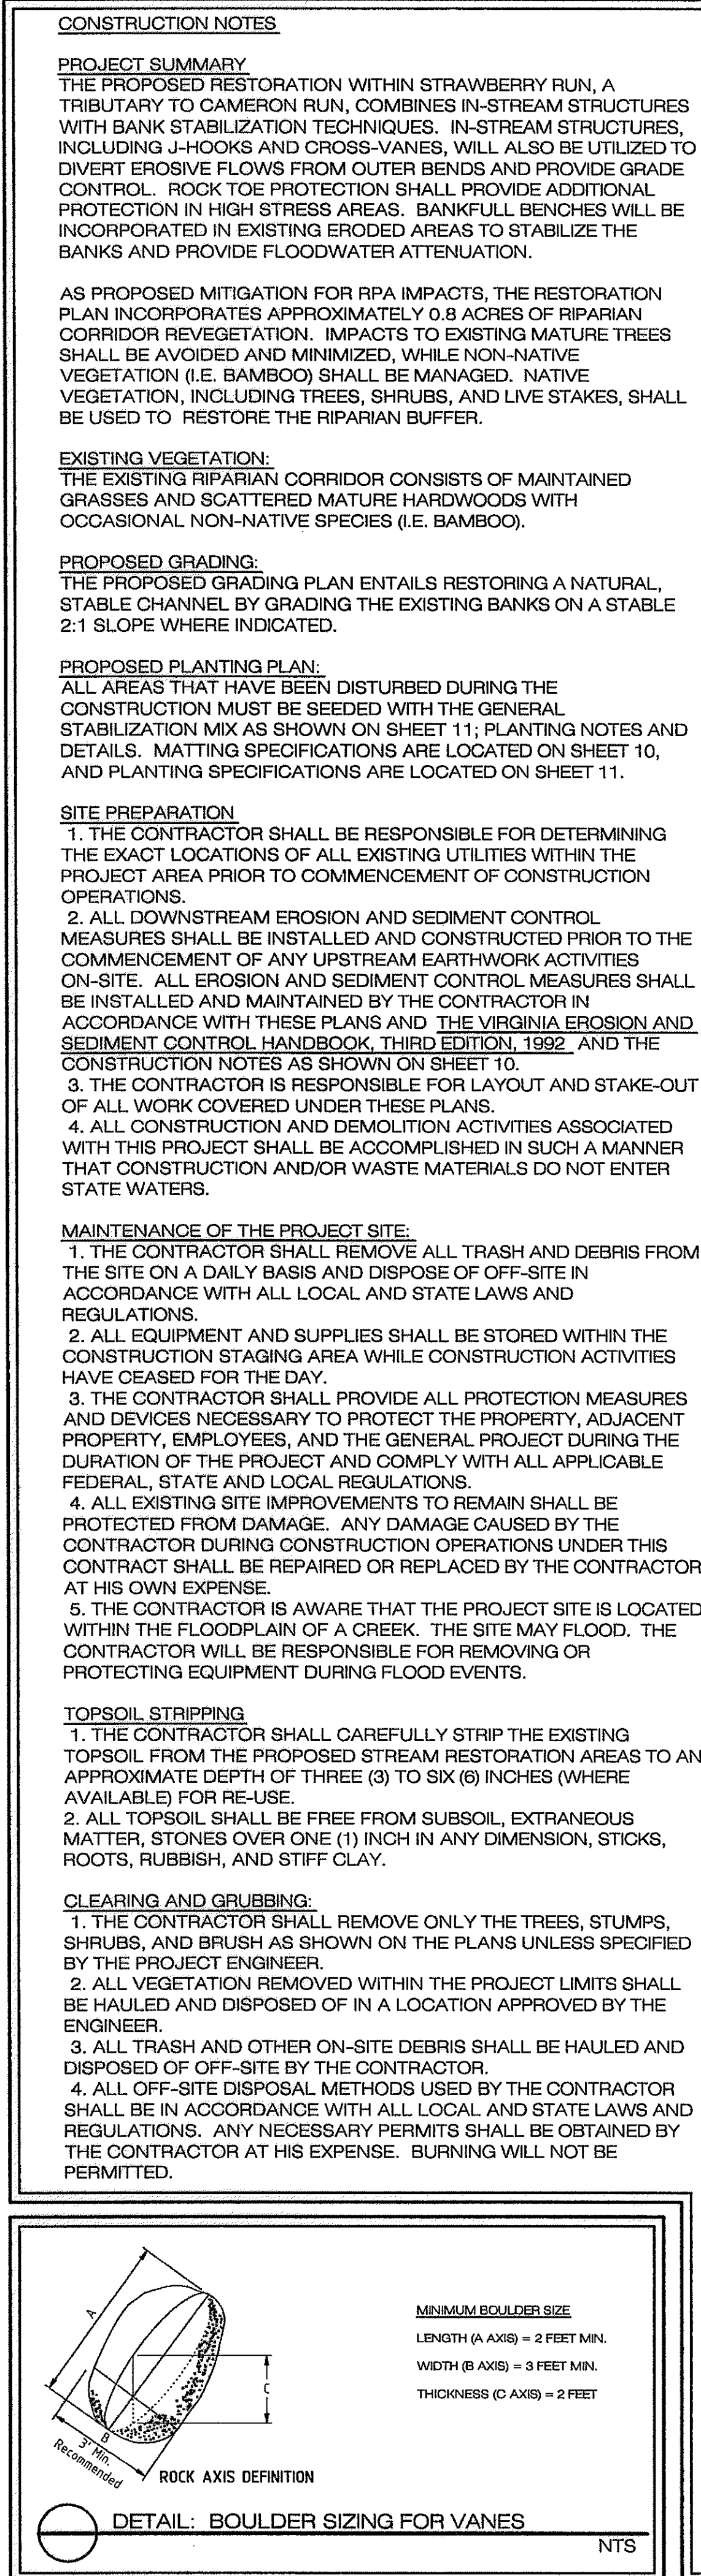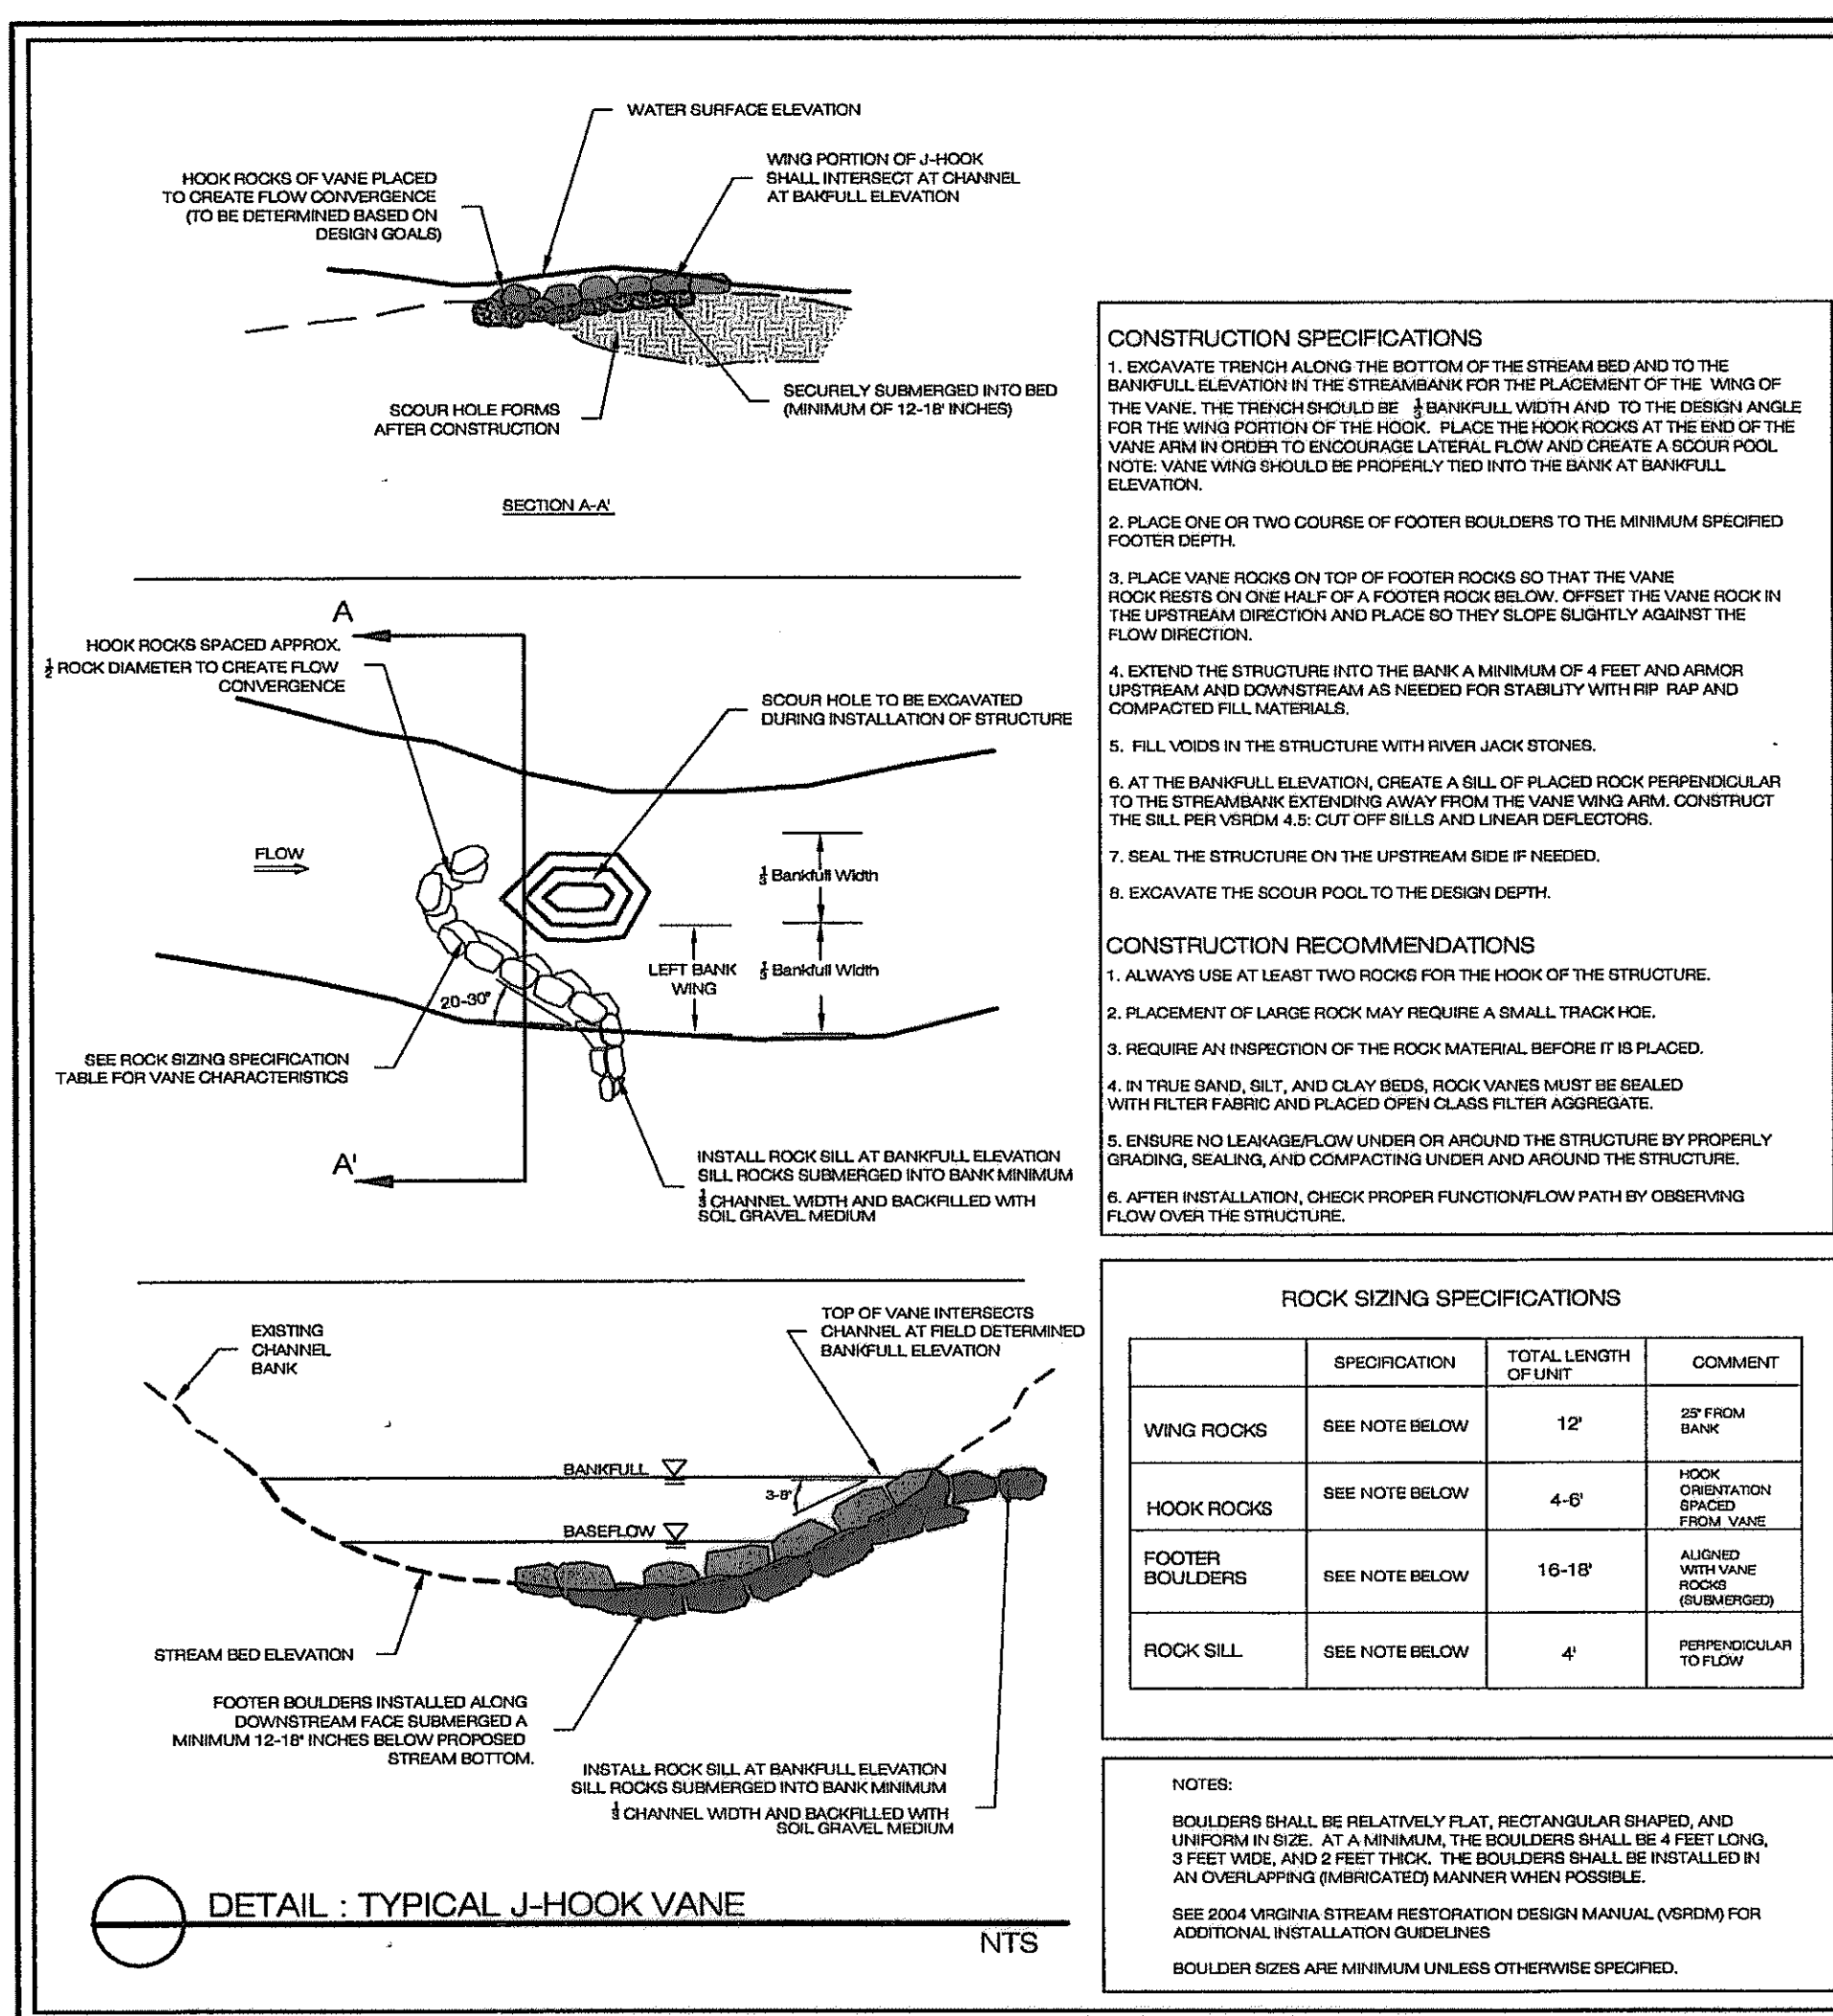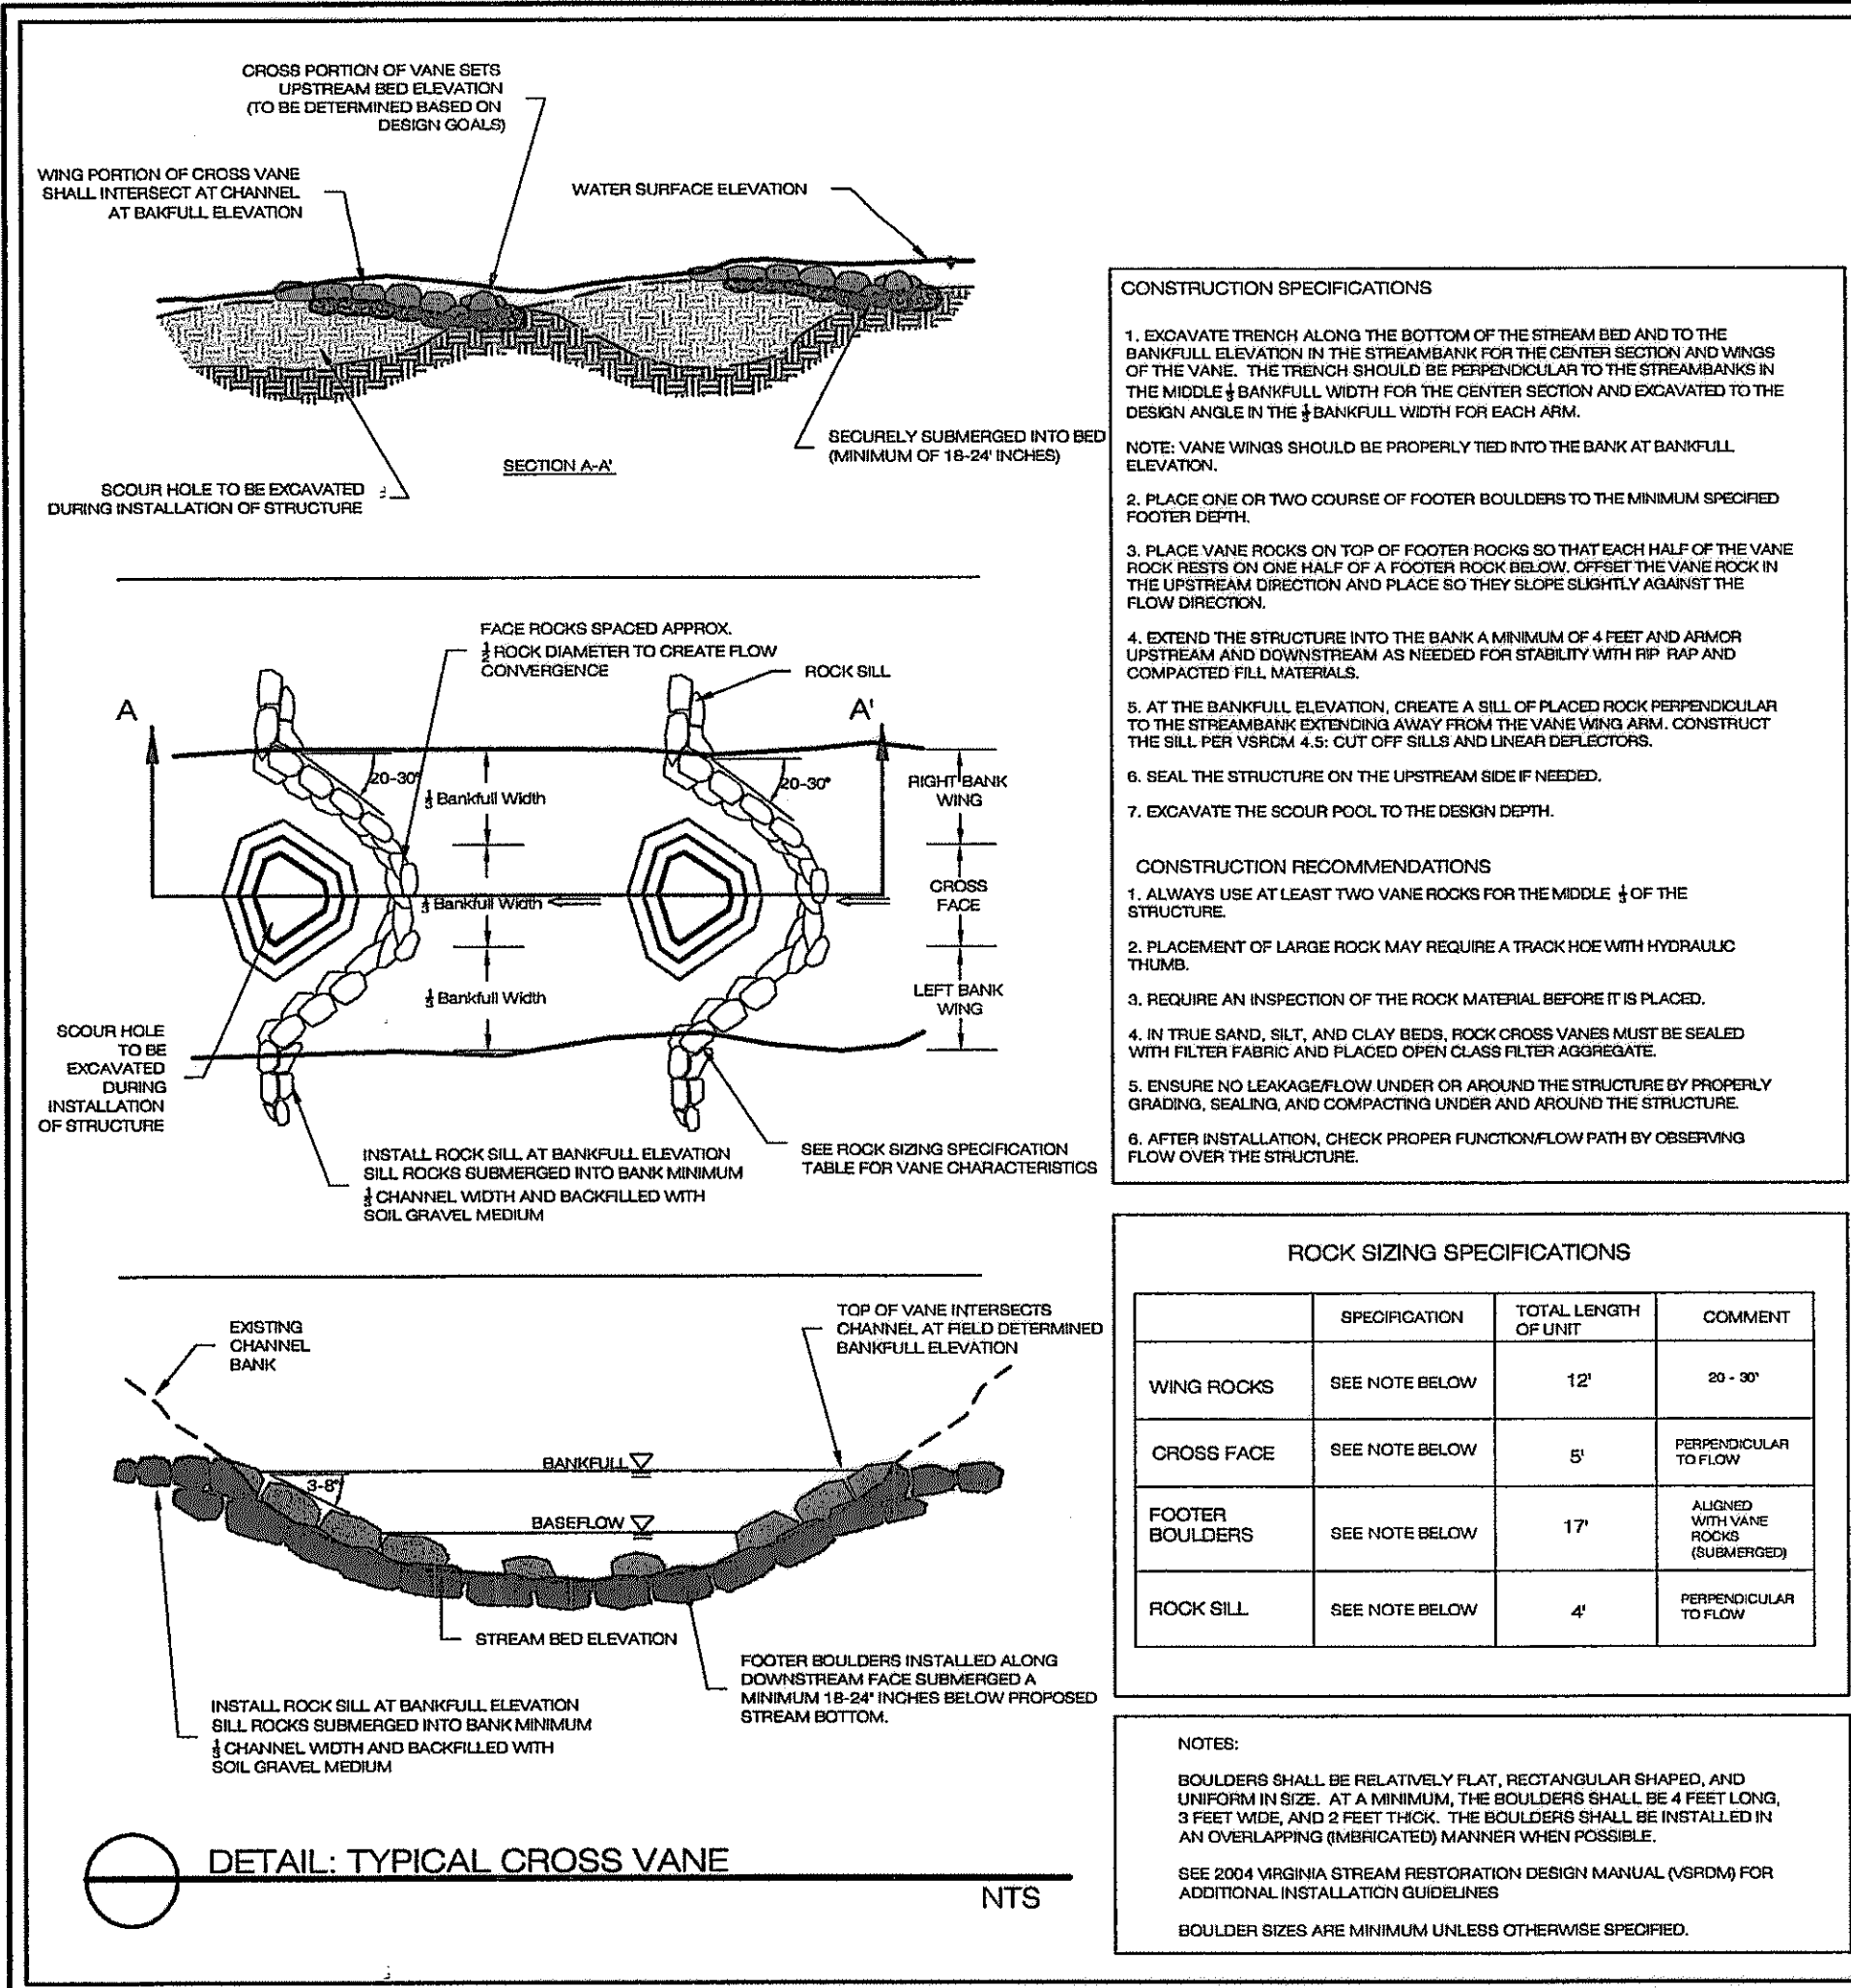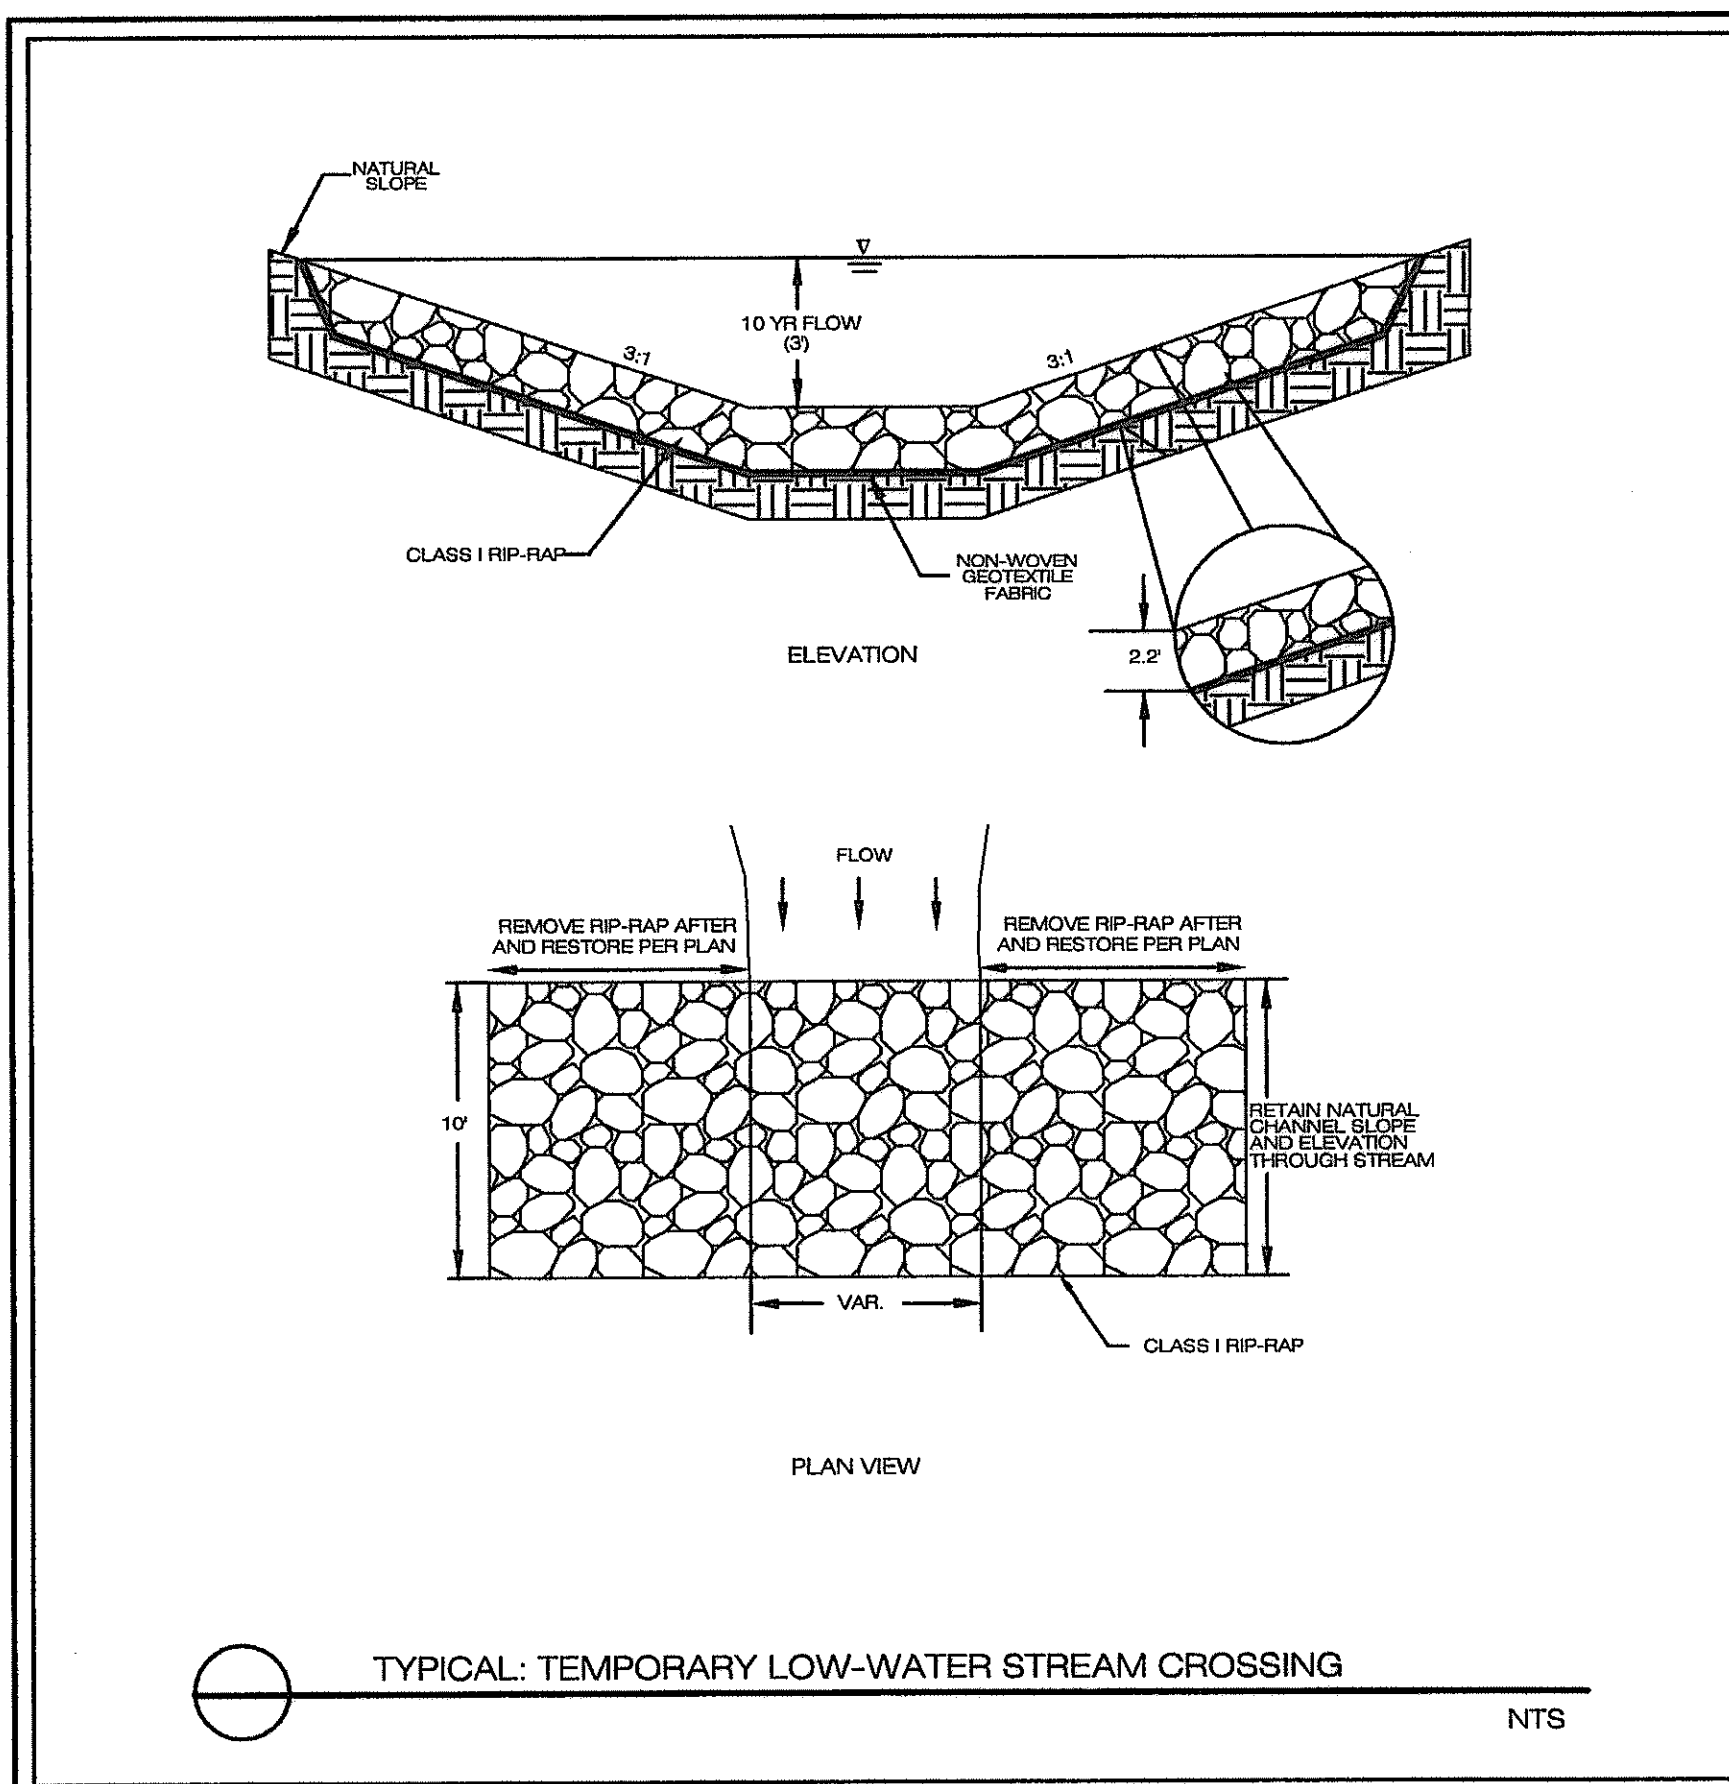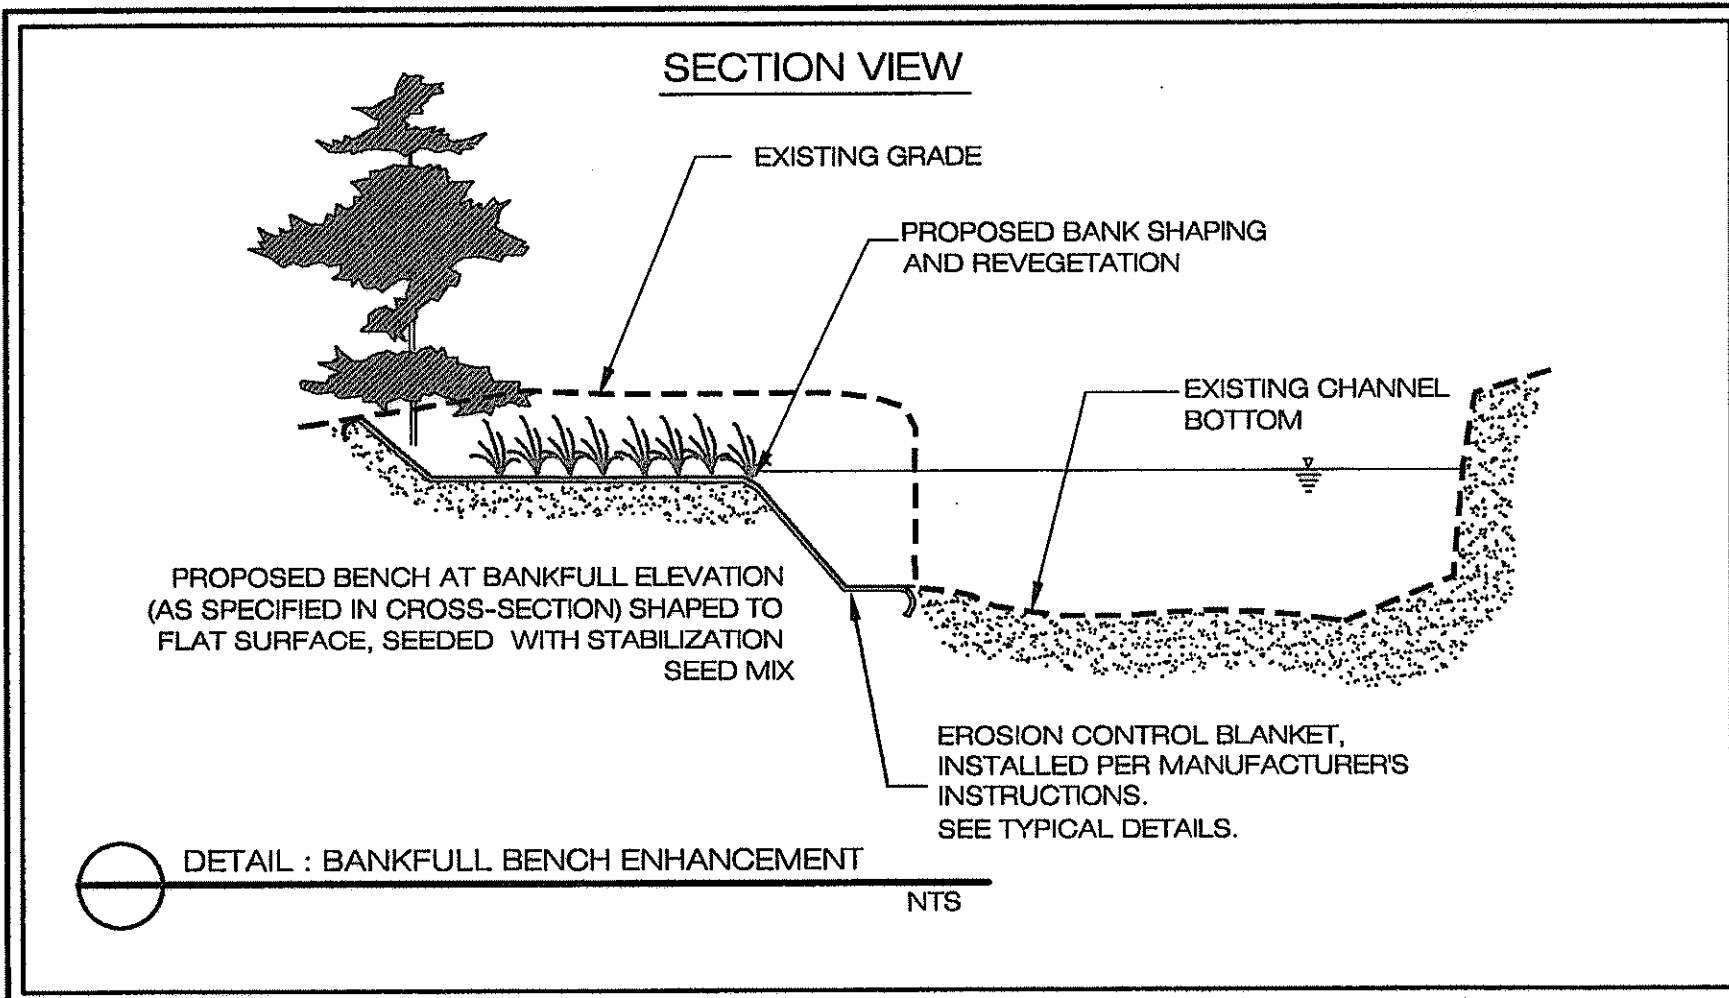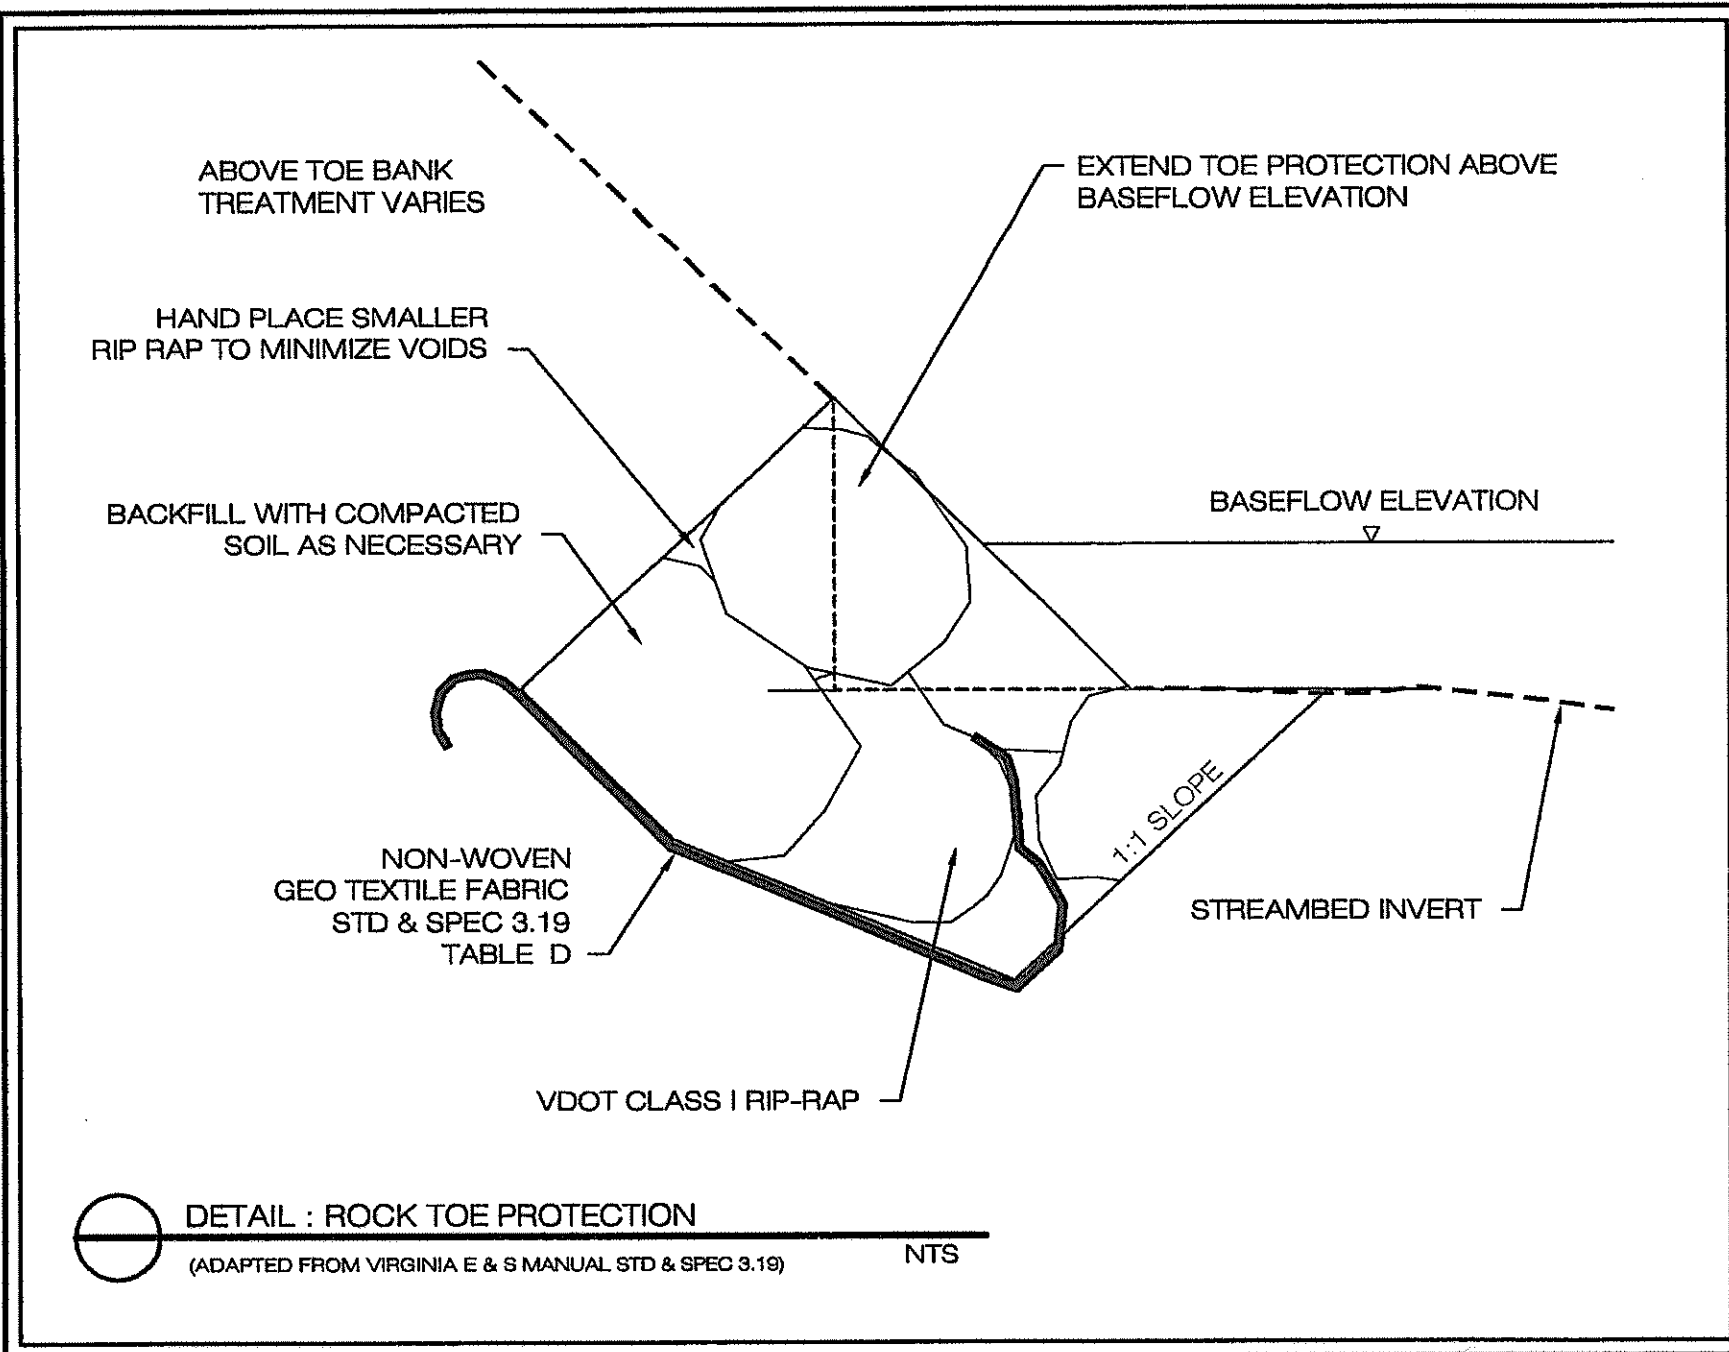

15027 Park Center Road
Richmond, VA, Virginia 23111
Phone: 804-771-2000
Fax: 804-771-2006

6706 Sowers Run Blvd.
Fredericksburg, Virginia 22407
Phone: 804-251-5474
Fax: 804-251-5474

Environmental Consultants

STREAM RESTORATION NOTES AND DETAILS
TAFT AVENUE
CITY OF ALEXANDRIA, VIRGINIA

COMMONWEALTH OF VIRGINIA
KERRY F. HANCOCK
Lic. No. 37017
01/16/2008
PROFESSIONAL ENGINEER

REVISIONS:


DATE	DESCRIPTION
5/22/08	REMOVED OUTLET PROTECTION
12/2/08	INCLUDED ADDITIONAL NOTES
04/22/09	REVISED SPECIFICATIONS
08/14/07	PER 62767 CIVIL REVIEW LETTER
10/17/07	PER 62767 CIVIL REVIEW LETTER

DRAWN BY: EBG/AMM
DESIGNED BY: TWG/EBGNUL
DATE: 12/27/05
CHECKED BY: TWG/UTH


SHEET: 8
JOB#: 2256

APPROVED
SPECIAL USE PERMIT NO. 2007-0009
DEPARTMENT OF PLANNING & ZONING
ENVIRONMENTAL SERVICES
SITE PLAN NO. 2007-0018
DATE: 2/1/09
CHAIRMAN, PLANNING COMMISSION
DATE RECORDED:

EROSION AND SEDIMENT CONTROL PLAN

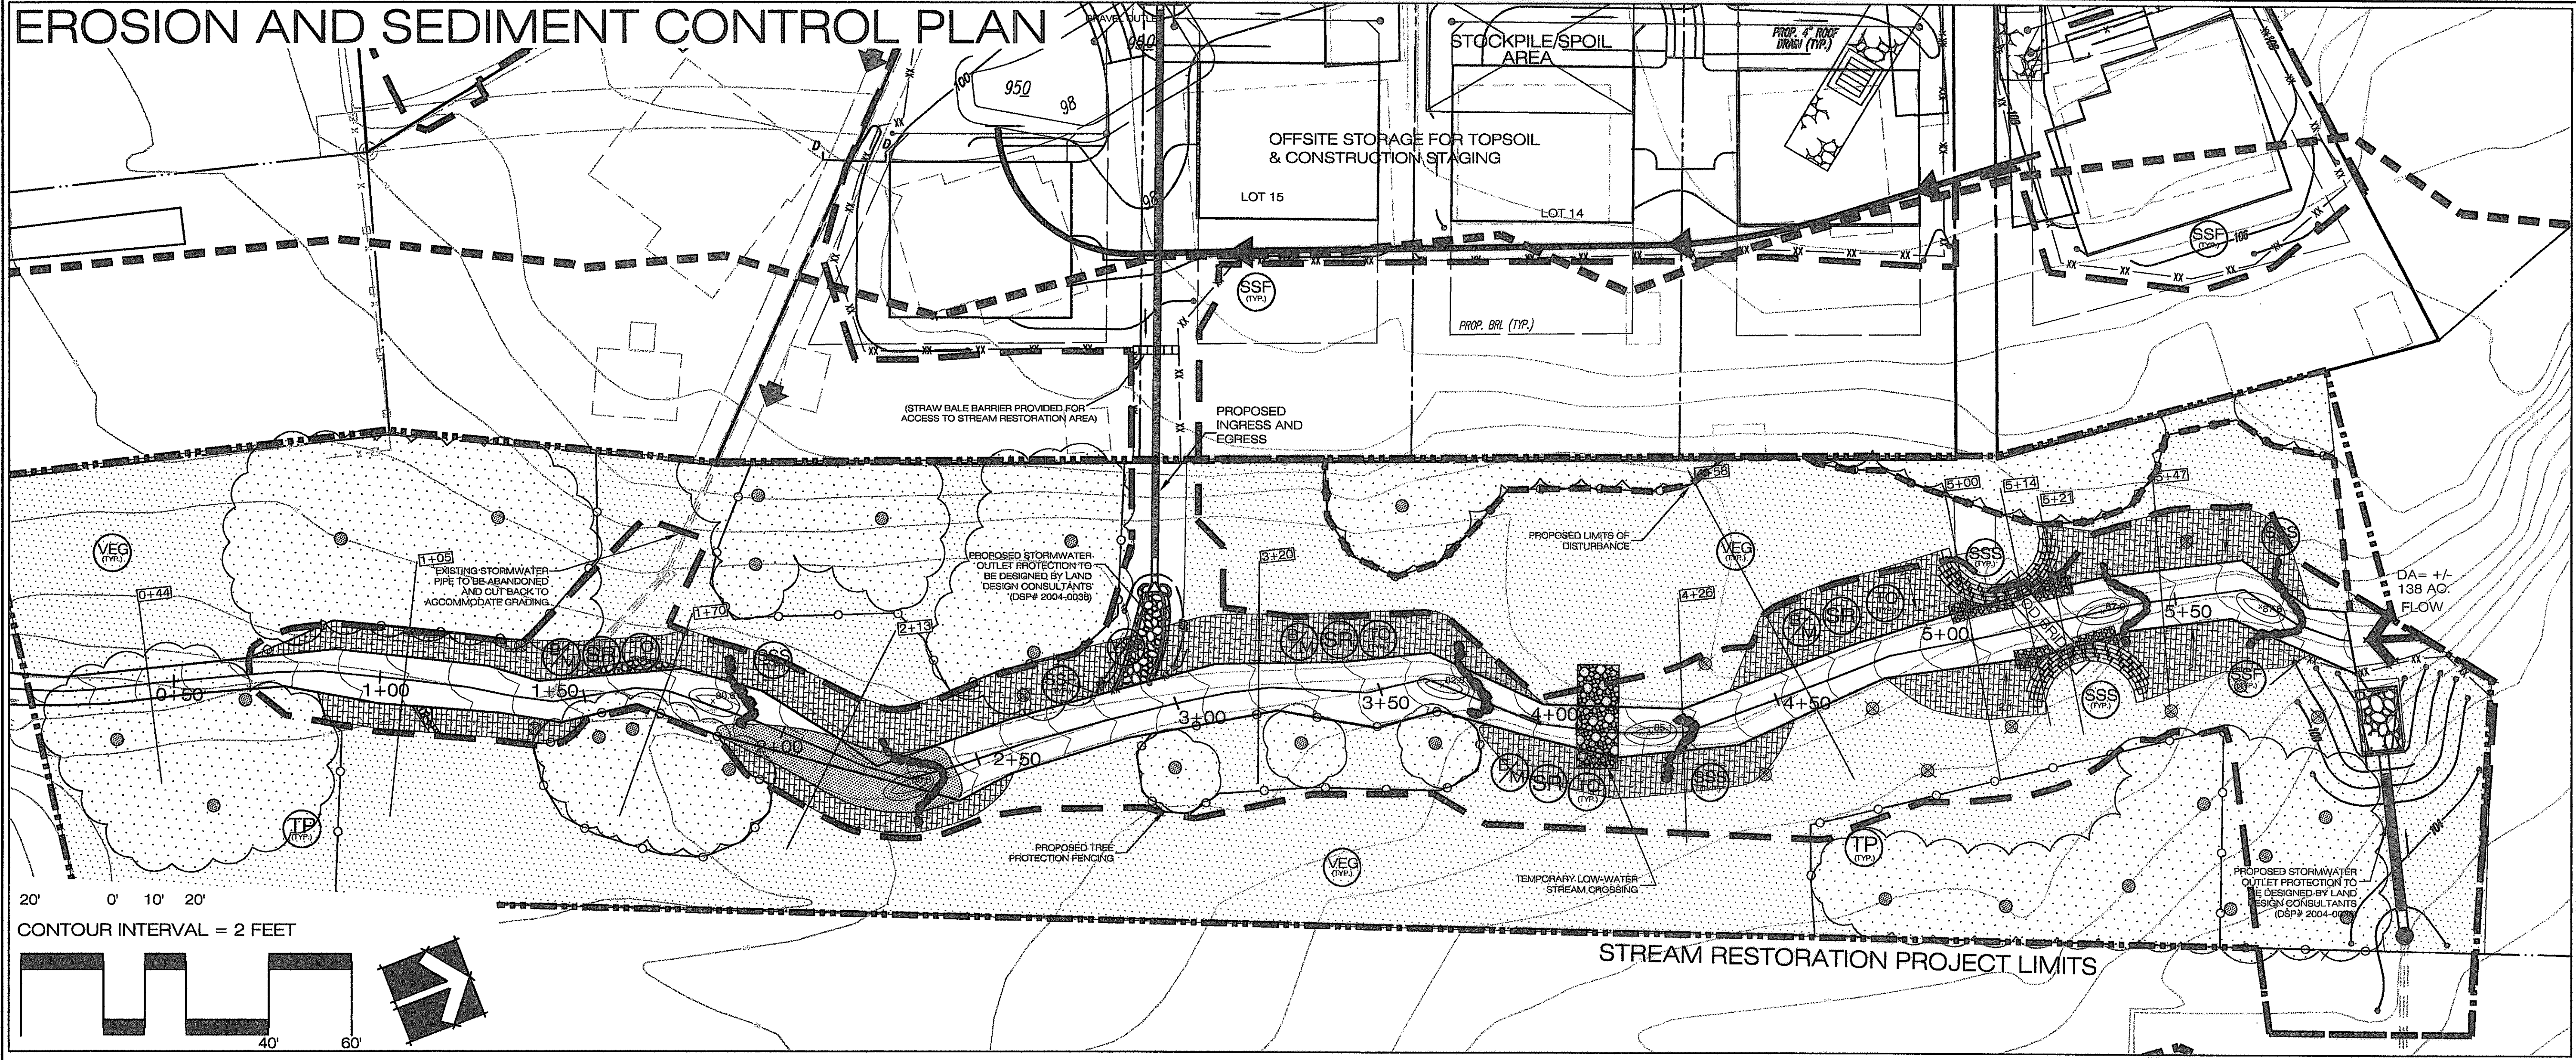

CONTOUR INTERVAL = 2 FEET

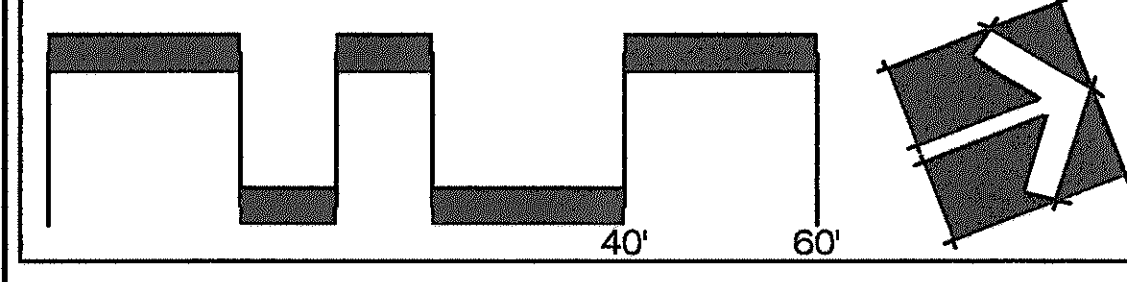

LEGEND:	
	PROJECT LIMITS
	APPROXIMATE STREAM CHANNEL LIMITS
	RESOURCE PROTECTION AREA LIMITS
	EXISTING CONTOURS
	EXISTING TREES (TO BE PROTECTED)
	EXISTING TREES (TO BE REMOVED)
	PROPOSED ROCK STABILIZATION
	PROPOSED GRADING
	PROPOSED CROSS-VANE
	PROPOSED J-HOOK
	PROPOSED SCOUR POOL
	PROPOSED BUFFER RESTORATION AREA
	PROPOSED BANKFULL BENCH AND BANK GRADING
	PROPOSED CHANNEL SHAPING
	SUPER SILT FENCE
	PROPOSED BRIDGE STABILIZATION
	UN-SURVEYED CROSS-SECTION
	SURVEYED CROSS-SECTION
	LIMITS OF DISTURBANCE
	VEG (TYP)
	VSS (TYP)
	BM (TYP)
	SR (TYP)
	TO (TYP)
	SSF (TYP)
	TP (TYP)


EROSION AND SEDIMENT CONTROL NARRATIVE

EROSION AND SEDIMENT CONTROL:
DUE TO THE NATURE AND SHORT CONSTRUCTION PERIOD OF THIS PROJECT, EROSION AND SEDIMENT CONTROL SHALL BE HANDLED IN THE FOLLOWING MANNER. ALL DETAILS AND EROSION AND SEDIMENT CONTROL MEASURES SHALL FOLLOW THE VIRGINIA EROSION AND SEDIMENT CONTROL HANDBOOK.

1. ALL CONSTRUCTION WILL TAKE PLACE FROM UPSTREAM TO DOWNSTREAM.
2. TREE PROTECTION SHALL BE INSTALLED TO SHOW LIMITS OF THE DISTURBANCE AND VEHICULAR TRAVEL PER THIS SHEET.
3. ALL VEHICULAR MOVEMENT SHALL BE CONFINED WITH THE PROJECT LIMITS AND THE OFFSITE STORAGE FOR TOPSOIL AND CONSTRUCTION STAGING. NO VEHICLES SHALL TRAVEL IN NOR MATERIALS PLACED WITHIN THE TREE PROTECTION AREAS.
4. TEMPORARY SANDBAG DIKES TO BE INSTALLED IN EXISTING STREAM AS WORK IS IN PROGRESS. TEMPORARY PUMP AROUND DIVERSIONS SHALL BE INSTALLED AS DIRECTED BY ENGINEER. THIS MEASURE WILL FURTHER HELP DETER THE MOVEMENT OF SEDIMENT DOWNSTREAM.
5. THE CONTRACTOR SHALL STABILIZE ALL DISTURBED AREAS WITH EC-2 MATTING PRIOR TO THE COMPLETION OF EACH WORK DAY. NO BARE SOIL SHALL BE LEFT EXPOSED AFTER THE CONTRACTOR HAS LEFT THE SITE.
6. AFTER THE FIRST UPSTREAM PORTION HAS BEEN COMPLETED, THE PERMANENT DOWNSTREAM SANDBAG DIKES SHALL BE PLACED. THIS MEASURE SHALL WORK TO SLOW ANY FLOW BEFORE ENTERING INTO THE EXISTING STREAM.
7. BEFORE EC-2 MATTING HAS BEEN PLACED, THE GENERAL STABILIZATION MIX SHALL BE INCORPORATED WITH THE NEWLY GRADED SUBSTRATE. SPECIFICATIONS FOR THIS MIX ARE LOCATED ON SHEET 11.
8. ONCE ALL GRADING AND STABILIZATION HAS BEEN COMPLETED, THE SANDBAG DIKES SHALL BE REMOVED.
9. REEXAMINE THAT ALL WORK HAS BEEN SEEDED AND STABILIZED PROPERLY.

NOTE: ALL ELEVATIONS SHALL BE CHECKED AT THE COMPLETION OF EACH WORK ZONE, OR AS NEEDED DURING THE CONSTRUCTION PERIOD.

CONSTRUCTION SEQUENCE:
STREAM RESTORATION SHALL BE COMPLETED IN CONJUNCTION WITH THE STORMWATER MANAGEMENT INFRASTRUCTURE IN AND AROUND TAFT AVENUE. NO CERTIFICATES OF OCCUPANCY FOR HOUSES ALONG TAFT AVENUE SHALL BE AWARDED UNTIL 90% OF THE STREAM RESTORATION IS COMPLETE AND THE RESTORATION IS CERTIFIED. THE REMAINING 10% OF THE STREAM RESTORATION SHALL BE COMPLETED WITHIN 6 MONTHS OF THE AWARD OF THE FIRST CERTIFICATE OF OCCUPANCY ALONG TAFT AVENUE.

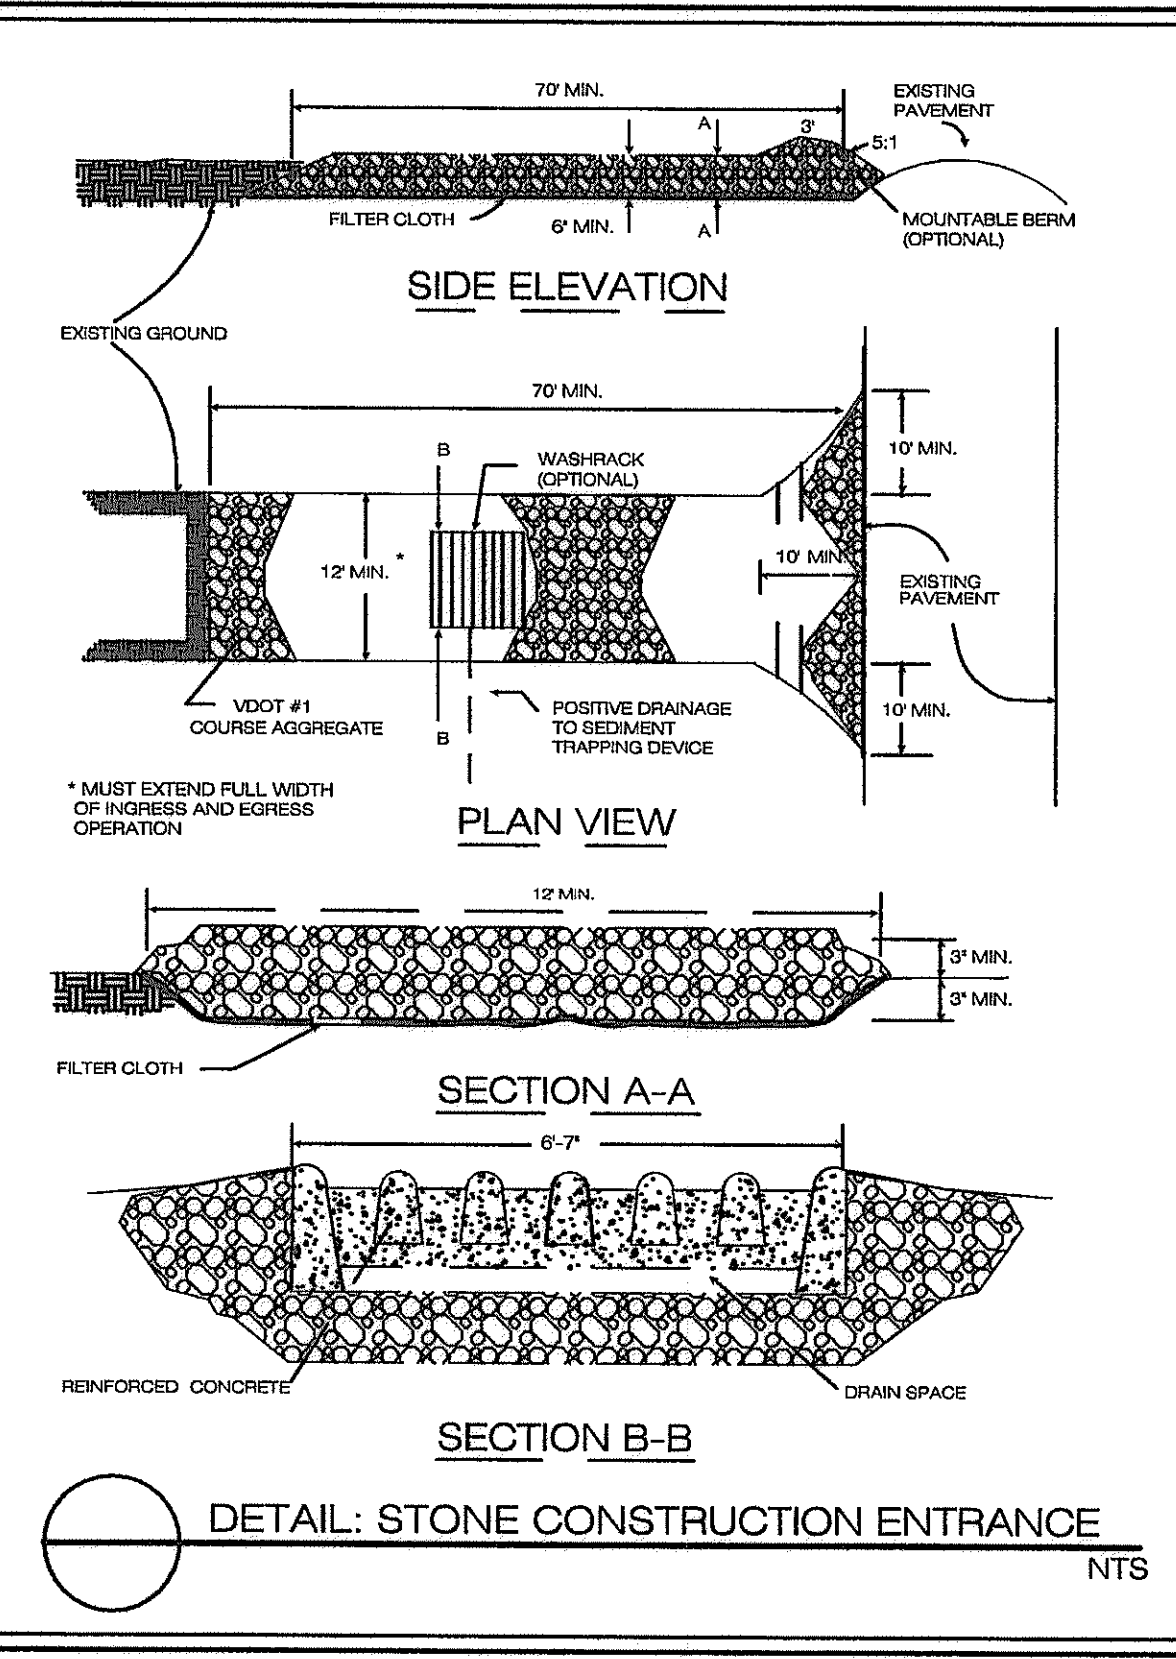

13001 Park Center Road
Shirley, VA 24160
(703) 477-3000
7051 Boulevard View Drive
Richmond, VA 23225
(804) 287-9797

WEG
WILLIAMSBURG
ENVIRONMENTAL
GROUP, INC.

Environmental Consultants

EROSION AND SEDIMENT CONTROL PLAN
TAFT AVENUE
CITY OF ALEXANDRIA, VIRGINIA

COMMONWEALTH OF VIRGINIA
JAMES T. HANCOCK
Lic. No. 37017
01/14/2008
PROFESSIONAL ENGINEER

REVISIONS:	DATE:
0006	EROSION AND SEDIMENT CONTROL PLAN REVISION
04/20/07	BRIDGE FASTENED
05/14/07	PER CITY REVIEW LETTER
11/04/07	PER CITY REVIEW LETTER
01/14/08	PER CITY COMMENT

DRAWN BY: EBG/AMM
DATE: 12/27/05

DESIGNED BY: TWC/EBG/ML
CHECKED BY: TWC/JTH

SHEET: **9**
JOB#: 2256

APPROVED
SPECIAL USE PERMIT NO. 2007-0001
DEPARTMENT OF PLANNING & ZONING
2/4/08
DIRECTOR DATE

DEPARTMENT OF TRANSPORTATION & ENVIRONMENTAL SERVICES
SITE PLAN NO. 2007-0018
2/1/08
DIRECTOR DATE

CHAIRMAN, PLANNING COMMISSION DATE
DATE RECORDED

INSTRUMENT NO. DEED BOOK NO. PAGE NO.

V:\2200s\2256 - TaftStream Restoration\Construction Plans 10-10-07.dwg

EROSION AND SEDIMENT CONTROL NOTES

NOTE: THE CONTRACTOR SHALL COORDINATE WITH THE SITE ENGINEER REGARDING SPECIFIC STAGING AND STOCKPILE PRACTICES AND LOCATIONS, CONSTRUCTION ACCESS, AND INGRESS/EGRESS EASEMENTS.







- THE PURPOSE OF THE EROSION CONTROL MEASURES SHOWN ON THESE PLANS SHALL BE TO PRECLUDE THE TRANSPORT OF ALL WATERBORNE SEDIMENTS RESULTING FROM CONSTRUCTION ACTIVITIES AND ENTERING ONTO ADJACENT PROPERTIES OR STATE WATERS. IF FIELD INSPECTION REVEALS THE INADEQUACY OF THE PLAN TO CONFINE SEDIMENT TO THE PROJECT SITE, APPROPRIATE MODIFICATIONS SHALL BE MADE TO CORRECT ANY PLAN DEFICIENCIES. IN ADDITION TO THESE NOTES, ALL PROVISIONS OF THE VIRGINIA EROSION AND SEDIMENT CONTROL REGULATION SHALL APPLY TO THIS PROJECT.
- WHERE CONSTRUCTION VEHICLE ACCESS ROUTES INTERSECT PAVED PUBLIC ROADS, A TEMPORARY STONE CONSTRUCTION ENTRANCE SHALL BE CONSTRUCTED TO MINIMIZE THE TRANSPORT OF SEDIMENT BY TRACKING ONTO THE PAVED SURFACE. WHERE SEDIMENT IS TRANSPORTED ONTO A PUBLIC ROAD SURFACE, THE ROAD SHALL BE CLEANED THOROUGHLY AT THE END OF EACH DAY. SEDIMENT SHALL BE REMOVED FROM THE ROADS BY SHOVELING OR SWEEPING AND TRANSPORTED TO A DISPOSAL AREA.
- ALL EROSION AND SEDIMENT CONTROL MEASURES SHALL BE INSTALLED AND MAINTAINED IN ACCORDANCE WITH THE VIRGINIA EROSION AND SEDIMENT CONTROL HANDBOOK, THIRD EDITION, 1992. THE CONTRACTOR SHALL BE THOROUGHLY FAMILIAR WITH ALL APPLICABLE MEASURES CONTAINED THEREIN WHICH MAY BE PERTINENT TO THIS PROJECT.
- ALL APPLICABLE FEDERAL, STATE AND LOCAL REGULATIONS PERTAINING TO WORKING IN, OR CROSSING, A LIVE WATERCOURSE SHALL BE MET.
- PERIODIC INSPECTIONS OF ALL EROSION CONTROL MEASURES SHALL BE MADE BY THE CONTRACTOR TO ASSESS THEIR CONDITION. THIS INCLUDES INSPECTION AFTER EVERY ERODIBLE RAINFALL EVENT AND THE REPAIR OF MEASURES DAMAGED BY SUB-CONTRACTORS. ANY NECESSARY REPAIRS OR CLEAN UP TO MAINTAIN THE EFFECTIVENESS OF THE EROSION CONTROL DEVICES SHALL BE MADE IMMEDIATELY.
- SEDIMENT CONTROL MEASURES MAY REQUIRE MINOR FIELD ADJUSTMENTS AT THE TIME OF CONSTRUCTION TO INSURE THEIR INTENDED PURPOSE IS ACCOMPLISHED. APPROVAL BY THE ENGINEER WILL BE REQUIRED FOR ANY DEVIATIONS FROM THE APPROVED PLANS.
- THE CONTRACTOR IS RESPONSIBLE FOR THE INSTALLATION OF ANY ADDITIONAL EROSION CONTROL MEASURES NECESSARY TO PREVENT EROSION AND SEDIMENTATION.
- ALL EROSION CONTROL DEVICES SHALL BE IN PLACE AND FUNCTIONAL AT ALL TIMES AND IF REMOVED FOR CONSTRUCTION PROGRESS, SHALL BE REPLACED BY THE CLOSE OF EACH WORKDAY.
- THE CONTRACTOR WILL LIMIT TEMPORARY, ON-SITE STOCKPILING OF SOILS BY DAILY REMOVAL OF EXCESS CUT MATERIAL FROM THE SITE. ANY TEMPORARY STOCKPILE LOCATED WITHIN THE PROJECT AREA WILL BE LOCATED BY THE CONTRACTOR AND SHALL BE STABILIZED OR PROTECTED WITH SEDIMENT TRAPPING MEASURES MINIMUM STANDARD 2 OF THE VIRGINIA EROSION AND SEDIMENT CONTROL REGULATIONS. THE CONTRACTOR IS RESPONSIBLE FOR THE TEMPORARY PROTECTION AND PERMANENT STABILIZATION OF ALL SOIL STOCKPILES ON SITE AS WELL AS BORROW AREAS AND SOIL INTENTIONALLY TRANSPORTED FROM THE PROJECT SITE.
- PERMANENT OR TEMPORARY SOIL STABILIZATION MUST BE APPLIED TO ALL DENUDED AREAS WITHIN 1 DAY AFTER FINAL GRADE IS REACHED ON ANY PORTION OF THE SITE. SOIL STABILIZATION WILL ALSO BE APPLIED TO DENUDED AREAS WHICH MAY NOT BE AT FINAL GRADE BUT WILL REMAIN DORMANT (UNDISTURBED) FOR LONGER THAN 2 DAYS. SOIL STABILIZATION MEASURES INCLUDE VEGETATIVE ESTABLISHMENT OR MULCHING.
- IF DISTURBED AREA STABILIZATION IS TO BE ACCOMPLISHED DURING THE MONTHS OF DECEMBER, JANUARY, OR FEBRUARY, STABILIZATION SHALL CONSIST OF MULCHING IN ACCORDANCE WITH SPECIFICATION 3.35 OF THE VIRGINIA EROSION AND SEDIMENT CONTROL HANDBOOK, THIRD EDITION. SEEDING WILL THEN TAKE PLACE AS SOON AS THE SEASON PERMITS.
- THE TERM SEEDING, FINAL VEGETATIVE COVER OR STABILIZATION, ON THIS PLAN SHALL MEAN THE SUCCESSFUL GERMINATION AND ESTABLISHMENT OF A STABLE COVER FROM A PROPERLY PREPARED SEEDBED CONTAINING THE SPECIFIED AMOUNTS OF SEED AND SOIL AMENDMENTS.

STRUCTURAL PRACTICES

ALL EROSION AND SEDIMENT CONTROL PRACTICES PROVIDED ON THE PLANS WILL BE CONSTRUCTED AND MAINTAINED ACCORDING TO THE MINIMUM STANDARDS AND SPECIFICATIONS OF THE VIRGINIA EROSION AND SEDIMENT CONTROL HANDBOOK (3RD EDITION, 1992) AND CITY OF ALEXANDRIA SPECIFICATIONS.

THE FOLLOWING STRUCTURAL PRACTICES ARE PROPOSED AND DETAILS ARE INCLUDED ON THE EROSION AND SEDIMENT CONTROL DETAILS SHEET IN THE SITE PLANS.

- TREE PROTECTION:** A FENCE BARRIER IS TO BE PLACED AROUND THE TREES AND VEGETATED AREAS WHICH WILL NOT BE DISTURBED TO PROTECT THE TREES AND OTHER VEGETATION FROM CONSTRUCTION EQUIPMENT AND SOIL COMPACTION WHERE DEEMED NECESSARY BY THE PROJECT ENGINEER.
- STREAM DIVERSION:** A TYPICAL DETAIL FOR THE PUMP AROUND STREAM DIVERSION IS INCLUDED ON SHEET 10 OF THE SUBMITTED PLAN. THE INTENT IS TO ACCOMPLISH IN-STREAM GRADING DURING BASEFLOW CONDITIONS, NOT DURING OR IMMEDIATELY FOLLOWING A STORMWATER RUNOFF EVENT, AND PROVIDE A PUMP AROUND DIVERSION OF THE BASEFLOW SUCH THAT GRADING IS DONE "IN THE DRY" TO THE GREATEST EXTENT PRACTICABLE. THE PUMP AROUND IN THE PLAN WILL CONSIST OF A LOW PERMEABILITY CHECK DAM LOCATED UPSTREAM TO IMPOUND FLOW ABOVE THE WORK AREA AND A PUMP DESIGNED TO DIVERT THE BASEFLOW DOWNSTREAM OF THE WORK AREA. ANOTHER CHECK DAM IS PROVIDED AT THE DOWNSTREAM END TO PREVENT DIVERTED WATER FROM BACKING UP INTO THE WORK AREA. A TYPICAL DETAIL FOR THE "DIRTYBACK" FILTERING STRUCTURE AT THE OUTLET OF THE PUMP IS ALSO SHOWN ON SHEET 11; HOWEVER, AN EQUIVALENT FILTER MAY BE USED BASED ON VESCH GUIDELINES AND CITY OF ALEXANDRIA APPROVAL.
- TOPSOILING:** TOPSOIL SHALL BE USED TO PREPARE A SUITABLE SEED BED FOR PERMANENT VEGETATION. TOPSOIL WILL BE STRIPPED FROM AREAS TO BE GRADED AND TEMPORARILY STOCKPILED IN AN AREA COORDINATED BETWEEN THE CONTRACTOR AND THE SITE ENGINEER. STOCKPILE IN SUCH A MANNER THAT NATURAL DRAINAGE WILL NOT BE OBSTRUCTED AND NO OFF-SITE SEDIMENT DAMAGE WILL RESULT.
- STRUCTURAL STREAMBANK STABILIZATION:** BROWN/TAN RIPRAP WILL BE USED TO STABILIZE AREAS ON THE MAIN CHANNEL AND TRIBUTARIES, AS DESIGNATED ON THE PLAN AND PROFILE SHEETS. J-HOOKS AND CROSS VANES WILL BE CONSTRUCTED WITH BROWN/TAN IMPREGATED Boulders AND USED IN AREAS WHERE HIGH VELOCITIES ARE EXPECTED TO DIRECT STREAM FLOW WITHIN THE STREAM BANKS.
- SURFACE ROUGHENING:** AREAS TO BE PERMANENTLY VEGETATED SHALL BE SURFACE ROUGHENED, NOT SCRAPPED SMOOTH, TO PROVIDE A SUITABLE SURFACE FOR APPLYING TOPSOIL.
- PERMANENT SEEDING:** PERMANENT VEGETATION WILL BE USED TO STABILIZE ALL DENUDED AREAS NOT OTHERWISE STABILIZED.
- SOIL STABILIZATION BLANKETS:** SOIL STABILIZATION BLANKETS WILL BE USED ON PORTIONS OF THE STREAMBANK AND SLOPES ABOVE THE STREAMBANK NOT OTHERWISE STABILIZED WITH RIPRAP. THE TREATMENT 1 (EC-2) BLANKETS ARE INTENDED TO PROVIDE TEMPORARY STABILIZATION AND PROMOTE CONDITIONS SUITABLE FOR THE GERMINATION AND GROWTH OF PERMANENT SEED.

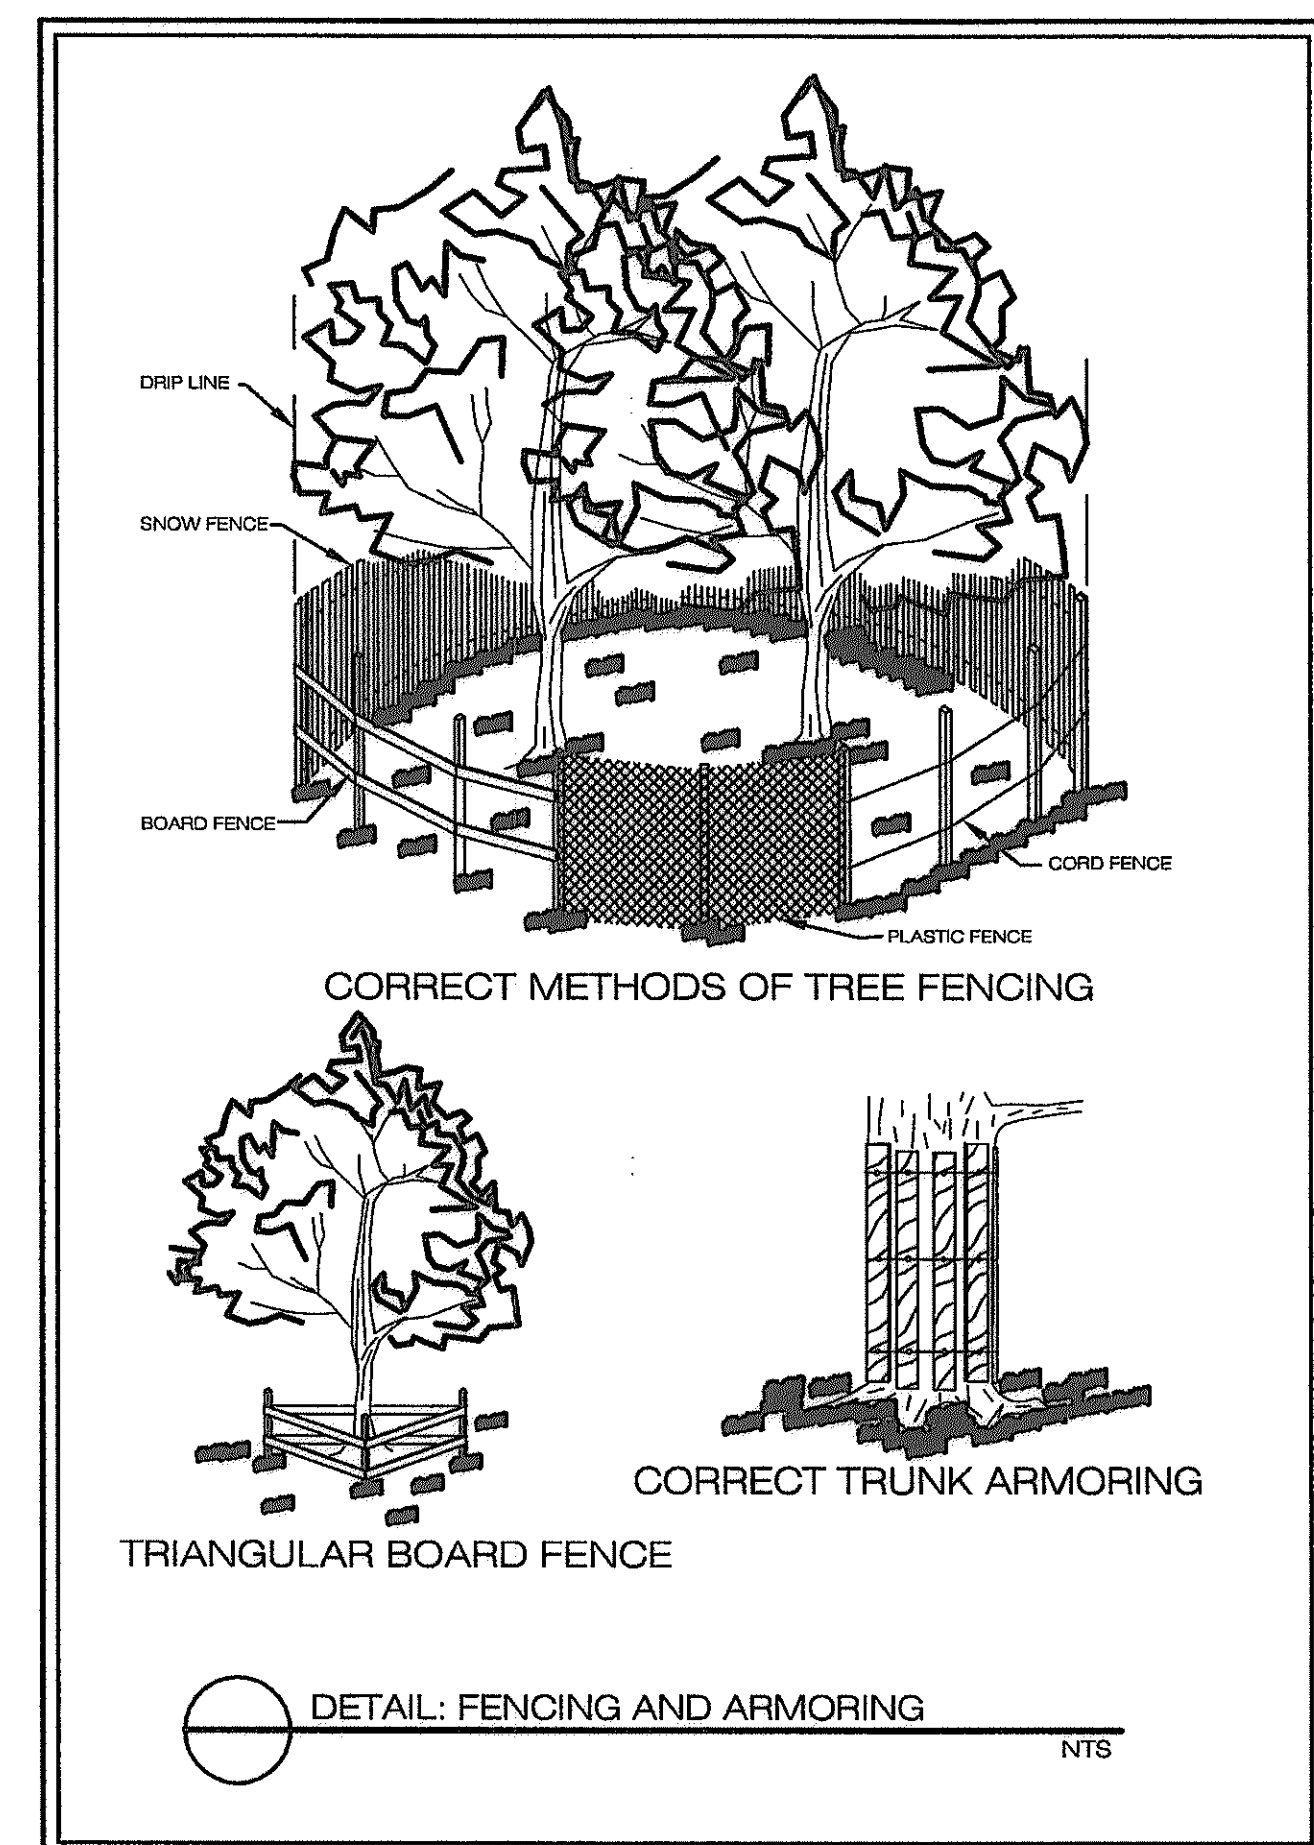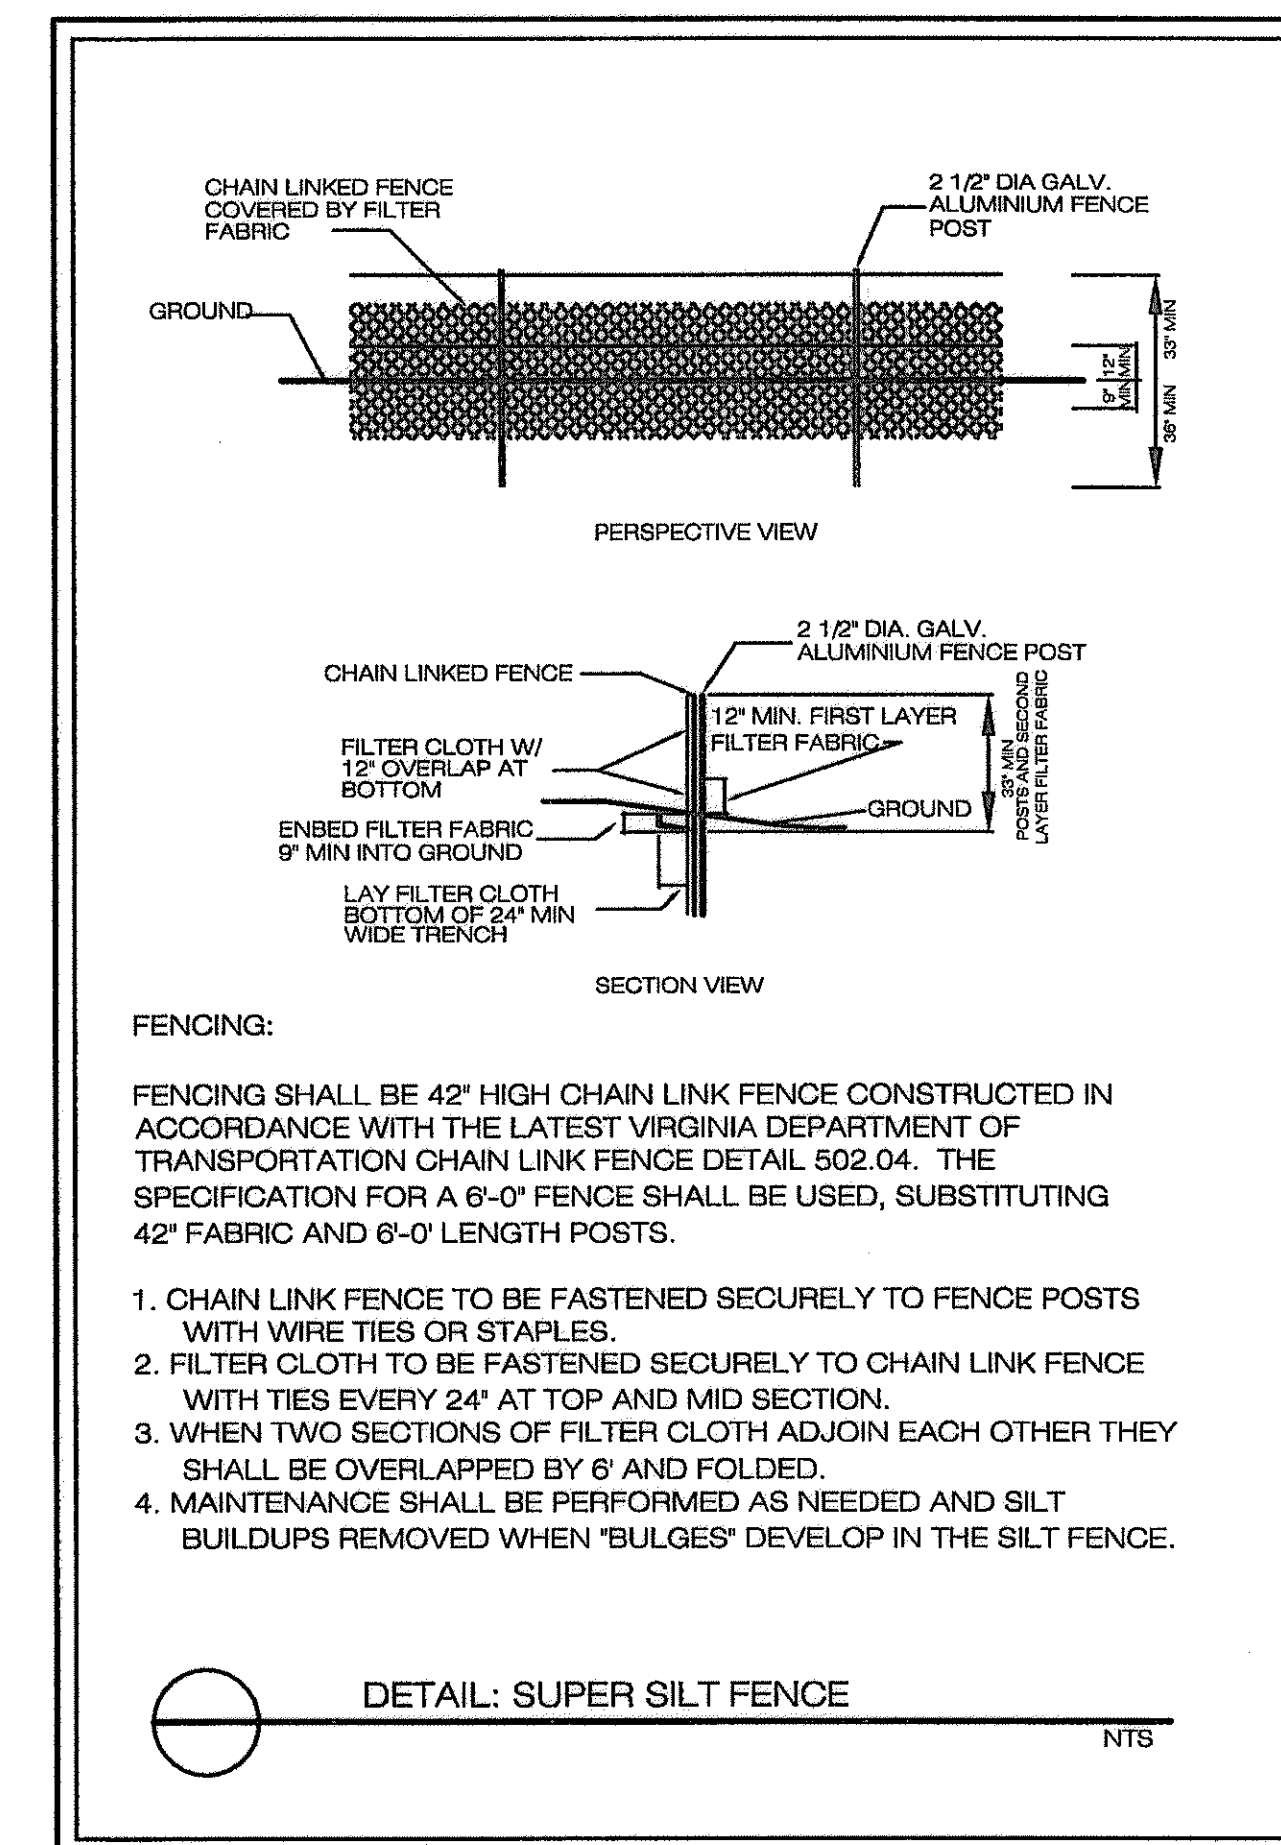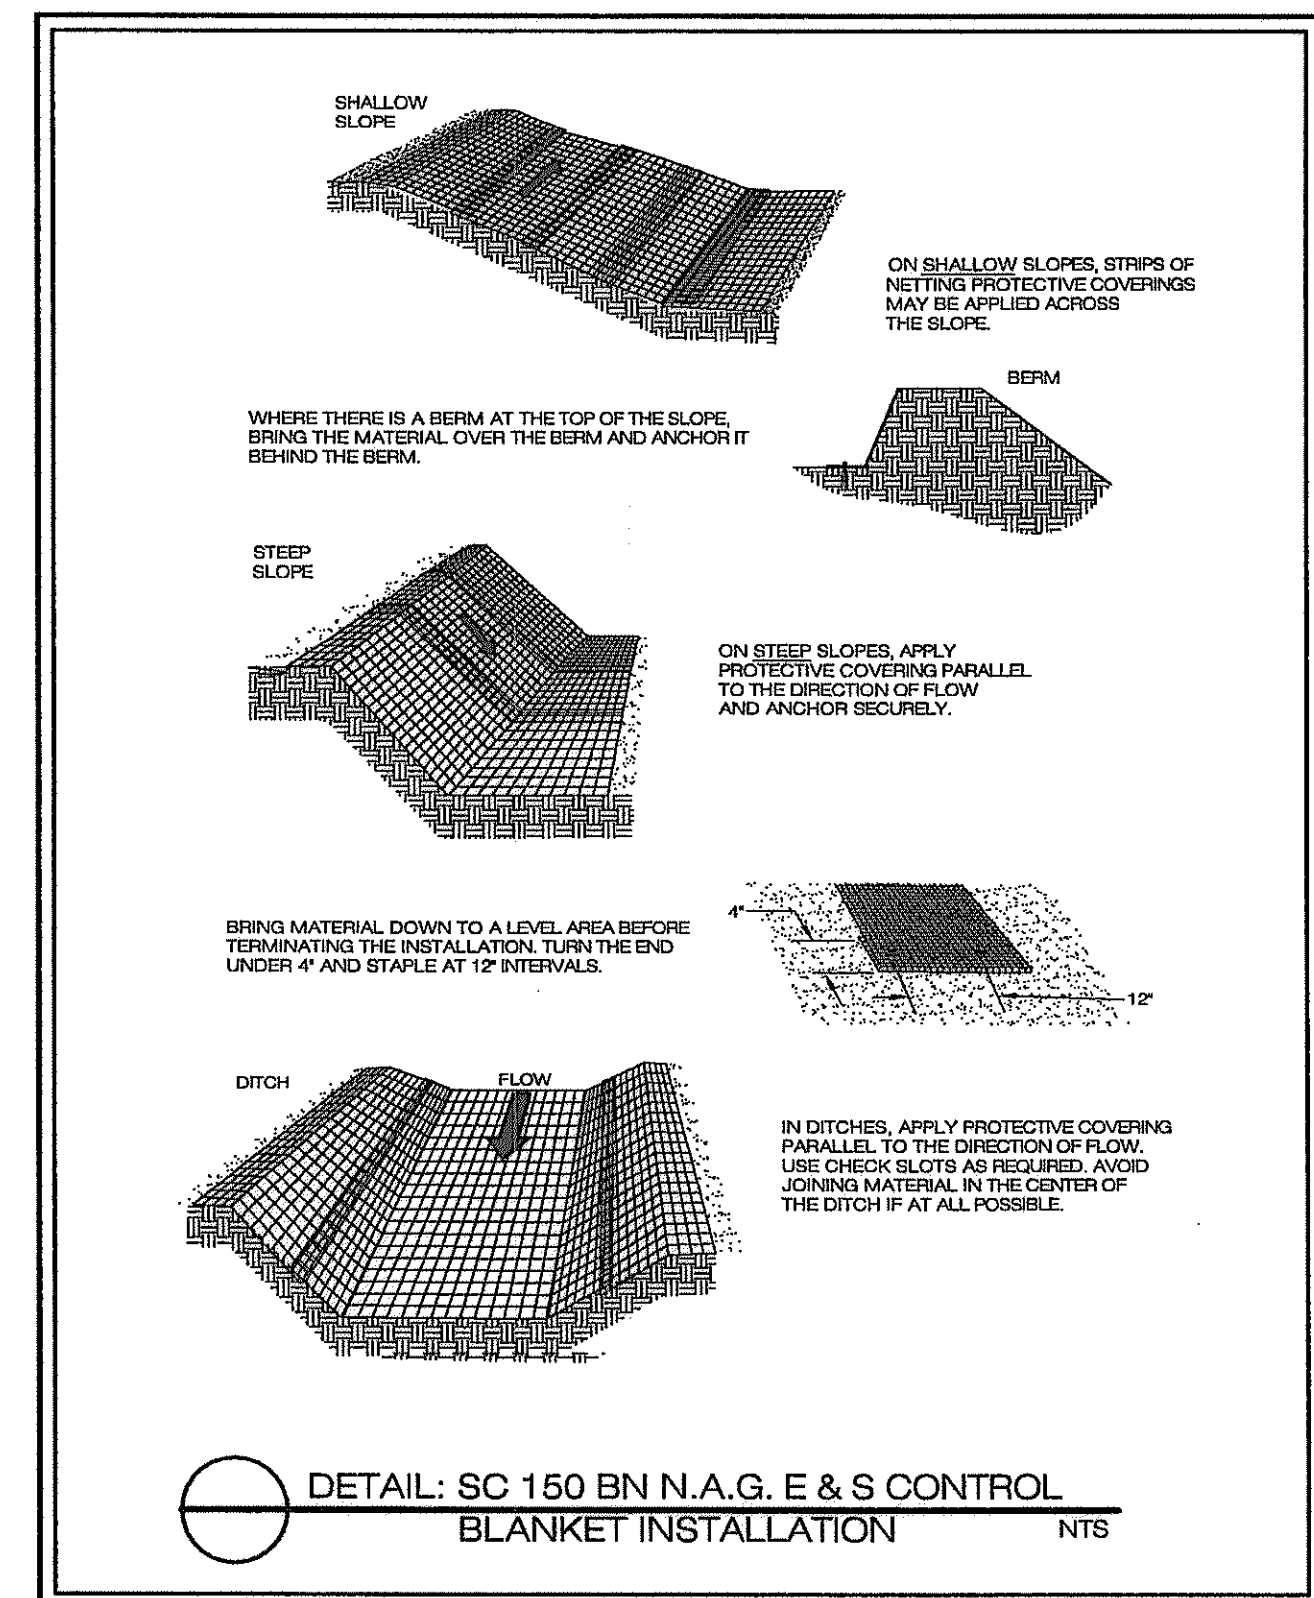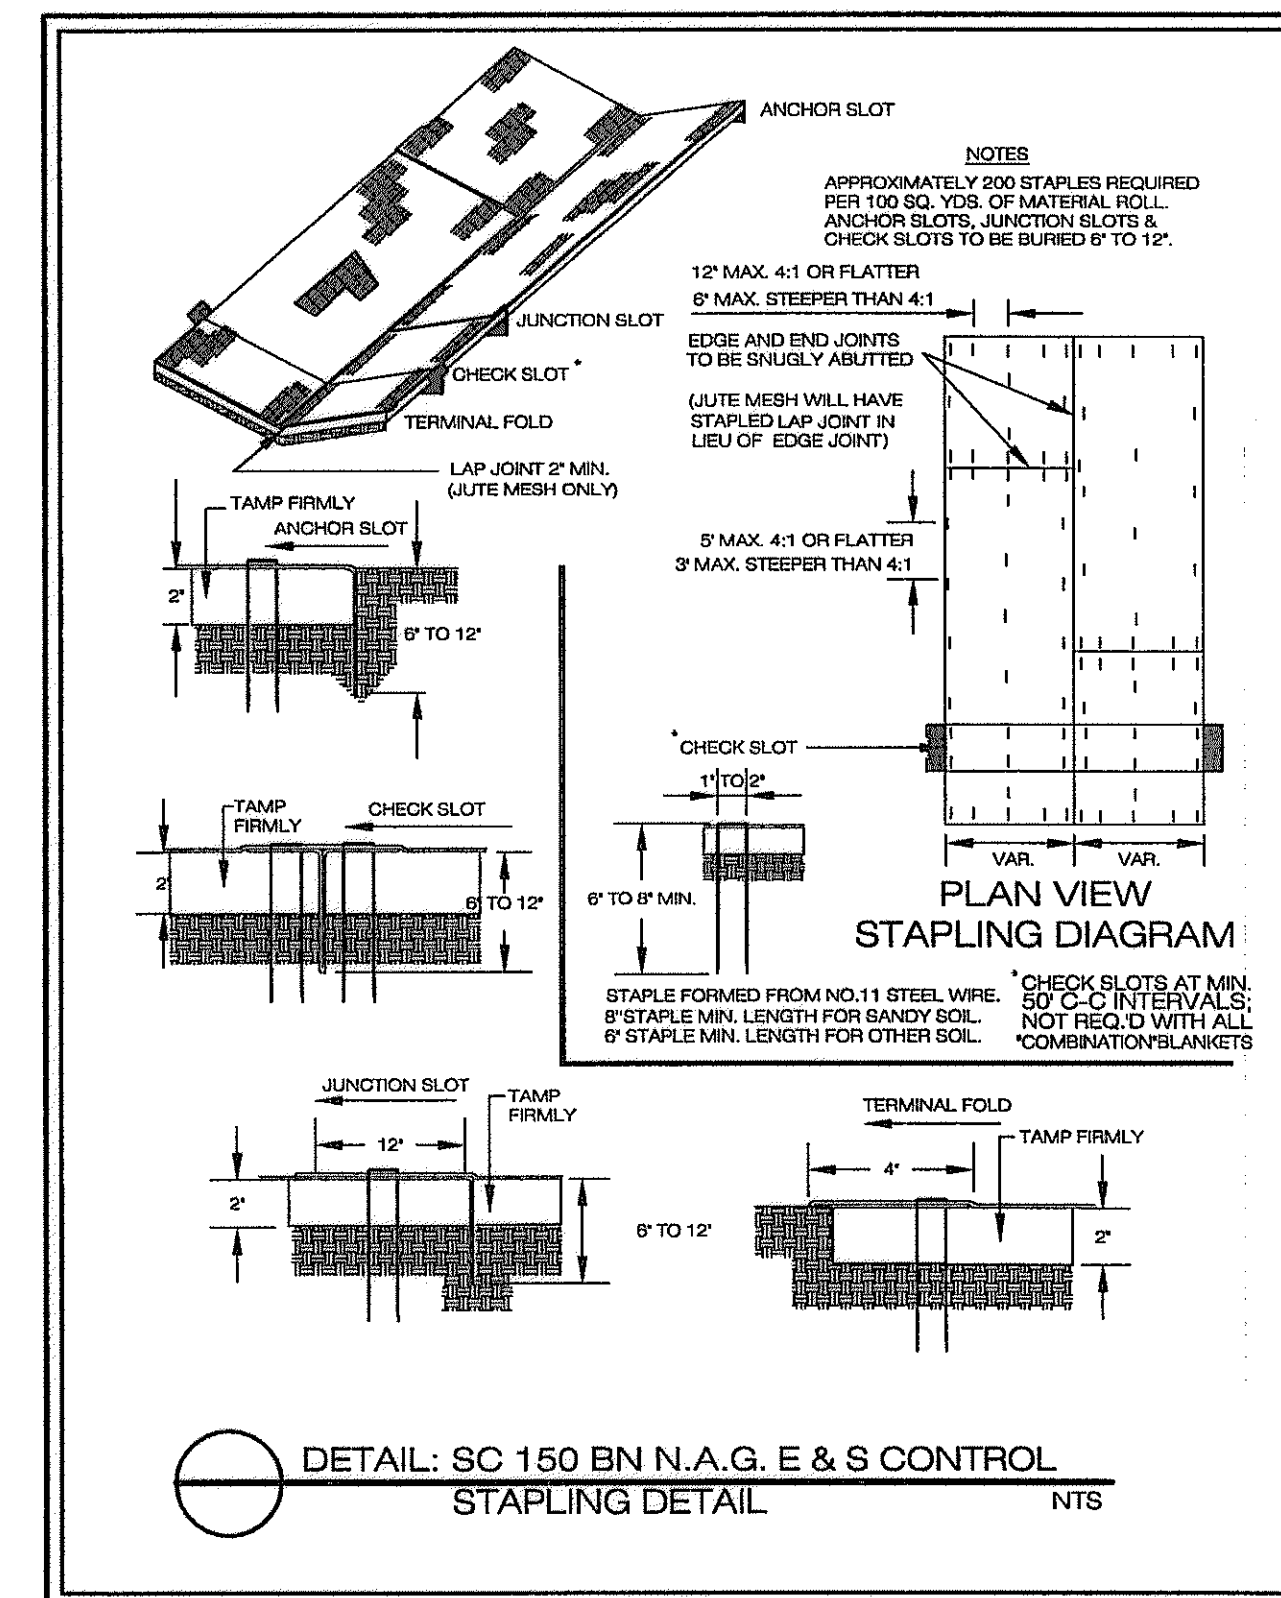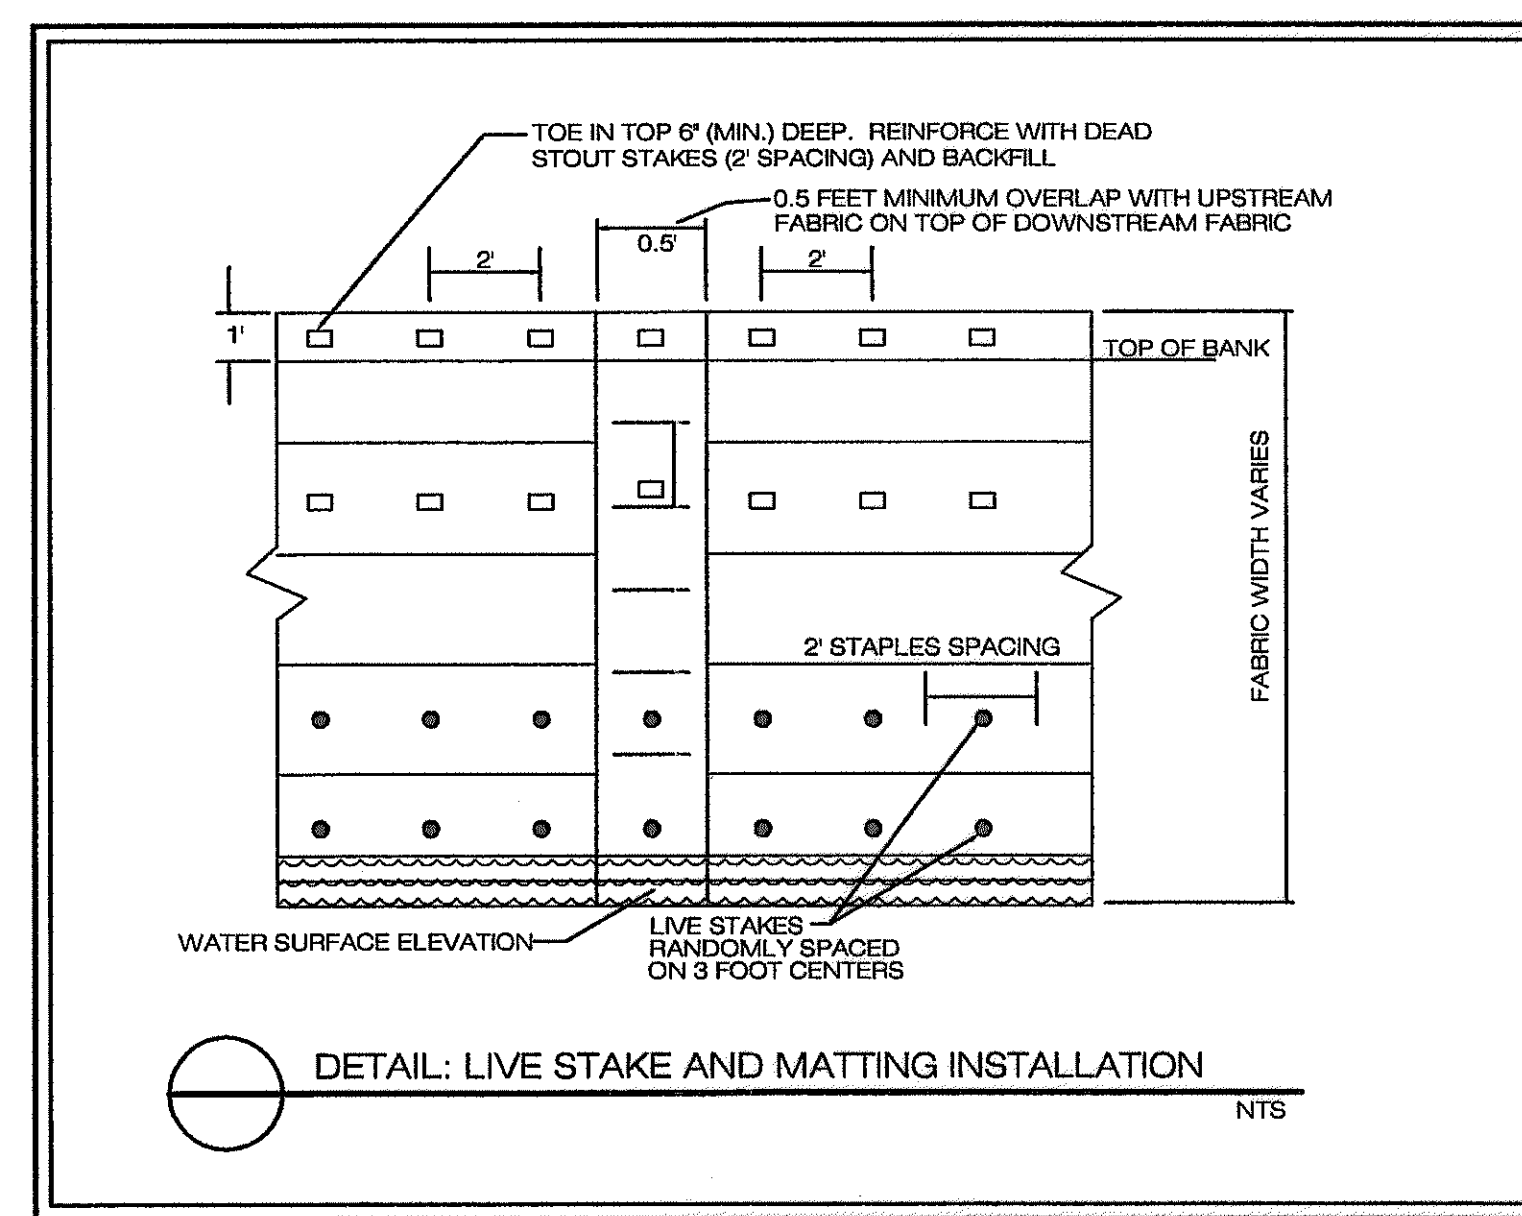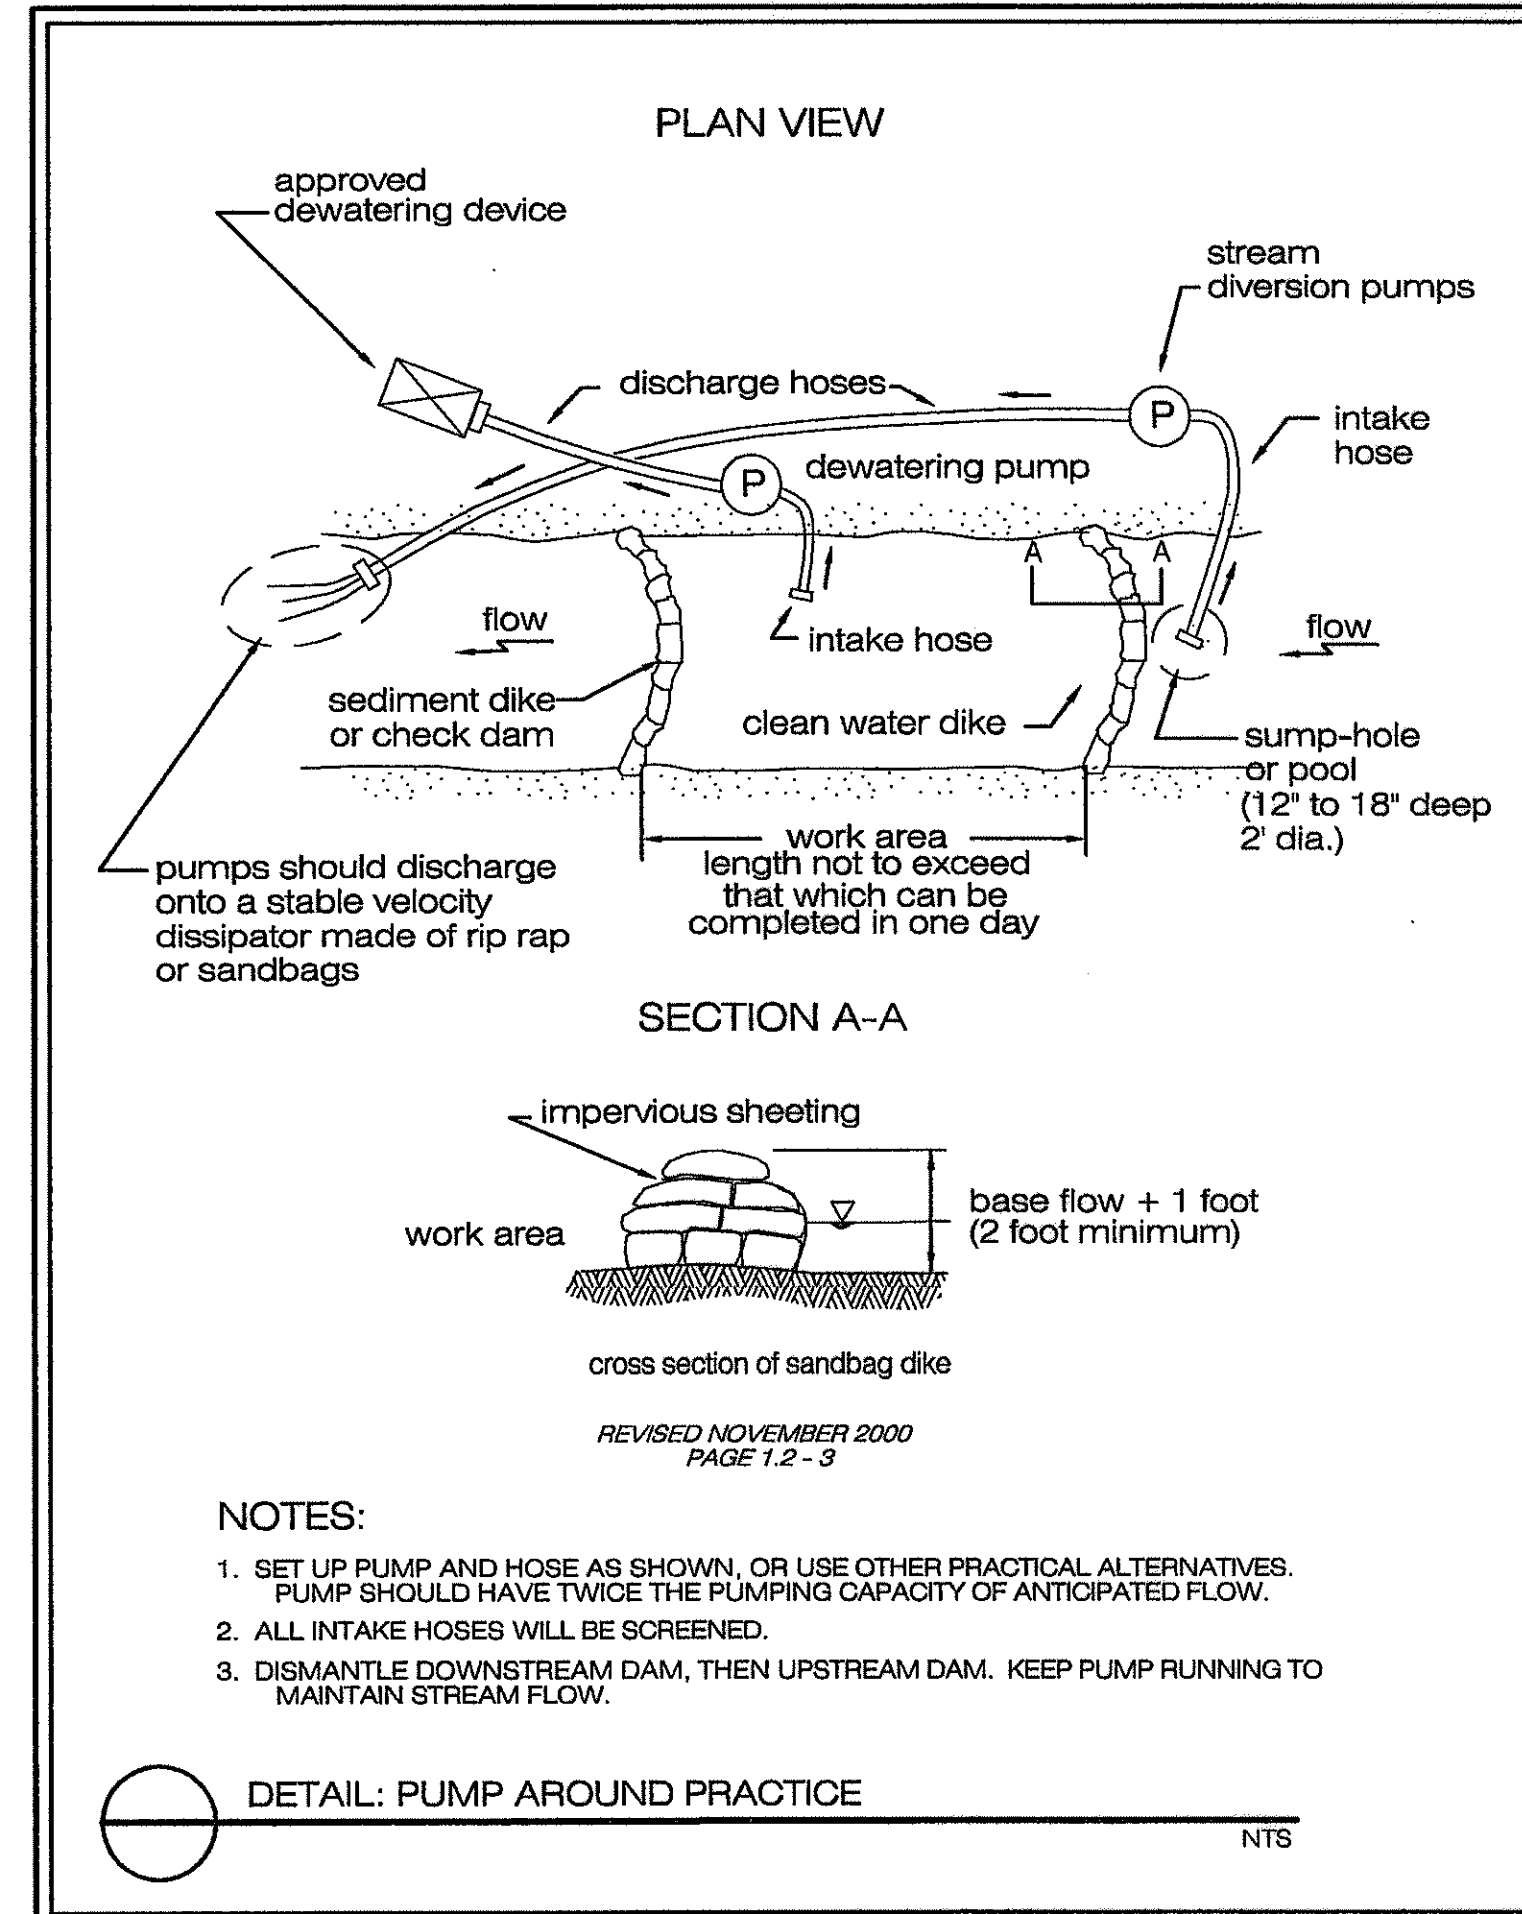

EROSION CONTROL MATTING				
PRODUCT NAME	PRODUCT DESCRIPTION	ROLL SIZE	SPACING	REMARKS
SC150BN N.A.G.	ORGANIC NET	6.87 FT X 108 FT	AS REQUIRED	MATTING TO BE SECURED WITH BOTH STOUT AND LIVE STAKES

13621 Park Center Road
 22009 Center Street
 Herndon, Virginia 20188
 (703) 427-5906
 (703) 222-8500
 2011 Builders View Drive
 Reston, Virginia 20190
 (703) 261-6414
WEG
 WILLIAMSBURG
 ENVIRONMENTAL
 GROUP, INC.
 Environmental Consultants

EROSION AND SEDIMENT CONTROL NOTES AND DETAILS
Taft Avenue
CITY OF ALEXANDRIA, VIRGINIA

PROFESSIONAL ENGINEER
 HANCOCK
 Lic. No. 37017
 01/14/2008

REVISIONS:	DATE:	DESCRIPTION:
1	12/27/05	TREE PROTECTION FENCING AND TRUNK ARMORING DETAILS ADDED
2	12/27/05	REVISION LETTERS
3	12/27/05	REVISION LETTERS


DRAWN BY: EBG/MAM
 DESIGNED BY: TWC/EGNUL
 DATE: 12/27/05
 CHECKED BY: TWC/JTH

SHEET: 10
 JOB#: 2256

APPROVED
 SPECIAL USE PERMIT NO. 2007-008
 DEPARTMENT OF PLANNING & ZONING
 2/4/08
 DIRECTOR
 DEPARTMENT OF TRANSPORTATION
 ENVIRONMENTAL SERVICES
 SITE PLAN NO. 2007-0018
 2/1/08
 DIRECTOR
 CHAIRMAN, PLANNING COMMISSION
 DATE RECORDED

V:\2200\2256 - TaftStream Restoration\Construction Plans 10-10-07.dwg

REPRESENTATIVE PLANTING PLAN

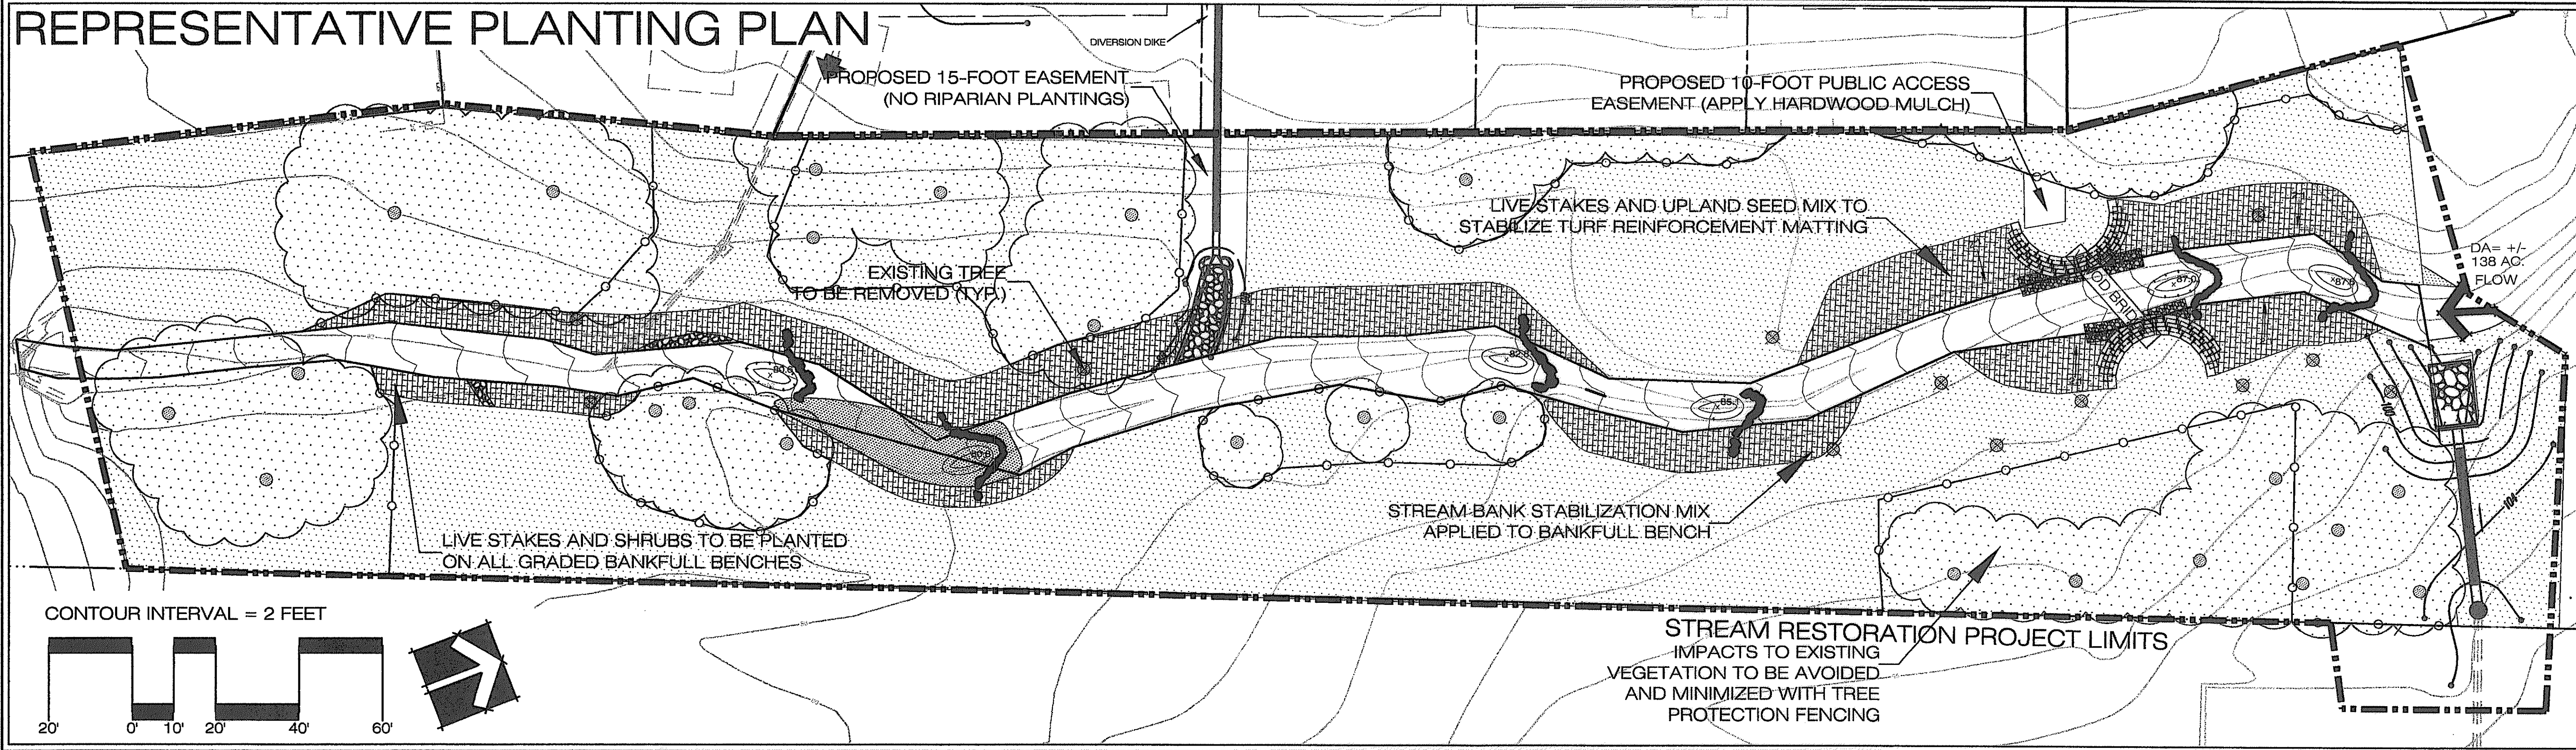

13001 Park Center Road
 Suite 100
 Williamsburg, Virginia 23188
 (757) 437-3200
 (757) 437-3200
 7501 Business View Drive
 Williamsburg, Virginia 23125
 (804) 897-9472
 Environmental Consultants
WEG
 WILLIAMSBURG
 ENVIRONMENTAL
 GROUP, INC.

PLANTING NOTES AND DETAILS
 TAFT AVENUE
 CITY OF ALEXANDRIA, VIRGINIA




PROPOSED STREAM RESTORATION PLANTING PLAN

LEGEND	QUANTITY	BOTANICAL NAME	COMMON NAME	SPECIFICATION	INDICATOR	REMARKS
	1.0 ACRES +/-	UPLAND STABILIZATION SEED MIX				
	20%	<i>Lespedeza virginica</i>	SLENDER LESPEDEZA	SEED	URL	SEED MIX SHALL BE SOWN ON ALL UPLAND DISTURBED AREAS AT A RATE OF 50 LBS/AC.
	20%	<i>Lolium multiflorum</i>	ANNUAL RYE	SEED	NI	
	20%	<i>Elymus virginicus</i>	VIRGINIA WILD RYE	SEED	FACW-	
	10%	<i>Andropogon scoparius</i>	CAMPYR LITTLE BLUESTEM	SEED	FACW-	
	10%	<i>Sorghastrum nutans</i>	TOMAHAWK INDIAN GRASS	SEED	URL	
	10%	<i>Rudbeckia hirta</i>	BLACK EYED SUSAN	SEED	FACU-	
	10%	<i>Tridax flavus</i>	PURPLE TOP	SEED	FACU	
	0.2 ACRES +/-	STREAM BANK STABILIZATION SEED MIX				
	30%	<i>Lolium multiflorum</i>	ANNUAL RYE	SEED	NI	SEED MIX SHALL BE SOWN BELOW GRADED BANKFULL BENCHES, EXCEPT CHANNEL BOTTOM, AT A RATE OF 50 LBS/AC.
	10%	<i>Carex vulpinoidea</i>	FOX SEDGE	SEED	CBL	
	25%	<i>Elymus virginicus</i>	VIRGINIA WILD RYE	SEED	FACW-	
	20%	<i>Panicum virgatum</i>	SWITCH GRASS	SEED	FAC	
	10%	<i>Leersia oryzoides</i>	RICE CUTGRASS	SEED	FAC	
	6%	<i>Lobelia cardinalis</i>	CARDINAL FLOWER	SEED	FACW	
	0.8 ACRES +/-	CANOPY TREES				
	13	<i>Acer rubrum</i>	RED MAPLE	1 1/2-INCH CALIPER	FACW	CANOPY TREES TO BE PLANTED AT ONE (1) PER 400 SQUARE FEET IN BUFFER RESTORATION AREA. CANOPY TREES TO BE LOCATED OPPOSITE EXISTING TREES IN PLANTING AREA. USE 1 1/2-INCH CALIPER TREES AT MINIMUM.
	12	<i>Carya tomentosa (cordiformis)</i>	MOCKERNUT HICKORY (BITTERNUT)	1 1/2-INCH CALIPER	FACU-	
	13	<i>Fraxinus pennsylvanica</i>	GREEN ASH	1 1/2-INCH CALIPER	FACW	
	12	<i>Liriodendron tulipifera</i>	TULIP TREE	1 1/2-INCH CALIPER	FACU	
	12	<i>Plantanus occidentalis</i>	SYCAMORE	1 1/2-INCH CALIPER	FACW-	
	12	<i>Quercus phellos</i>	WALLOW OAK	1 1/2-INCH CALIPER	FAC+	
	12	<i>Quercus palustris</i>	PIN OAK	1 1/2-INCH CALIPER	FACW	
	0.8 ACRES +/-	UNDERSTORY TREES/LARGE SHRUBS				
	34	<i>Ametanchier canadensis</i>	SERVICEBERRY	1-INCH CALIPER	FAC	UNDERSTORY TREES AND LARGE SHRUBS TO BE PLANTED AT TWO (2) PER 400 SQUARE FEET IN BUFFER RESTORATION AREA. UNDERSTORY TREES AND LARGE SHRUBS TO BE SPACED AT 8' OC MINIMUM. USE 1-INCH CALIPER TREES AT MINIMUM.
	35	<i>Cercis canadensis</i>	RED BUD	1-INCH CALIPER	FACW	
	35	<i>Hammamelis virginiana</i>	WITCH HAZEL	1-INCH CALIPER	FAC-	
	35	<i>Ilex opaca</i>	AMERICAN HOLLY	1-INCH CALIPER	FACU-	
	35	<i>Viburnum prunifolium</i>	BLACK HAW	1-INCH CALIPER	FACU	
	0.8 ACRES +/-	SMALL SHRUBS				
	53	<i>Cornus amomum</i>	SILKY DOGWOOD	1 1/2"-1 1/4" TUBELING	FACW+	SMALL SHRUBS TO BE PLANTED AT THREE (3) PER 400 SQUARE FEET IN STREAM RESTORATION AREA. SMALL SHRUBS TO BE SPACED AT 8' OC MINIMUM. USE 1 1/2"-1 1/4" TUBELING SHRUBS AT MINIMUM.
	52	<i>Lindera benzoin</i>	SPICE BUSH	1 1/2"-1 1/4" TUBELING	FACW+	
	52	<i>Kalmia latifolia</i>	MOUNTAIN LAUREL	1 1/2"-1 1/4" TUBELING	FACU	
	52	<i>Moronea caroliniana</i>	SOUTHERN WAXMYRTLE	1 1/2"-1 1/4" TUBELING	FACU	
	52	<i>Viburnum dentatum</i>	ARROWWOOD	1 1/2"-1 1/4" TUBELING	FAC	
	628 L.F. +/-	LIVE STAKES				
	210	<i>Cornus amomum</i>	SILKY DOGWOOD	3" MIN LENGTH	FACW+	PLANT QUANTITIES BASED ON A DOUBLE ROW OF LIVE STAKES, 3- FEET OFF-CENTER.
	210	<i>Salix nigra</i>	BLACK WILLOW	3" MIN LENGTH	FACW	

NOTE: PLANTING QUANTITIES AND SIZING BASED ON VIRGINIA DEPARTMENT OF CONSERVATION AND RECREATION'S RIPARIAN BUFFER GUIDANCE MANUAL (2003).

PROPOSED NON-NATIVE SPECIES MANAGEMENT

CONTRACTOR SHALL CUT NON-NATIVE SPECIES (E.G., BAMBOO) DURING STREAM RESTORATION ACTIVITIES. THE NON-NATIVE SPECIES WILL BE ALLOWED TO RE-SPROUT TO A MAXIMUM HEIGHT OF 2 FEET AND THEN SPRAYED WITH 4 TREATMENTS OF AN EPA-APPROVED AQUATIC HERBICIDE OVER 2 GROWING SEASONS.

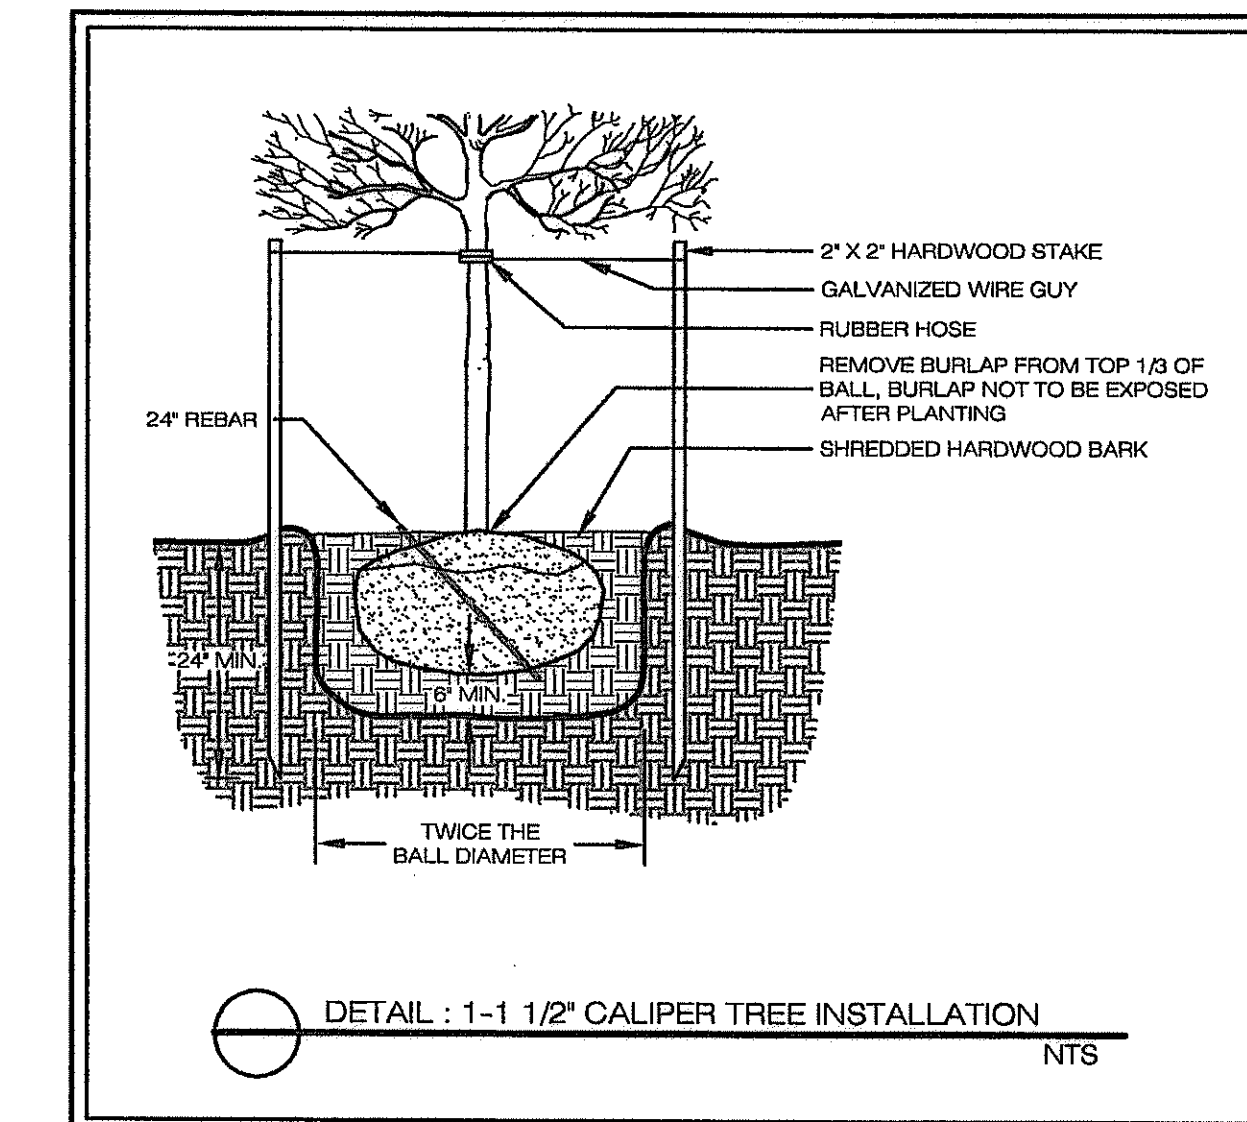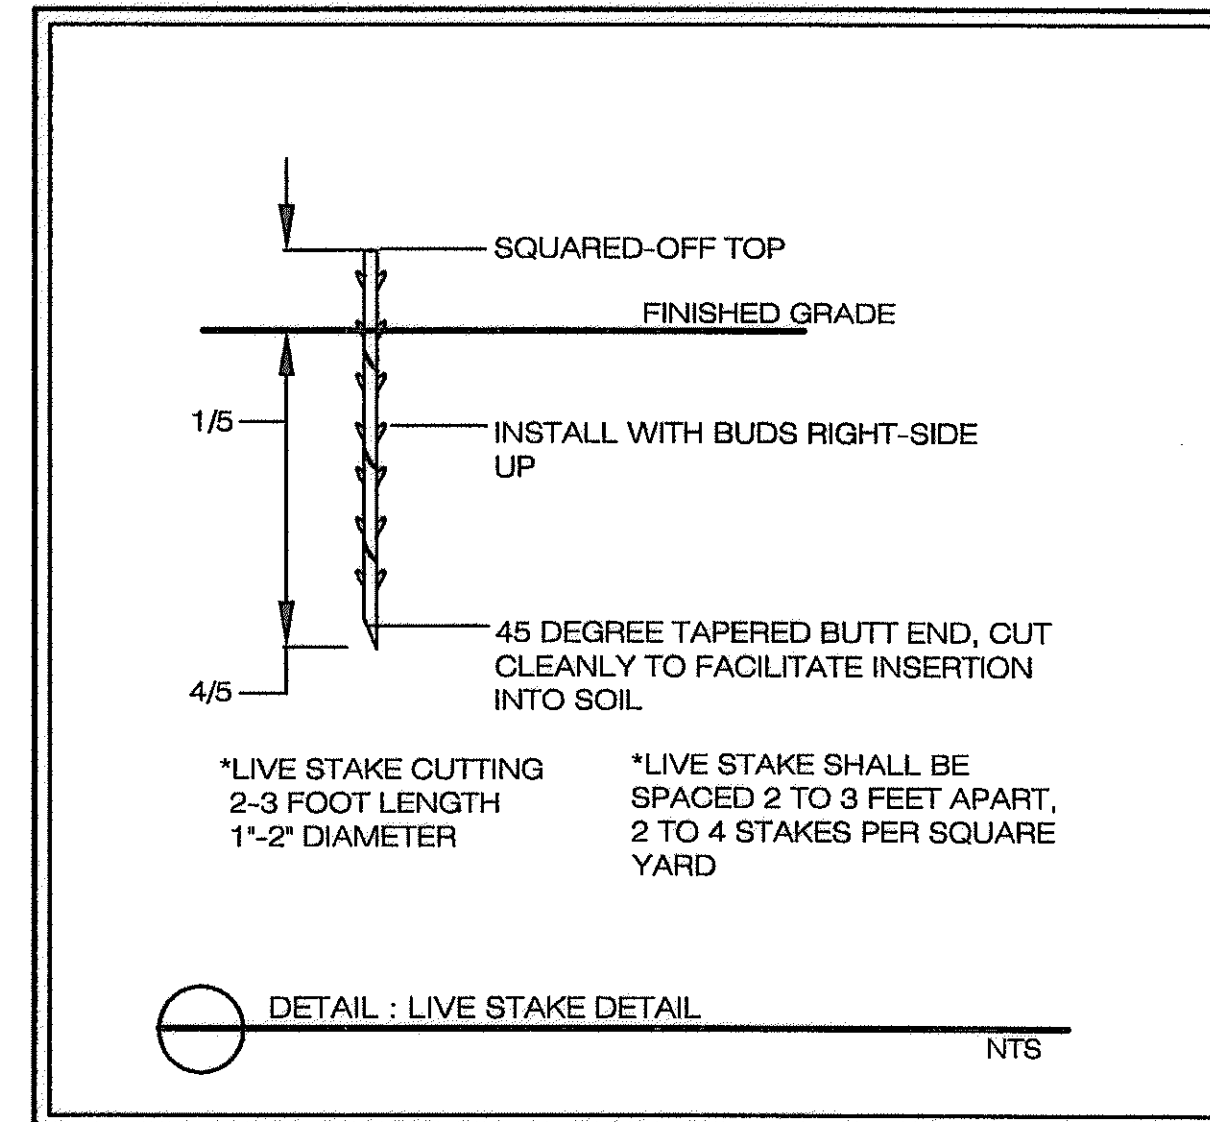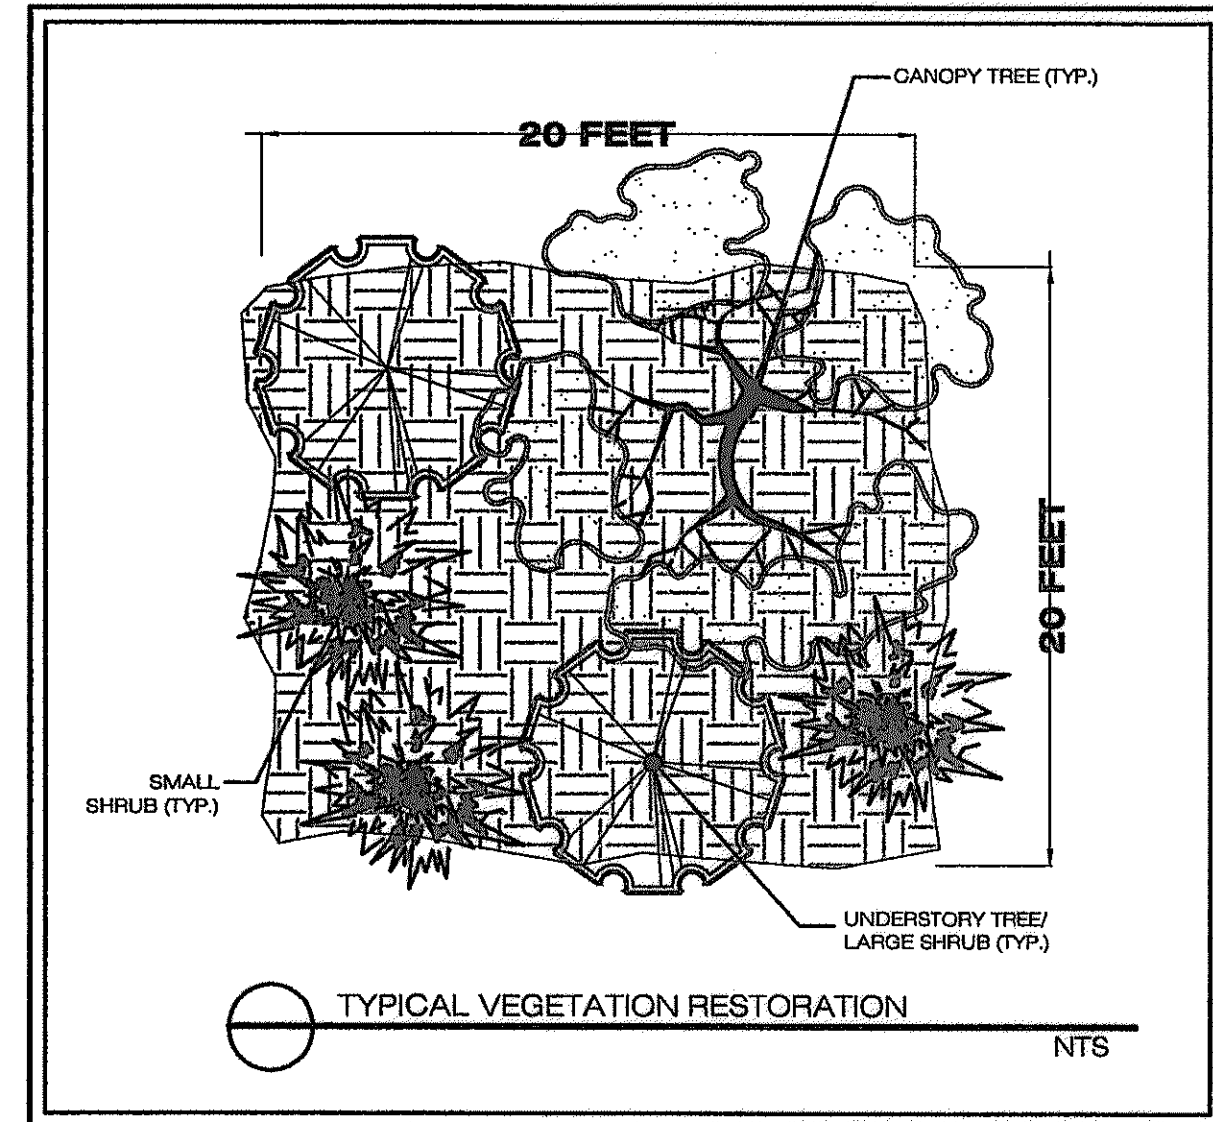

PROPOSED PLANTING NOTES


- ### SHRUB AND TREE INSTALLATION:
- ALL PLANT MATERIAL, UNLESS OTHERWISE SPECIFIED, SHALL BE UNIFORMLY BRANCHED AND HAVE A VIGOROUS ROOT SYSTEM. PLANT MATERIAL SHALL BE HEALTHY, VIGOROUS, AND FREE FROM DEFECTS, DECAY, DISEASES, INSECT PEST EGGS, AND ALL FORMS OF INFESTATION. ALL PLANT MATERIAL SHALL BE FRESH, FREE FROM TRANSPLANT SHOCK OR VISIBLE WILT. PLANTS DEEMED UNHEALTHY WILL BE REJECTED.
 - ALL PLANT MATERIAL SHALL MEET THE MINIMUM SPECIFICATIONS AND STANDARDS DESCRIBED IN THE CURRENT ISSUE OF "THE AMERICAN STANDARD FOR NURSERY STOCK," PUBLISHED BY THE AMERICAN ASSOCIATION OF NURSERYMEN, 1250 I STREET, N.W., SUITE 500, WASHINGTON, D.C. 20005.
 - ALL CONTAINERIZED STOCK SHALL HAVE BEEN PROPAGATED IN A CONTAINER LONG ENOUGH FOR THE ROOT SYSTEM TO HAVE DEVELOPED SUFFICIENTLY TO HOLD ITS SOIL. CONTAINERIZED STOCK WITH POORLY DEVELOPED ROOT SYSTEMS WILL NOT BE ACCEPTED.
 - PLANTS WILL BE PREPARED FOR SHIPMENT IN A MANNER THAT WILL NOT CAUSE DAMAGE TO THE BARK, BUDS, BRANCHES, STEMS, OR OVERALL SHAPE OF THE STOCK. CONTAINER-GROWN PLANTS SHALL BE TRANSPORTED IN THE CONTAINERS IN WHICH THEY HAVE BEEN GROWN.
 - PLANTS NOT INSTALLED ON THE DAY OF ARRIVAL ON SITE SHALL BE STORED AND PROTECTED BY THE CONTRACTOR. OUTSIDE STORAGE AREAS SHALL BE SHADED AND PROTECTED FROM THE WIND AND SUN. PLANTS STORED ON SITE SHALL BE PROTECTED FROM ANY DRYING AT ALL TIMES BY COVERING THE BALLS OR ROOTS WITH MOIST SAWDUST, WET BURLAP, WOODCHIPS, SHREDDED BARK, PEAT MOSS, OR OTHER SIMILAR MULCHING MATERIAL.
 - NO SUBSTITUTIONS IN SIZE OR VARIETY OF PLANT MATERIAL SHALL OCCUR WITHOUT THE PRIOR APPROVAL OF THE ENGINEER.
 - THE CONTRACTOR SHALL VERIFY ALL DIMENSIONS IN THE FIELD AND NOTIFY THE ENGINEER OF ANY VARIANCE FROM PLAN.
 - NO PLANTING SHALL OCCUR WHEN THE SOIL IS FROZEN.
 - THE FINAL LOCATION AND ORIENTATION OF ALL PLANT MATERIAL WILL BE SUBJECT TO THE APPROVAL OF THE ENGINEER. THE CONTRACTOR MAY BE RESPONSIBLE FOR REPLANTING ANY PLANT MATERIAL INSTALLED WITHOUT APPROVAL BY THE ENGINEER.
 - Holes for individual plantings shall be excavated to produce vertical sides and flat bottoms. All plantings holes shall have roughed, scarified sides and bottoms.
 - CONTAINERIZED PLANTS SHALL BE SET IN THE PLANTING PIT AT THE PROPER DEPTH ON TAMPED SOIL. SOIL REMOVED FROM THE PLANTING PIT AND AMENDED AS PER SPECIFICATIONS SHALL THEN BE FILLED AROUND THE ROOTS AND TAMPED.
 - THE CONTRACTOR SHALL RESTORE DISTURBED AREAS TO INDICATED FINAL GRADES IF DISTURBED BY THE INSTALLATION OF SHRUBS AND TREES.
 - DURING PLANTING, THE CONTRACTOR SHALL WATER EACH CONTAINERIZED PLANT INSTALLED WITH A MINIMUM OF 1 GALLON OF WATER, UNLESS OTHERWISE DIRECTED BY THE ENGINEER DUE TO EXISTING SITE CONDITIONS.

PLANTING SEQUENCE:

- Holes for individual plantings shall be excavated to produce vertical sides and flat bottoms. All planting holes shall have roughed, scarified sides and bottoms.
- APPLY ONE (1) TEN GRAM AGRIFORM FOREST STARTER TABLET OR EQUIVALENT PRODUCT TO EACH PLANT AS PER MANUFACTURERS DIRECTIONS ON LABEL AT TIME OF PLANTING.
- CONTAINERIZED PLANTS SHALL BE SET IN THE PLANTING PIT AT THE PROPER DEPTH ON TAMPED SOIL. SOIL REMOVED FROM THE PLANTING PIT AND AMENDED AS PER SPECIFICATIONS SHALL THEN BE FILLED AROUND THE ROOTS AND TAMPED.
- THE CONTRACTOR SHALL RESTORE DISTURBED AREAS TO INDICATED FINAL GRADES IF DISTURBED BY THE INSTALLATION OF SHRUBS AND TREES.

PROJECT MAINTENANCE AND WARRANTY:

- CONTRACTOR SHALL MAINTAIN INSTALLED SHRUBS AND TREES WITHIN THE PROJECT LIMITS UNTIL FINAL ACCEPTANCE OF THE PROJECT BY THE ENGINEER.
- FINAL PAYMENT TO THE CONTRACTOR WILL BE AUTHORIZED AFTER A PERIOD OF ONE (1) YEAR IF A MINIMUM OF 80% SURVIVAL OF THE PLANTED MATERIAL HAS BEEN REACHED WITHIN THE PROJECT LIMITS AS SHOWN ON THIS SHEET.

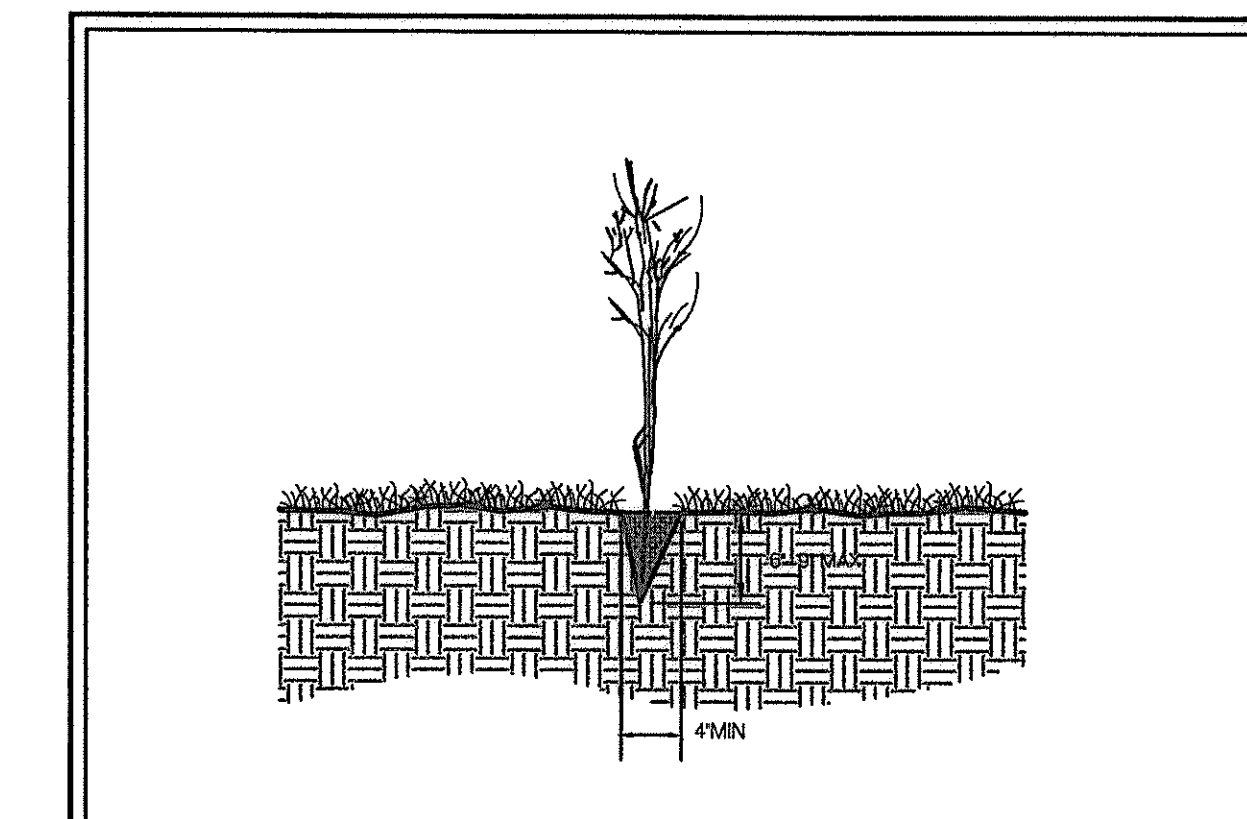

DETAIL : TUBELILING INSTALLATION

- NOTES:
- BARE ROOT PLANTING HOLE SHALL BE OF SUFFICIENT SIZE AS NOT TO CRAMP THE ROOTS.
 - ONE AGRIFORM FERTILIZER TABLET SHALL BE PLACED AT THE BOTTOM OF EACH HOLE.
 - PLANTING HOLE SHALL BE TAMPED WITH FOOT TO SECURE BARE ROOT PLANT MATERIAL IN SOIL.
 - ROOTS TO BE PLACED IN A MINIMUM OF 6" OF SOIL.

COMMONWEALTH OF VIRGINIA
 GEORGE T. HANCOCK
 Lic. No. 37017
 PROFESSIONAL ENGINEER

REVISIONS:	DATE:
05/20/06 REVISED BUFFER RESTORATION	
10/18/07 REVISED BUFFER RESTORATION	
04/15/07 REVISED BUFFER RESTORATION	
10/18/07 REVISED BUFFER RESTORATION	
11/06/07 PER 11/06/07 CITY COMMENT	
01/16/08 PER CITY COMMENT	

DRAWN BY: EBG/AMM
 DESIGNED BY: TW/CEB/ML
 DATE: 12/27/05
 CHECKED BY: TW/CJTH
 SHEET: 11
 JOB#: 2256

APPROVED
 SPECIAL USE PERMIT NO. 2007-008
 DEPARTMENT OF PLANNING & ZONING
 DATE: 2/1/08
 DIRECTOR: [Signature]
 DEPARTMENT OF TRANSPORTATION & INFRASTRUCTURE SERVICES
 SITE PLAN NO. 2007-0018
 DATE: 2/1/08
 CHAIRMAN, PLANNING COMMISSION: [Signature]
 DATE: 2/1/08
 DATE RECORDED:
 INSTRUMENT NO. DEED BOOK NO. PAGE NO.

V:\2200s\2256 - TaftStream Restoration\Construction Plans 10-10-07.dwg

GENERAL NOTES

- THE PROPERTY DELINEATED HEREON IS BY-RIGHT AND IS LOCATED ON ALEXANDRIA CADASTRAL MAP: 50.04 (7) PARCEL 27 AND 60.02 (2) PARCELS 1, 7, 14-18, AND 20-24.
- THE TOPOGRAPHIC INFORMATION IS BASED UPON THE RESULT OF A FIELD SURVEY BY THIS FIRM. CONTOUR INTERVAL IS TWO FEET.
- A RESOURCE PROTECTION AREA (RPA) IS LOCATED ON THE SUBJECT PROPERTY. THE SUBJECT PROPERTY IS LOCATED IN A RESOURCE MANAGEMENT AREA.
- A PRELIMINARY GEOTECHNICAL REPORT HAS BEEN PREPARED FOR THIS APPLICATION. A FINAL REPORT WILL BE SUBMITTED WITH THE PRELIMINARY PLAN. NO MARINE CLAYS WERE DISCOVERED ON THE SUBJECT PROPERTY. ONLY TRACES OF CLAY. A COPY OF THIS REPORT WAS PROVIDED FOR THE PREVIOUS SUBMISSION. A FULL GEOTECHNICAL REPORT WITH CONSTRUCTION SPECIFICATION SHALL BE PROVIDED WITH THE PRELIMINARY PLAN.
- ALL EXISTING BUILDINGS TO BE REMOVED UNLESS OTHERWISE NOTED.
- NO HAZARDOUS OR TOXIC SUBSTANCES HAVE BEEN OBSERVED ON THE SUBJECT PROPERTY.
- THE CITY SHALL PROVIDE SOLID WASTE DISPOSAL SERVICES TO THE SUBJECT PROPERTY. THE APPLICANT WILL PROVIDE ACCEPTABLE WASTE ENCLOSURES IN ACCORDANCE WITH ALL APPLICABLE CITY ORDINANCES.
- THE PROPOSED STORM WATER MANAGEMENT FACILITIES SHALL BE MAINTAINED BY THE HOMEOWNERS. A SEPARATE MAINTENANCE AGREEMENT SHALL BE REQUIRED PRIOR TO ISSUANCE OF CONSTRUCTION PERMIT.
- THE APPLICANT WILL CONTRIBUTE MONEY TO THE CITY'S AFFORDABLE HOUSING PROGRAM UPON APPROVAL OF THE PRELIMINARY PLAN.
- THE PROPOSED DEVELOPMENT WILL NOT INCREASE THE NUMBER OF TRIPS GENERATED PER DAY; THEREFORE NO TRANSPORTATION IMPACT STUDIES OR TRANSPORTATION MANAGEMENT PLANS ARE REQUIRED.
- A CERTIFICATE OF OCCUPANCY FOR EACH UNIT WILL BE OBTAINED PRIOR TO OCCUPANCY OF THE STRUCTURE IN ACCORDANCE WITH USBC 119.1.
- A WALL LOCATION PLAT PREPARED BY A LAND SURVEYOR WILL BE SUBMITTED TO THE CODE ENFORCEMENT OFFICE PRIOR TO REQUESTING ANY FRAMING INSPECTIONS.
- NO OFFSITE EASEMENTS OR PERMISSION IS ANTICIPATED TO BE REQUIRED FROM ADJACENT PROPERTY OWNERS IN ORDER TO COMPLETE THE PROPOSED CONSTRUCTION. IN CONJUNCTION WITH THE FINAL SITE PLAN, THE APPLICANT WILL DEMONSTRATE CONSTRUCTION TECHNIQUES UTILIZED TO KEEP CONSTRUCTION SOLELY ON THE SUBJECT PROPERTY.
- CONSTRUCTION PERMITS WILL BE OBTAINED FOR THIS PROJECT. ALL CONSTRUCTION WILL COMPLY WITH THE CURRENT EDITION OF THE UNIFORM STATEWIDE BUILDING CODE (USBC) & INTERNATIONAL RESIDENTIAL CODE (IRC).
- A RODENT ABATEMENT PLAN WILL BE SUBMITTED TO CODE ENFORCEMENT PRIOR TO THE ISSUANCE OF A DEMOLITION PERMIT OR LAND DISTURBANCE PERMIT.
- ALL EXTERIOR WALLS WITHIN 5 FEET FROM AN INTERIOR PROPERTY LINE SHALL HAVE A FIRE RESISTANCE RATING OF 1 HOUR, FROM BOTH SIDES, WITH NO OPENINGS PERMITTED WITHIN THE WALL. AS AN ALTERNATIVE, A 2 HOUR FIRE WALL MAY BE PROVIDED.
- ROOF DRAINAGE SYSTEMS WILL BE INSTALLED SO AS NOT TO IMPACT UPON OR CAUSE EROSION/DAMAGE TO ADJACENT PROPERTIES.
- CALL ALEXANDRIA ARCHAEOLOGY (703-838-4399) IMMEDIATELY IF ANY BURIED STRUCTURAL REMAINS (WALL FOUNDATIONS, WELLS, PRIVIES, CISTERNS, ETC.) OR CONCENTRATIONS OF ARTIFACTS ARE DISCOVERED DURING DEVELOPMENT. WORK MUST CEASE IN THE AREA OF THE DISCOVERY UNTIL A CITY ARCHAEOLOGIST COMES TO THE SITE AND RECORDS THE FINDINGS. THE APPLICANT HAS COMPLETED A PHASE I ARCHEOLOGICAL SURVEY AND NO SIGNIFICANT ARTIFACTS WERE FOUND.
- HVAC UNITS SHALL BE SCREENED WITH PLANTING MATERIALS. THE HVAC UNIT MAY ENCRASH INTO THE MINIMUM REQUIRED YARD IN ACCORDANCE WITH Z.O. SECTION 7-202(B)5.
- THE APPLICANT WILL SUBMIT ALL REQUESTS FOR DRIVEWAY APRONS TO THE DEPARTMENT OF TRANSPORTATION AND ENVIRONMENTAL SERVICES.
- THIS APPLICATION PROPOSES THE RESUBDIVISION OF LOTS 14-18 AND 21-24.
- EXISTING IMPERVIOUS FEATURES/STRUCTURES SHALL BE REMOVED FROM THE RPA WITH MINIMAL DISTURBANCE.
- THE APPLICANT WILL COORDINATE WITH VEPCO REGARDING THE PROPOSED CONSTRUCTION WITHIN THE EXISTING VEPCO EASEMENT. THE APPLICANT WILL PROVIDE DOCUMENTATION OF VEPCO'S APPROVAL AS PART OF THE FINAL DEVELOPMENT PLAN.
- PORTIONS OF THE SUBJECT PROPERTY WERE PREPARED WITHOUT THE BENEFIT OF A TITLE REPORT, THEREFORE ALL ENCUMBRANCES TO THE PROPERTY MAY NOT BE SHOWN.
- EROSION & SEDIMENT CONTROL SHALL BE INSTALLED PRIOR TO ANY CLEARING, GRADING OR CONSTRUCTION AS PER THE REQUIREMENTS OF THE STATE OF VIRGINIA AND THE CITY OF ALEXANDRIA.
- THE SITE SHALL BE SERVED BY PUBLIC WATER AND SEWER. THE EXISTING LATERALS MAY BE USED FOR THE PROPOSED DWELLINGS IF GRAVITY SERVICE IS PROVIDED. THE LOCATION AND ELEVATION SHALL BE CONFIRMED BY THE CONTRACTOR.
- DEVELOPMENT OF THIS PROJECT SHALL COMMENCE AT SUCH TIME AS APPROPRIATE APPROVALS HAVE BEEN OBTAINED AND SUBJECT TO THE DISCRETION OF THE OWNER/DEVELOPER.
- ALL PROPOSED UTILITIES SHALL BE UNDERGROUND. ALL UTILITY LOCATIONS ARE TO BE VERIFIED PRIOR TO CONSTRUCTION TO AVOID POTENTIAL CONFLICTS. THE CONTRACTOR WILL CONTACT THE ENGINEER OF RECORD AT 703-631-8387 IF ANY CONFLICTS ARISE.
- THE SUBJECT PROPERTY IS LOCATED WITHIN THE STRAWBERRY RUN WATERSHED.
- ALL PROPOSED DRIVEWAYS WILL CONTAIN CONCRETE RIBBON STRIPS AND PEA GRAVEL TO REDUCE IMPERVIOUS AREA.

CONSTRUCTION NOTES

- THE EXISTING UNDERGROUND UTILITIES SHOWN HEREON ARE BASED UPON AVAILABLE INFORMATION. THE CONTRACTOR SHALL BE RESPONSIBLE FOR DETERMINING THE EXACT LOCATION OF ALL UTILITIES BEFORE COMMENCING WORK AND FOR ANY DAMAGES WHICH MAY OCCUR BY HIS FAILURE TO LOCATE OR PRESERVE THESE UNDERGROUND UTILITIES. IF DURING CONSTRUCTION OPERATIONS THE CONTRACTOR SHOULD ENCOUNTER UTILITIES OTHER THAN IN THOSE SHOWN ON THE PLANS, HE SHALL IMMEDIATELY NOTIFY THE ENGINEER AND TAKE NECESSARY AND PROPER STEPS TO PROTECT THE FACILITY AND ASSURE THE CONTINUANCE OF SERVICE.
- THE CONTRACTOR SHALL DIG TEST PITS AS REQUIRED FOLLOWING NOTIFICATION AND MARKING OF ALL EXISTING UTILITIES TO VERIFY THE LOCATION AND DEPTH OF EXISTING UTILITIES. TEST HOLES TO BE PERFORMED AT LEAST 30 DAYS PRIOR TO START OF CONSTRUCTION. ANY DISCREPANCIES ARE TO BE REPORTED IMMEDIATELY TO THE OWNER AND ENGINEER. REDESIGN AND APPROVAL BY REVIEWING AGENCIES SHALL BE OBTAINED IF REQUIRED.
- THE CONTRACTOR SHALL BE RESPONSIBLE FOR NOTIFYING THE OWNER AND THE ENGINEER OF ANY CHANGES OR CONDITIONS ATTACHED TO PERMITS OBTAINED FROM ANY AUTHORITY ISSUING PERMITS.
- THE CONTRACTOR SHALL VISIT THE SITE AND SHALL VERIFY EXISTING CONDITIONS PRIOR TO STARTING CONSTRUCTION.
- THE CONTRACTOR SHALL CLEAR THE SITE OF ALL TREES, BUILDINGS, FOUNDATIONS, ETC. WITHIN THE LIMITS OF CONSTRUCTION UNLESS OTHERWISE SPECIFIED, AND SHALL BE RESPONSIBLE FOR CAUSING EXISTING UTILITIES TO BE DISCONNECTED.
- THE DEVELOPER SHALL PROVIDE OVER-LOT GRADING TO PROVIDE POSITIVE DRAINAGE AND PRECLUDE PONDING OF WATER.
- ALL AREAS, ON OR OFF-SITE, WHICH ARE DISTURBED BY THIS CONSTRUCTION AND WHICH ARE NOT PAVED OR BUILT UPON, SHALL BE ADEQUATELY STABILIZED TO CONTROL EROSION AND SEDIMENTATION. THE MINIMUM ACCEPTABLE STABILIZATION SHALL CONSIST OF PERMANENT GRASS, SEED MIXTURE TO BE AS RECOMMENDED BY THE COUNTY AGENT. ALL SLOPES 3:1 AND GREATER SHALL BE SODDED AND PEGGED OR OTHERWISE STABILIZED IN A MANNER APPROVED BY THE CITY OF ALEXANDRIA.
- EXISTING WELLS SHALL BE PERMANENTLY ABANDONED IN ACCORDANCE WITH VIRGINIA STATE WATER CONTROL BOARD REQUIREMENTS.
- ALL OVER HEAD POLE LINES SHALL BE RELOCATED AS REQUIRED BY THE OWNING UTILITY COMPANIES. THE CONTRACTOR SHALL BE RESPONSIBLE FOR MAKING ALL ARRANGEMENTS AND COORDINATING ALL WORK REQUIRED FOR THE NECESSARY RELOCATIONS.
- PRIOR TO BEGINNING CONSTRUCTION, CONTRACTOR SHALL VERIFY FROM THE ARCHITECTURAL DRAWINGS ALL DIMENSION, DETAILS, AND TREATMENTS FOR THE PROPOSED BUILDINGS, WALKWAYS, AND OTHER PROPOSED CONSTRUCTION WHERE INDICATED ON THE PLANS.
- THE CONTRACTOR IS TO VERIFY INVERT, SIZE AND LOCATION OF BUILDING UTILITY CONNECTIONS WITH THE MECHANICAL PLANS PRIOR TO PLACEMENT OF UNDERGROUND UTILITIES.
- EXISTING BUILDINGS, FENCES AND OTHER EXISTING PHYSICAL FEATURES ARE TO BE REMOVED AS REQUIRED BY THE CONTRACTOR.
- EXISTING CONSTRUCTION SHALL BE REMOVED TO NEAREST JOINT. NEW CONSTRUCTION SHALL BE PROVIDED AS SHOWN AND ANY DAMAGED AREA SHALL BE REPAIRED TO MATCH CONDITIONS EXISTING PRIOR TO CONSTRUCTION.
- DAMAGE TO ANY EXISTING ENTRANCES, CURB AND GUTTER, PAVEMENT OR OTHER EXISTING STRUCTURES NOT PROPOSED TO BE DISTURBED WITH THIS DEVELOPMENT, WILL BE THE RESPONSIBILITY OF THE CONTRACTOR AND MUST BE REPAIRED TO THE SATISFACTION OF THE VIRGINIA DEPARTMENT OF TRANSPORTATION AND ANY ADJOINING OWNERS THAT MAY BE AFFECTED.
- THE CONTRACTOR SHALL BE RESPONSIBLE FOR MAKING A SMOOTH TRANSITION TO EXISTING CURB.
- ALL PRIVATE BUILDING CONNECTIONS ARE TO BE INSTALLED IN ACCORDANCE WITH THE CURRENT PLUMBING CODE.
- TOPS OF EXISTING STRUCTURES WHICH REMAIN IN USE ARE TO BE ADJUSTED IN ACCORDANCE WITH THE GRADING PLAN. ALL PROPOSED STRUCTURE TOP ELEVATIONS ARE TO BE VERIFIED BY THE CONTRACTOR WITH THE SITE GRADING PLANS. IN CASE OF CONFLICT, THE GRADING PLAN SHALL SUPERSEDE PROFILE ELEVATIONS. MINOR ADJUSTMENTS TO MEET FINISHED GRADE ELEVATIONS MAY BE REQUIRED.
- THE DESIGN, CONSTRUCTION, FIELD PRACTICES AND METHODS SHALL CONFORM TO THE REQUIREMENTS SET FORTH BY THE CITY OF ALEXANDRIA AND ITS CURRENT ZONING ORDINANCE AND CONSTRUCTION STANDARDS MANUAL. FAILURE TO COMPLY WITH THE CODE, APPLICABLE MANUALS, PROVISIONS OF THE CONSTRUCTION AND ESCROW AGREEMENTS OR THE PERMITS SHALL BE DEEMED.
- THE APPROVAL OF THESE PLANS SHALL IN NO WAY RELIEVE THE OWNER/DEVELOPER OR HIS AGENT OF ANY LEGAL RESPONSIBILITIES WHICH MAY BE REQUIRED BY THE CODE OF VIRGINIA OR ANY ORDINANCE ENACTED BY THE CITY OF ALEXANDRIA.
- CONSTRUCTION STAKEOUT SHALL BE UNDER THE DIRECT SUPERVISION OF A LICENSED LAND SURVEYOR IN THE COMMONWEALTH OF VIRGINIA.
- NO EVIDENCE OF GRAVES OR BURIAL SITES HAS BEEN FOUND ON THIS PROPERTY.

- THE CONTRACTOR IS REFERRED TO STRUCTURAL, GEOTECHNICAL, MECHANICAL AND ARCHITECTURAL PLANS FOR FOUNDATION TREATMENT INCLUDING, BUT NOT LIMITED TO, SHEETING AND SHORING FOR BUILDING EXCAVATION, WATERPROOFING FOR FILL AGAINST BUILDINGS AND LOCATION OF MECHANICAL EQUIPMENT AND CONNECTIONS AT THE FACES OF BUILDINGS.
- SMOOTH GRADE SHALL BE MAINTAINED FROM THE CENTERLINE OF EXISTING ROAD TO THE PROPOSED ENTRANCE AND/OR CURB & GUTTER TO PRECLUDE THE FORMING OF FALSE GUTTER AND/OR THE PONDING OF WATER ON THE ROADWAY.
- PROPOSED PAVEMENT SECTION DEPTH(S) ARE BASED ON A CBR VALUE OF 10. LABORATORY TESTS OF SUBGRADE SOIL SHALL BE PERFORMED FOR ACTUAL DETERMINATION OF REQUIRED SUBGRADE THICKNESS PRIOR TO PAVING. IN THE CASE OF PAVEMENT PATCHES, PAVEMENT SECTION MUST MEET OR EXCEED EXISTING SECTION.
- EMERGENCY VEHICLE EASEMENTS AND HANDICAPPED PARKING SPACES TO BE MARKED BY CITY OF ALEXANDRIA STANDARD SIGNAGE AND ADA REQUIREMENTS.
- ALL STRIPING TO MEET MUTCD STANDARDS.
- ALL EROSION CONTROLS SHALL CONFORM TO THE VIRGINIA EROSION AND SEDIMENT CONTROL HANDBOOK (THIRD ADDITION 1992) AND MUST BE SUBMITTED AND APPROVED BY T&ES.
- ALL EMERGENCY VEHICLE EASEMENTS MUST BE DESIGNED AND CONSTRUCTED IN ACCORDANCE WITH CITY STANDARDS (CSAP-1A).
- ALL EARTHWORK OPERATIONS ARE TO BE PERFORMED UNDER THE FULL TIME, ON-SITE SUPERVISION OF A REGISTERED GEOTECHNICAL ENGINEER WITH GEOTECHNICAL TESTING IN ACCORDANCE WITH CONSTRUCTION SPECIFICATIONS AND SOILS REPORT REQUIREMENTS.
- SOLID WASTE SHALL BE DELIVERED TO WASTE TO ENERGY FACILITY.

NOTES

THE CITY OF ALEXANDRIA DEPARTMENT OF TRANSPORTATION AND ENVIRONMENTAL SERVICES, DIVISION OF ENVIRONMENTAL QUALITY, MUST BE NOTIFIED IF UNUSUAL OR UNANTICIPATED CONTAMINATION OR UNDERGROUND STORAGE TANKS, DRUMS AND CONTAINERS ARE ENCOUNTERED AT THE SITE. IF THERE IS ANY DOUBT ABOUT PUBLIC SAFETY OR A RELEASE TO THE ENVIRONMENT, THE ALEXANDRIA FIRE DEPARTMENT MUST BE CONTACTED IMMEDIATELY BY CALLING 911. THE TANK OR CONTAINERS REMOVAL, ITS CONTENTS, ANY SOIL CONTAMINATION AND RELEASE TO THE ENVIRONMENT WILL BE HANDLED IN ACCORDANCE WITH FEDERAL, STATE, AND CITY REGULATIONS.

ALL WELLS TO BE DEMOLISHED ON THIS PROJECT, INCLUDING MONITORING WELLS, MUST BE CLOSED IN ACCORDANCE WITH STATE WELL REGULATION. CONTACT JOE FIANDER AND COORDINATE WITH THE ALEXANDRIA HEALTH DEPARTMENT AT 703-838-4400 EXT. 255.

ALL CONSTRUCTION ACTIVITIES MUST COMPLY WITH THE ALEXANDRIA NOISE CONTROL CODE TITLE 11, CHAPTER 6, WHICH PERMITS CONSTRUCTION ACTIVITIES TO OCCUR BETWEEN THE FOLLOWING HOURS:

MONDAY THROUGH FRIDAY FROM 7AM TO 6PM AND SATURDAYS FROM 9AM TO 6PM
NO CONSTRUCTION ACTIVITIES ARE PERMITTED ON SUNDAYS.
PILE DRIVING IS FURTHER RESTRICTED TO THE FOLLOWING HOURS:
MONDAY THROUGH FRIDAY FROM 9AM TO 6PM AND SATURDAYS FROM 10AM TO 4PM

BMP SIGN NOTES


THE BMP SIGN SHOWN BELOW WILL BE 12 X 18 INCHES.



GEOTECHNICAL NOTE

AS PER THE GEOTECHNICAL RECOMMENDATIONS PROVIDED BY TERRA ENGINEERING SERVICES, P.L.C. AND CERTIFIED BY TIMOTHY V. FARABAUGH, P.E., THE 2:1 CUT SLOPES PROPOSED IN THIS STREAM RESTORATION PLAN ARE ADEQUATE AND PROVIDE NO SLOPE STABILITY CONCERNS, PROVIDED THE STREAMBANKS ARE STABILIZED IN ACCORDANCE WITH THE STREAM RESTORATION PLAN.

WQIA/RPA EXCEPTION LETTERS

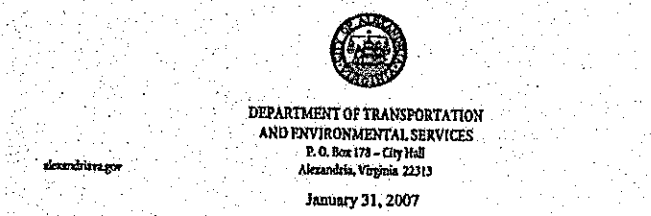

DEPARTMENT OF TRANSPORTATION AND ENVIRONMENTAL SERVICES
1500 COMMONWEALTH AVENUE
ALEXANDRIA, VIRGINIA 22304
January 31, 2007

Dear Mr. Hancock:
The applicant, Taft Avenue Properties, DSP 2004-0038, has requested an administrative approval for encroachment into the RPA under Section 13-107(F)(1), Article XIII, Environmental Management, which requires development within the Resource Protection Area (RPA). This section of the Zoning Ordinance specifies:
"The following encroachments, if approved by the Director of T&ES and provided that a water quality impact assessment is performed and accepted by the Director of T&ES as complete in accordance with Sec. 15-114:
(1) When the application of the buffer area would result in the loss of a habitable area as a lot or parcel recorded prior to October 1, 1995, encroachments into the buffer area may be approved by the Director of T&ES in accordance with the following criteria:
(a) Encroachments into the buffer area shall be the minimum necessary to achieve a reasonable habitable area for proposed structure and necessary utilities;
(b) Where practicable, a vegetated area that will maintain water quality protection, mitigate the effects of the buffer encroachment, and is equal in the area of encroachment into the buffer area shall be established elsewhere on the lot; and
(c) The encroachment may not extend into the seaward 50 feet of the buffer area."


In this case, the proposed encroachment complies with the RPA zone and is consistent with the City's Master Plan. Calculations of the proposed development show that 1.64 sq. ft. of impervious area will be constructed within the RPA, with a reduction in impervious area on each lot. Several landscaping features have been added and the resulting configuration in the minimum encroachment necessary to achieve reasonable habitable area on the principle structure and utilities. As required by the Zoning Ordinance, the applicant has provided a water quality impact assessment for review by T&ES. Significant mitigation is proposed. The encroachment into the RPA will be at the edge of the RPA boundary (not within the seaward 50 feet) and the shade currently existing in the rear of the lots that are close to the stream will be preserved, thus eliminating the need for new stream encroachments into the RPA. Finally, the proposed encroachment complies with stormwater management requirements, largely due to the provision of a stream restoration plan.

This request therefore meets the requirements for administrative approval for encroachment into the RPA as listed in Article XIII, Section 13-107(F)(1) of the Alexandria Zoning Ordinance.

Sincerely,
Richard J. Baker, P.E.

Richard J. Baker, P.E.
Director, Department of Transportation and Environmental Services

cc: Claudia Harshbarger-Kablik, Watershed Program Administrator

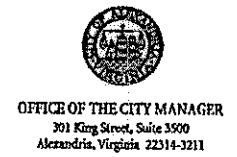

JAMES K. HARTMANN
City Manager
Alexandria, Virginia 22314-3011
703 838 4300
fax 703 838 4310

March 13, 2007

Kelly Atkinson
Land Design Consultants, Inc.
4911 Commerce Road, Suite 300
Manassas, Virginia 20108

Re: Letter of Permission for Stream Restoration in Fort Williams Park
Taft Avenue Project (DSP 2004-0038)

Dear Mr. Addison,

"Thank you for your letter dated February 16, 2007 regarding the Taft Avenue project and your request for a letter of permission to perform stream restoration activities for Strawberry Run in Fort Williams Park. As indicated in your letter, your client, Cabernet Homes, has proposed a stream restoration plan as part of the site plan for the Taft Avenue development that was approved at the Planning Commission on February 6, 2007. Considering the deteriorated state of this stream, the City agrees that the restoration will be of great benefit to the community. Therefore, the City grants you permission to perform work within the City-owned Fort Williams Park subject to the following conditions:



- All work shall be performed in compliance with approved Site Plan (DSP 2004-0038) conditions.
- The stream restoration plan shall be reviewed by the City as part of the Taft Avenue final site plan and work shall not begin in the stream and stream area until this plan has been approved and released.
- A document illustrating access to and across public lands and other ground disturbance shall be approved by RPA&CA, T&ES/DSD, and P&Z prior to commencement of work.
- RPA&CA staff (City Arborist and Landscape Architect) shall field verify access routes, and other limits of ground disturbance in coordination with T&ES/DSD and P&Z prior to commencement of work. The (10) calendar days notice is required to coordinate a field meeting.
- All areas affected by work shall be restored to conditions as depicted in the restoration and landscape plans to the satisfaction of the RPA&CA, T&ES/DSD, and P&Z.
- Per Condition of Approval #12, prior to any construction occurring in the stream and stream area, a warranty regarding the field work with the applicable civic associations to discuss details of the plan and the implementation.

If you have any questions regarding this letter, please contact Kaye Parker in the Planning and Zoning Department at (703) 838-4666 or kaye.parker@alexandriava.gov.

Sincerely,

James R. Hartmann

James R. Hartmann
City Manager
cc: Ignacia Ponce, City Attorney
Kirk Kinannon, Director, Recreation, Parks, and Cultural Activities
Rogay Hladky, Deputy Director, Park Operations and Capital Development, Recreation, Parks, and Cultural Activities
Rich Baker, Director, Transportation and Environmental Services
Bill Strubbe, Division Chief, Environmental Quality, Transportation and Environmental Services
Rich Dougherty, Acting Director, Planning and Zoning
Kaye Parker, Planner, Planning and Zoning

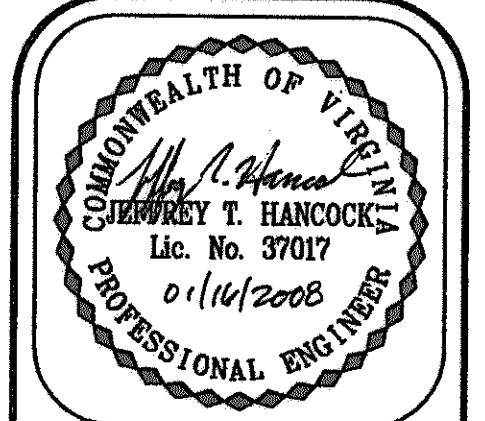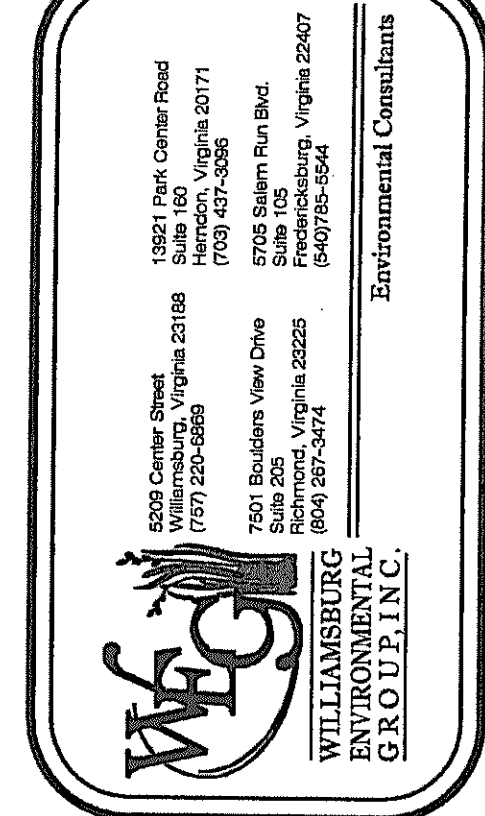

REVISIONS:	DATE:
608066	APPROVED STANDARD CITY OF ALEXANDRIA CONSTRUCTION
	NOTED
	10/11/07 PER REVIEW CITY ENGINEER/ETM/ETM
	01/11/07 PER CITY COMMENT

DRAWN BY: EBG/MAM
DESIGNED BY: TWG/BJM/L
DATE: 12/27/05
CHECKED BY: TWG/UTM

SHEET: 12
JOB#: 2256

APPROVED
SPECIAL USE PERMIT NO. 2007-0016
DEPARTMENT OF PLANNING & ZONING
James R. Hartmann 2-4-08
DIRECTOR
DEPARTMENT OF TRANSPORTATION & ENVIRONMENTAL SERVICES
SITE PLAN NO. 2007-0016
James R. Hartmann 2/1/08
DIRECTOR
CHAIRMAN, PLANNING COMMISSION
DATE RECORDED: 4/4/08
INSTRUMENT NO. DEED BOOK NO. PAGE NO.

APPENDIX B – STREAM RESTORATION AS-BUILT PLAN TAFT AVENUE PROPERTY



PROJECT NAME


TAFT AVENUE PROPERTY

AREA TABULATIONS

GENERAL NOTES

VICINITY MAP

SCALE: 1" = 250'

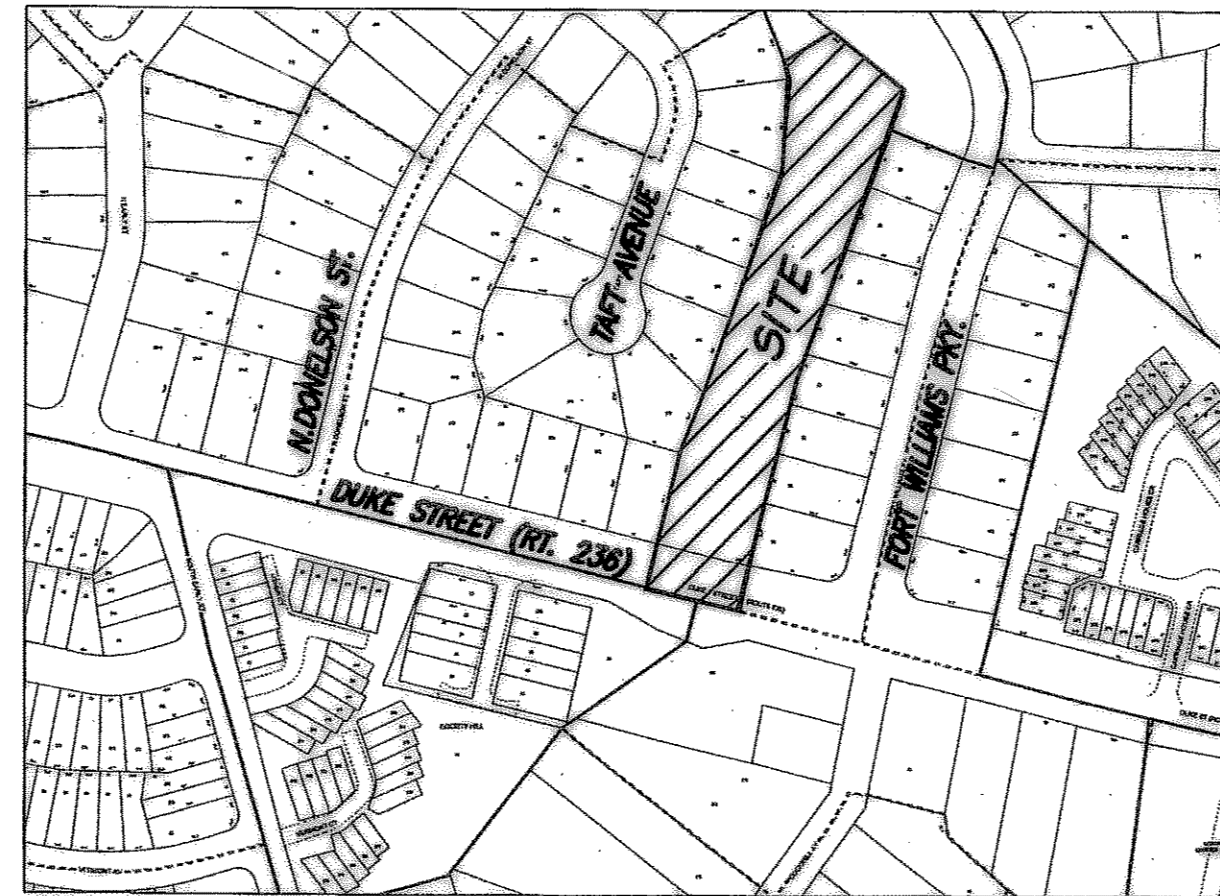

ZONING TABULATIONS

1. ZONE OF SITE: R-8 (BY-RIGHT)
2. USE: EXISTING: RESIDENTIAL (S.F.D)
PROPOSED: RESIDENTIAL (S.F.D)
3. LOT AREA: SEE SHEET 2A
MINIMUM LOT AREA: 8,000 SF
4. NUMBER OF DWELLING UNITS: 13
5. UNITS PER ACRE (DENSITY): 13 UNITS/2.70 = 4.81 D.U./AC
6. GROSS SQUARE FOOTAGE: SEE SHEET 2A.
7. NET SQUARE FOOTAGE: SEE SHEET 2A.
8. FLOOR AREA RATIO: SEE SHEET 2A (Z.O. SECTION 3-306(B))
9. OPEN SPACE: SEE SHEET 7
10. AVERAGE FINISHED GRADE: SEE SHEET 2A.
11. HEIGHT: SEE SHEET 2A.
MAX. ALLOWABLE HEIGHT = 35'
12. YARDS: SEE SHEET 2A.
13. FRONTAGE:
REQUIRED: 40' MIN. AT FRONT LINE
PROVIDED: 40' MIN. AT FRONT LINE
14. PARKING SPACES: 2 SPACES PER DWELLING UNIT
EXISTING: 26 (2 SP/UNIT, IN GARAGE)
PROPOSED: 26 (2 SP/UNIT, IN GARAGE)
15. LOADING SPACES: N/A
16. TRIP GENERATION (VPD):
EXISTING: 130
PROPOSED: 130
17. WATERSHED: STRAWBERRY RUN

ENVIRONMENTAL SITE ASSESSMENT

WETLANDS ARE BEING DISTURBED AND WETLAND PERMITS ARE REQUIRED FOR THIS DEVELOPMENT. THERE ARE NO KNOWN EX. UNDERGROUND STORAGE TANKS OR AREAS OF SOIL OR GROUNDWATER CONTAMINATION ON THE SITE.

PLANS SHEET KEY

EXISTING INTERMEDIATE CONTOUR		FLOW LINE	
EXISTING INDEX CONTOUR		FENCELINE	
PROPOSED CONTOUR		EXISTING UTILITY POLE	
EXISTING EDGE OF PAVEMENT		PROPOSED UTILITY POLE	
PROPOSED EDGE OF PAVEMENT		EXISTING WATERLINE W/ TEE	
EXISTING CURB AND GUTTER		PROPOSED WATERLINE W/ TEE	
PROPOSED CURB AND GUTTER		EXISTING FIRE HYDRANT	
TRANSITION FROM CG-6 TO CG-6R		PROPOSED FIRE HYDRANT	
EXISTING TELEPHONE LINE		EXISTING WATER VALVE	
PROPOSED TELEPHONE LINE		PROPOSED WATER VALVE	
EXISTING STORM SEWER		PROPOSED WATER METER	
PROPOSED STORM SEWER		EXISTING REDUCER	
EXISTING SANITARY SEWER		PROPOSED REDUCER	
PROPOSED SANITARY SEWER		STOP SIGN	
EXISTING ELECTRIC SERVICE		HANDICAP RAMP (1:12)	
PROPOSED ELECTRIC SERVICE		CRITICAL SLOPE	
EXISTING GAS LINE		VEHICLES PER DAY COUNT	
PROPOSED GAS LINE		PROPOSED BUILDING ENTRANCE	
PROPERTY LINE		EXISTING STREET LIGHT	
EASEMENT LINE		PROPOSED STREET LIGHT	
CENTERLINE		PROPOSED STREET NAME SIGN	
LIMITS OF CLEARING AND GRADING		PROPOSED SANITARY LATERAL CLEANOUT	
EXISTING SPOT ELEVATION		SANITARY MANHOLE IDENTIFIER	
PROPOSED SPOT ELEVATION		STORM DRAIN STRUCTURE IDENTIFIER	
EXISTING TREE DRIP LINE			
EXISTING TREE			
PROPOSED TREE			

SHEET INDEX

1. COVER SHEET
2. STREAM RESTORATION AS-BUILT
3. AS-BUILT CROSS SECTIONS - STREAM RESTORATION AREA #1
4. AS-BUILT CROSS SECTIONS - STREAM RESTORATION AREA #2

CERTIFIED LAND DISTURBER

JOHN K. RINGLE WILL HEREBY SERVE AS THE CERTIFIED LAND DISTURBER FOR THE ENCLOSED PROJECT.

TOTAL DISTURBED AREA = 3.48 AC

SIGNATURE DATE LICENSE NUMBER

DEVELOPER/OWNER

CALVERT HOMES, INC.
12656-C LAKE RIDGE DRIVE
LAKE RIDGE, VA 22192
PH NO.: (703) 643-5001

OWNER

TAFT STREET, LLC.
12656-C LAKE RIDGE DRIVE
LAKE RIDGE, VA 22192
PH NO. (703) 643-5001

OWNER

TAFT AVENUE, LLC.
12656-C LAKE RIDGE DRIVE
LAKE RIDGE, VA 22192
PH NO.: (703) 643-5001

ENGINEER

LAND DESIGN CONSULTANTS
9401 CENTREVILLE ROAD,
SUITE 300
MANASSAS, VA 20110
PH NO.: (703) 257-5600
CONTACT: KELLY ATKINSON/
JOSH MARSHALL, P.E.

ARCHITECT:

RDG GROUP
12792 HARBOR DRIVE,
LAKE RIDGE, VA 22192
PH NO.: (703) 490-0408

ARCHITECT:

GARY M. ZICKAFOOSE
5830 BETHEL ROAD
ALEXANDRIA, VA 22310
PH NO.: (703) 960-5245

STREAM RESTORATION AS-BUILT

TAFT AVENUE

PROPERTY

CITY OF ALEXANDRIA, VIRGINIA

COVER SHEET

SHEET NAME:

APPROVED

SPECIAL USE PERMIT NO. DEPARTMENT OF PLANNING & ZONING

DIRECTOR DATE DEPARTMENT OF TRANSPORTATION & ENVIRONMENTAL SERVICES SITE PLAN No. 2004-0038

DIRECTOR DATE

CHAIRMAN, PLANNING COMMISSION DATE


DATE RECORDED

INSTRUMENT NO. DEED BOOK NO. PAGE NO.

APPROVED ASBUILT


DEVELOPMENT SITE PLAN NO. 2007-00018
DEPARTMENT OF TRANSPORTATION & ENVIRONMENTAL SERVICES
DIRECTOR DATE
SPECIAL USE PERMIT

PROPOSED CONDITIONS

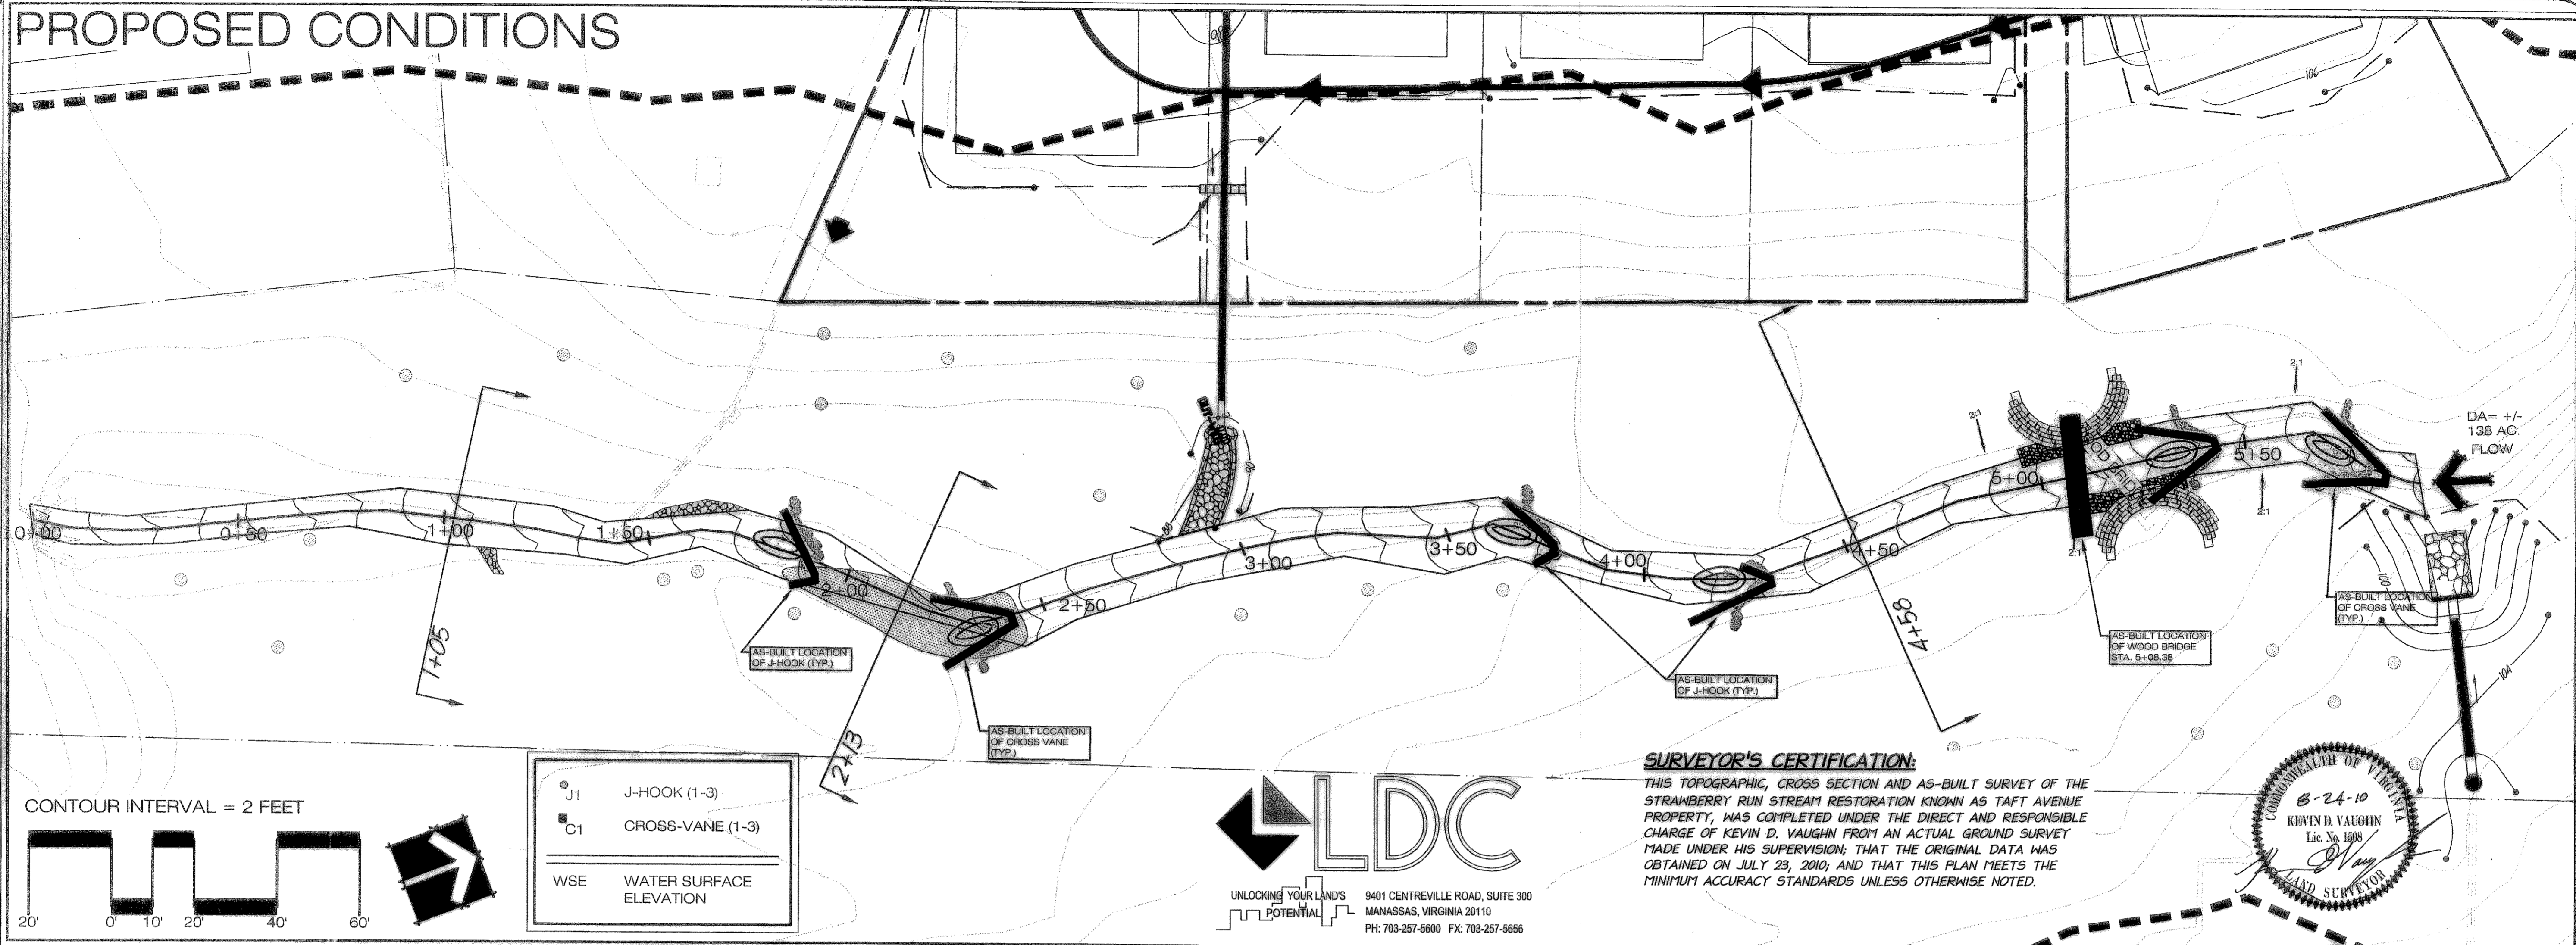


LDC
 UNLOCKING YOUR LANDS POTENTIAL
 9401 CENTREVILLE ROAD, SUITE 300
 MANASSAS, VIRGINIA 20110
 PH: 703-257-5600 FX: 703-257-5656

SURVEYOR'S CERTIFICATION:
 THIS TOPOGRAPHIC, CROSS SECTION AND AS-BUILT SURVEY OF THE STRAWBERRY RUN STREAM RESTORATION KNOWN AS TAFT AVENUE PROPERTY, WAS COMPLETED UNDER THE DIRECT AND RESPONSIBLE CHARGE OF KEVIN D. VAUGHN FROM AN ACTUAL GROUND SURVEY MADE UNDER HIS SUPERVISION; THAT THE ORIGINAL DATA WAS OBTAINED ON JULY 23, 2010; AND THAT THIS PLAN MEETS THE MINIMUM ACCURACY STANDARDS UNLESS OTHERWISE NOTED.

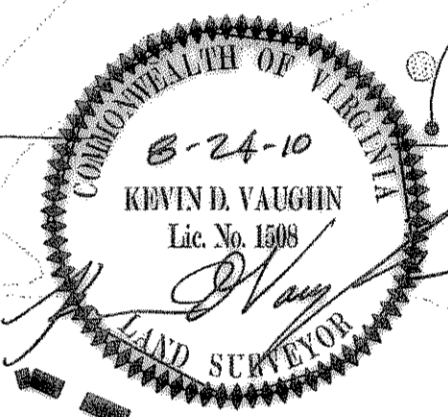

LEGEND:

[Symbol]	PROJECT LIMITS	[Symbol]	PROPOSED CROSS-VANE	[Symbol]	UN-SURVEYED CROSS-SECTION
[Symbol]	APPROXIMATE STREAM CHANNEL LIMITS	[Symbol]	PROPOSED J-HOOK	[Symbol]	SURVEYED CROSS-SECTION
[Symbol]	RESOURCE PROTECTION AREA LIMITS	[Symbol]	PROPOSED SCOUR POOL	[Symbol]	PROPOSED ROCK STABILIZATION
[Symbol]	EXISTING CONTOURS	[Symbol]	PROPOSED BUFFER RESTORATION AREA	[Symbol]	PROPOSED OUTLET PROTECTION
[Symbol]	EXISTING TREES (TO BE PROTECTED)	[Symbol]	PROPOSED BANKFULL BENCH AND BANK GRADING	[Symbol]	PROPOSED CHANNEL SHAPING
[Symbol]	EXISTING TREES (TO BE REMOVED)	[Symbol]	PROPOSED GRADING FOR STORMWATER OUTFALL (BY OTHERS)	[Symbol]	PROPOSED BRIDGE STABILIZATION

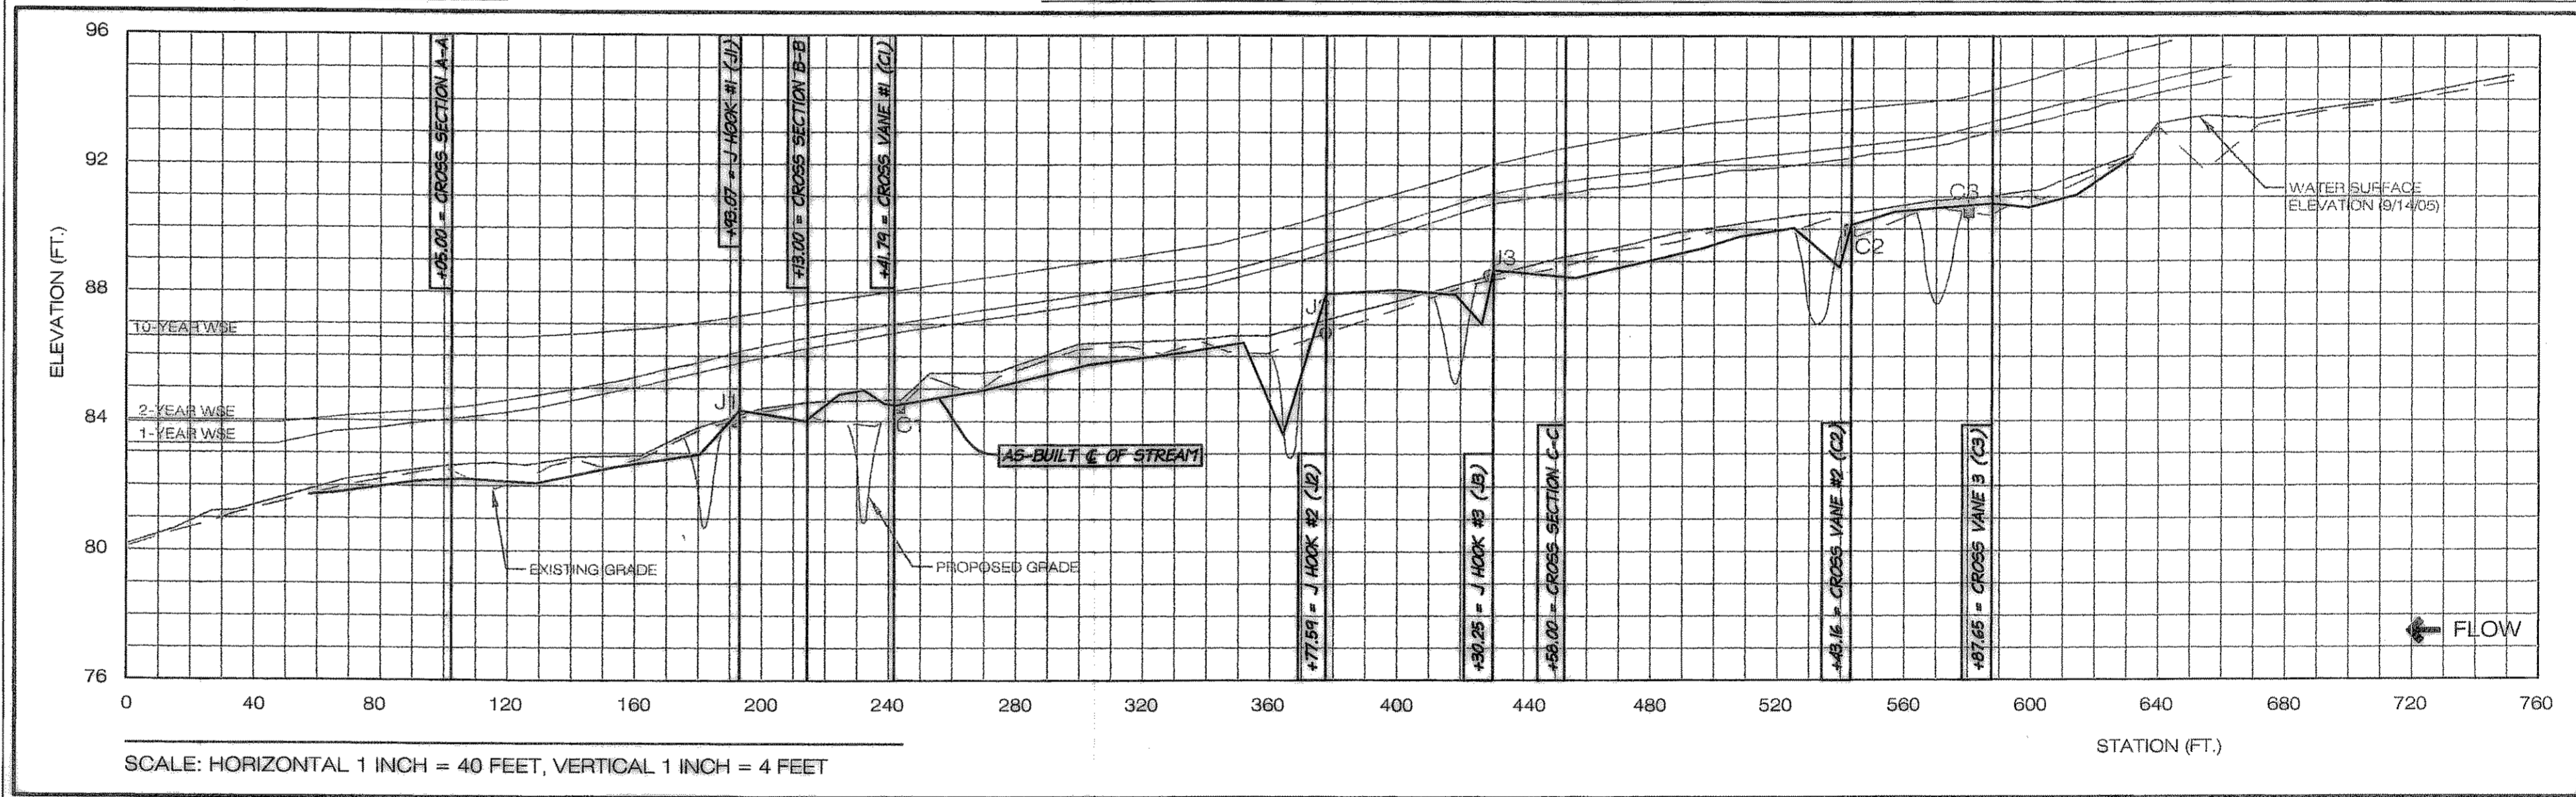

DSP 2007-00018
APPROVED ASBUILT
 DEVELOPMENT SITE PLAN NO. _____
 DEPARTMENT OF TRANSPORTATION & ENVIRONMENTAL SERVICES
 DIRECTOR: [Signature] DATE: 10/1/10
 SPECIAL USE PERMIT

PROPOSED DESIGN GUIDELINES

THE PROPOSED DESIGN SHALL MIMIC, TO THE CLOSEST EXTENT PRACTICABLE, THE 'C' CHANNEL PARAMETERS OUTLINED BY THE ROSGEN CLASSIFICATION METHOD. THE PARAMETERS INCLUDE ENTRENCHMENT RATIO, WIDTH/DEPTH RATIO, SINUOSITY, AND SLOPE. AN AVERAGE OF EXISTING CONDITIONS AND PROPOSED CONDITIONS IS PRESENTED BELOW.

	ENTRENCHMENT RATIO	WIDTH/DEPTH RATIO	SINUOSITY	SLOPE
"C" CHANNEL GUIDELINES	>2.2	>12	>1.2	<.02
EXISTING CONDITION	1.5 - >2.2	10.6*	1.03	.02
PROPOSED CONDITION	1.9 - >2.2	16.5*	1.03	.02

* WIDTH-DEPTH RATIO CALCULATED AS TOP WIDTH DIVIDED BY AVERAGE DEPTH


PROPOSED RESTORATION SUMMARY

THE PROPOSED RESTORATION WITHIN STRAWBERRY RUN COMBINES IN-STREAM STRUCTURES WITH CHANNEL SHAPING AND BANK STABILIZATION TECHNIQUES. EXISTING CONCRETE DEBRIS WILL BE REMOVED FROM THE STREAM BED AND BANKS IN ORDER TO RESTORE NATURAL FLOW DYNAMICS. IN-STREAM STRUCTURES, INCLUDING J-HOOKS, AND CROSS-VANES, SHALL PROVIDE GRADE CONTROL AND DIVERT EROSION FLOWS FROM OUTER BENDS. OUTLET PROTECTION AT THE PROPOSED 18' CMP WILL ATTENUATE STORMWATER FLOWS AND PREVENT FURTHER DEGRADATION OF THE DOWNSTREAM STREAM BANKS. ROCK-TOE PROTECTION WILL PROTECT THE CONFLUENCE OF THE CHANNEL AND AN EXISTING DRAINAGE SWALE, IN ADDITION TO STABILIZING HIGH STRESS AREAS. BANKFULL BENCHES SHALL PROVIDE SLOPE STABILIZATION IN EXISTING ERODED AREAS, WHERE PRACTICABLE, IN ADDITION TO ENHANCING CONNECTIVITY TO THE FLOODPLAIN. THE EXISTING WOOD FOOT BRIDGE WILL BE RETAINED AND ENHANCED WITH A PROPOSED CONCRETE FOUNDATION. PROPOSED ROCK STABILIZATION, ROCK-TOE PROTECTION, AND CEMENT GROUTED RIPRAP WILL PROTECT THE EXISTING VERTICAL BANKS NEAR THE BRIDGE DURING HIGH FLOW EVENTS.

THE RESTORATION PLAN ALSO INCORPORATES APPROXIMATELY 1.3 ACRES OF RIPARIAN CORRIDOR RESTORATION. NON-NATIVE VEGETATION (E.G., BAMBOO) SHALL BE MANAGED AND NATIVE VEGETATION SHALL BE USED TO RESTORE THE RIPARIAN BUFFER. IMPACTS TO EXISTING MATURE TREES SHALL BE AVOIDED AND MINIMIZED. TREES, SHRUBS, LIVE-STAKES, AND A HERBACEOUS SEED MIX SHALL PROVIDE AN EFFECTIVE ROOTING DEPTH TO STABILIZE THE GRADED BANKS.

WEG
 WILLIAMS ENVIRONMENTAL GROUP, INC.
 13021 Lee Road
 Manassas, Virginia 20108
 (703) 421-7000
 8700 Salem Run Blvd
 Manassas, Virginia 20107
 (703) 421-5544
 Environmental Professionals

STREAM RESTORATION AS-BUILT
 TAFT AVENUE PROPERTY
 CITY OF ALEXANDRIA, VIRGINIA

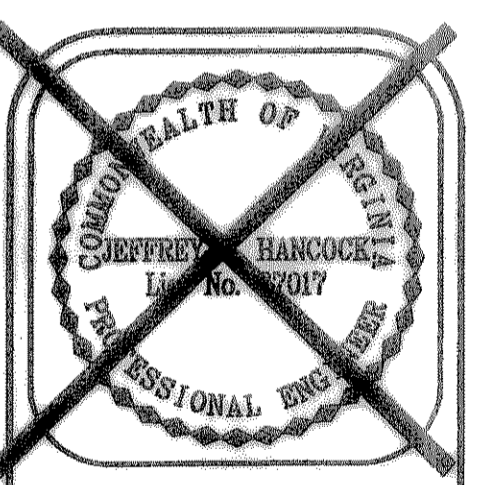

REVISIONS:

DATE	DESCRIPTION
08/24/10	ISSUED FOR PERMITS
08/24/10	REVISED FOR PERMITS
08/24/10	REVISED FOR PERMITS
DRAWN BY: EBGMMAM
 DESIGNED BY: TW0EBGANL
 DATE: 12/27/05
 CHECKED BY: TW0UTH
 SHEET: 2
 JOB#: 2250

APPROVED
 SPECIAL USE PERMIT NO. _____
 DEPARTMENT OF PLANNING & ZONING
 DIRECTOR: _____ DATE: _____
 DEPARTMENT OF TRANSPORTATION & ENVIRONMENTAL SERVICES
 SITE PLAN NO. 2007-0018
 DIRECTOR: _____ DATE: _____
 CHAIRMAN, PLANNING COMMISSION: _____ DATE: _____
 DATE RECORDED: _____
 INSTRUMENT NO. DEED BOOK NO. PAGE NO.